


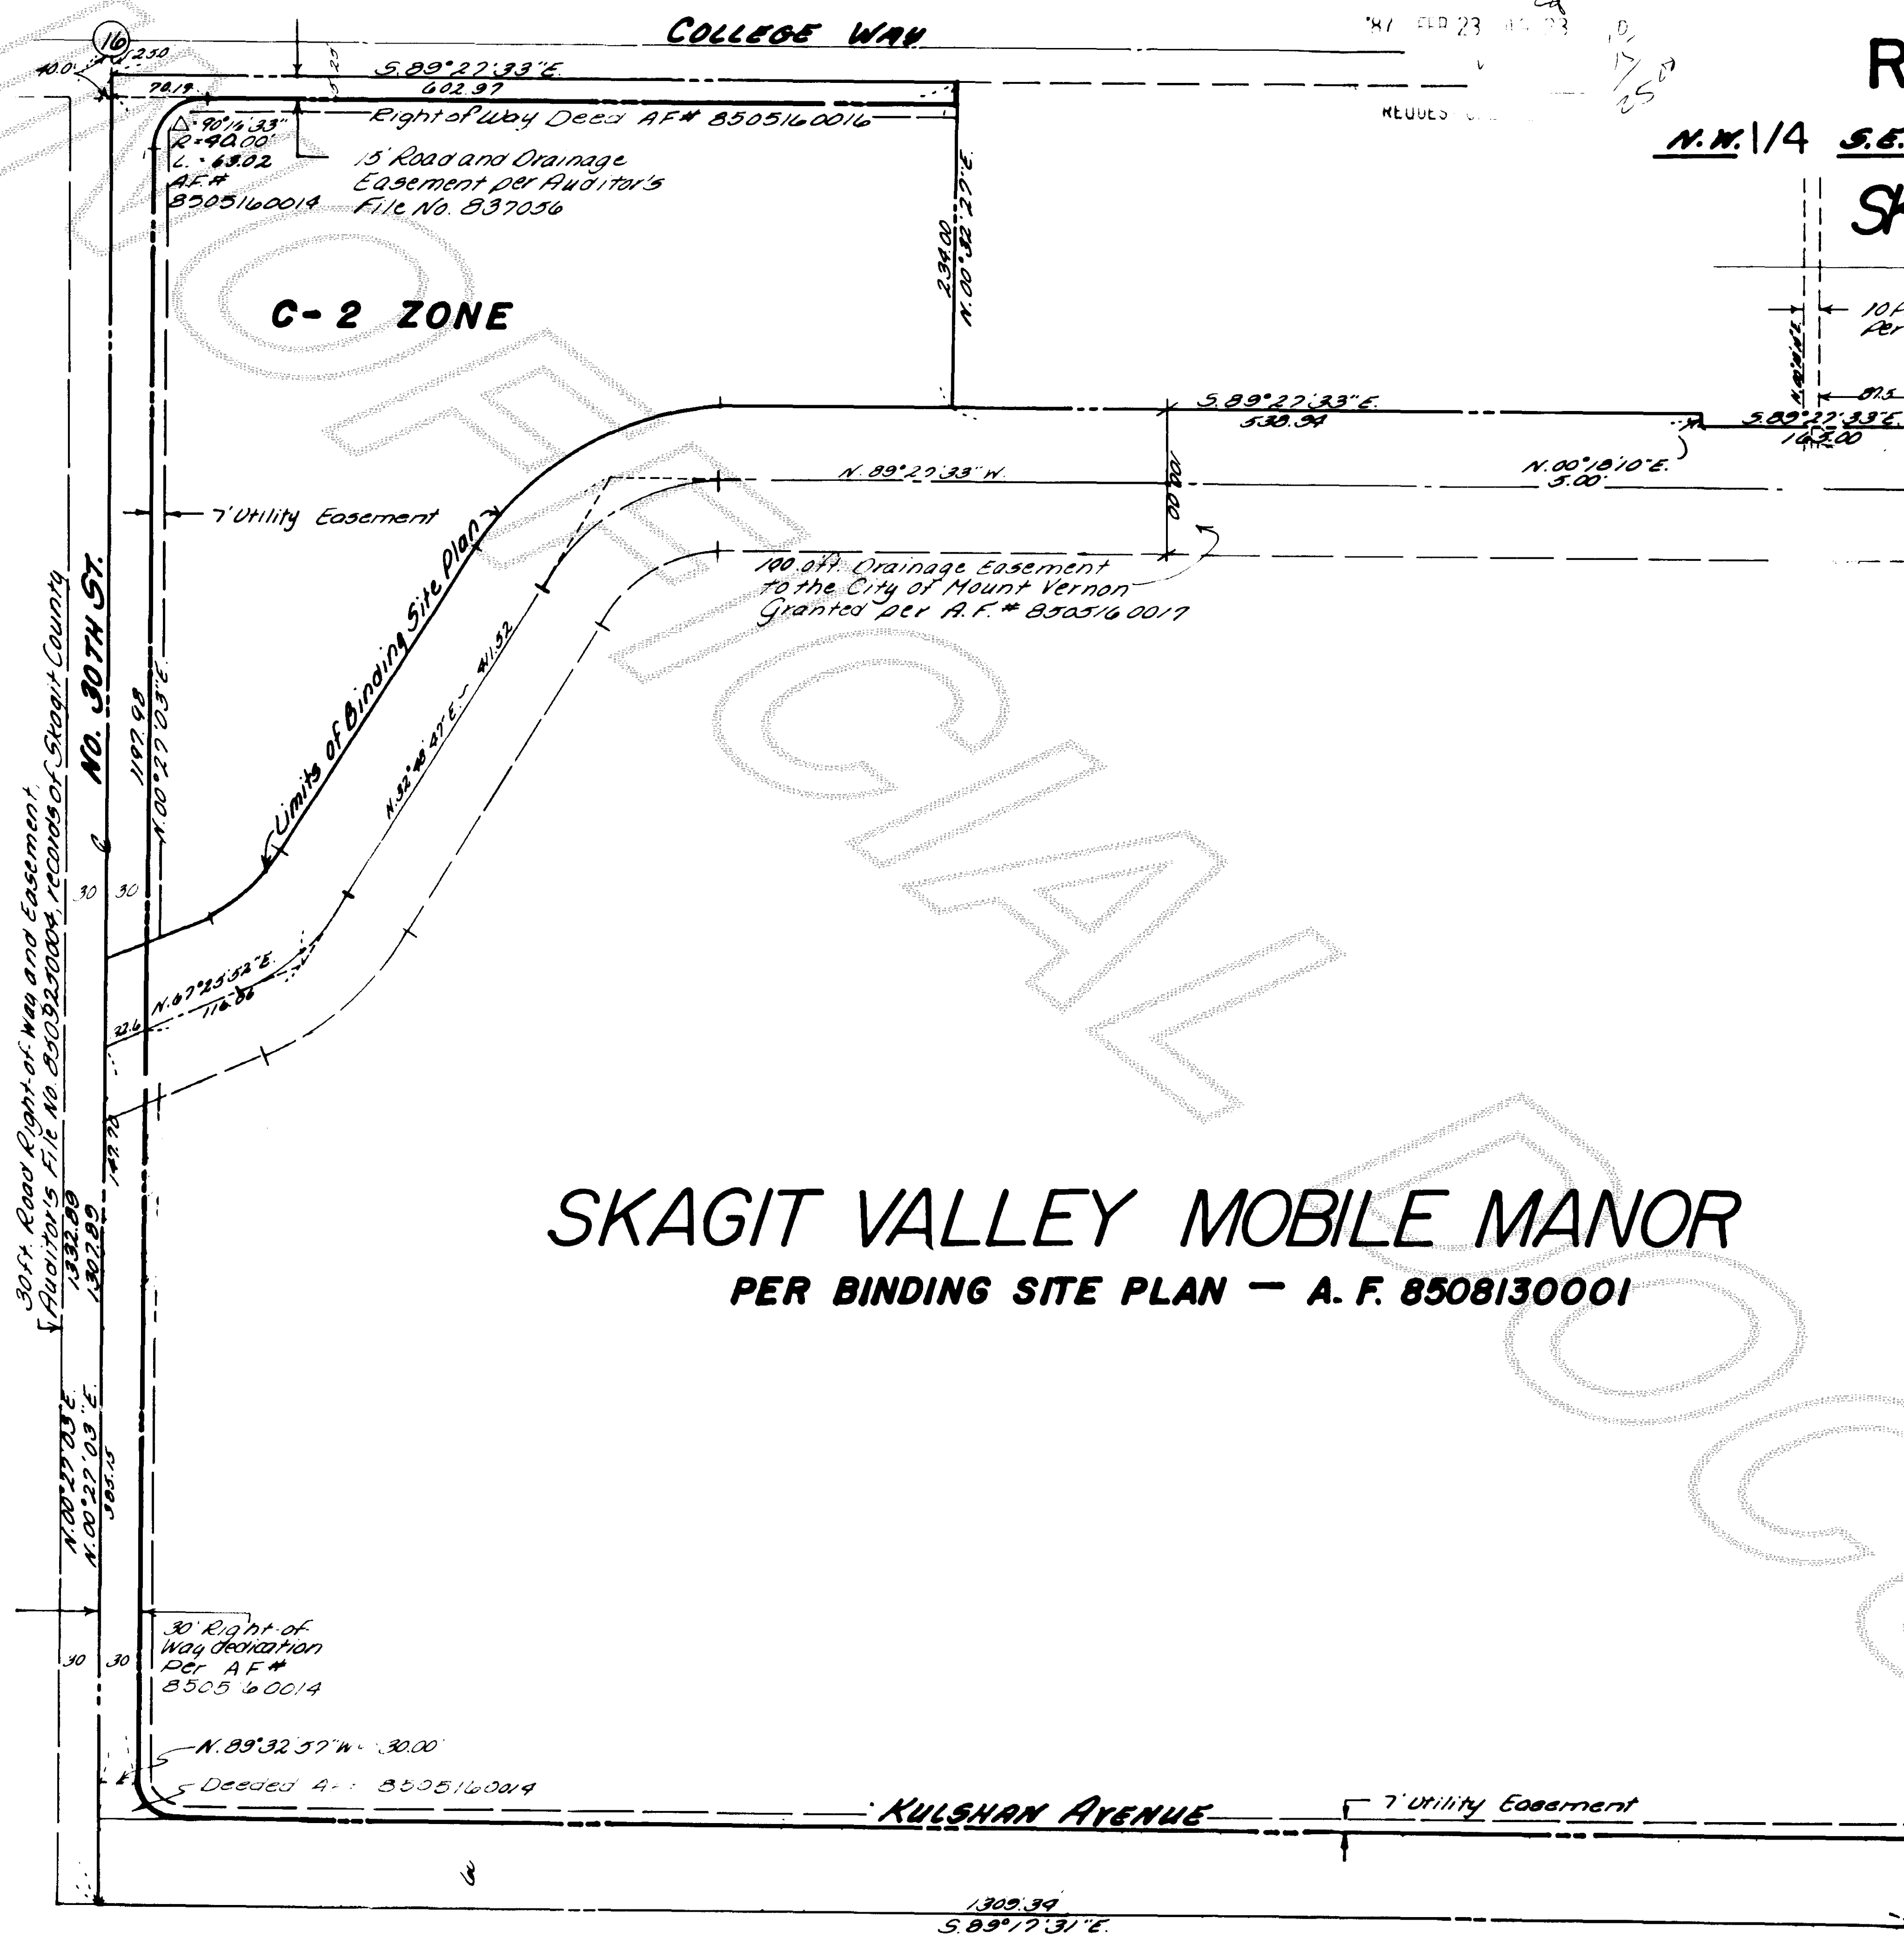

RECORD OF SURVEY

N.W. 1/4 S.E. 1/4 SECTION 16, TWP. 34 N., RGE. 1 E., WM.

SKAGIT COUNTY, WASHINGTON

NOTES:

1. This record of Survey reflects boundary information from Survey recorded in Vol. 6 of Surveys, at page 21, Records of Skagit County, under Auditor's File No. 8505090002.
2. The purpose of this survey is to dedicate right-of-way for N. 30th St. and to establish easements for storm drainage, ingress, egress and utilities.
3. Lot Dimensions within Skagit Valley Mobile Manor are shown on "SKAGIT VALLEY MOBILE MANOR, BINDING SITE PLAN" as approved by the City of Mount Vernon City Council, under Auditor's File No. 8508130001.
4. Development of Phase II of Skagit Valley Mobile Manor will require recording of a survey which will dedicate additional right-of-way and establish additional easements.

DEDICATION:

We hereby create and grant easements shown hereon to the City of Mount Vernon for drainage, utility purposes, and access, together with ingress and egress easements for the tenants of the mobile home park and utilities providing service thereto.

IN WITNESS WHEREOF we have set our hands and seals

ACKNOWLEDGEMENT:

State of Washington ss
County of Skagit }


On this 23 day of Feb, 1987, before me, the undersigned, a Notary Public, in and for the State of Washington, duly commissioned and sworn, personally appeared

To me known to be the individual that executed the within and foregoing instrument and acknowledged that he signed and sealed the same as voluntary act and deed for the uses and purposes therein mentioned.

In witness whereof, I have hereunto set my hand and affixed my official seal the day and year first above written.

Notary Public, in and for the State of Washington, residing at _____

1. Revised Per Markup 12-17-86

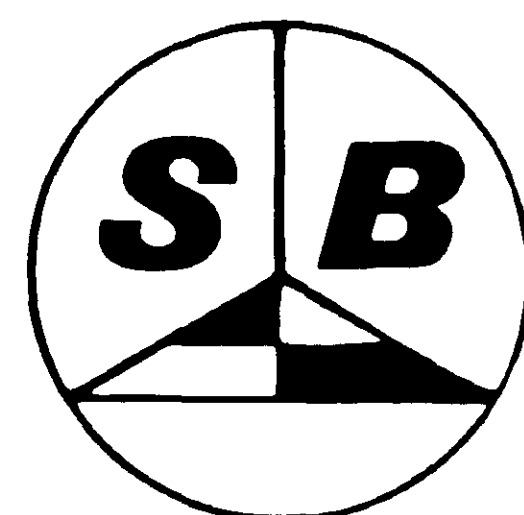

**SADLER/
BARNARD
& ASSOC. INC.**

LAND & MINERAL SURVEYING
CIVIL ENGINEERING
PLANNING & PLATTING

SURVEYED FOR:

RICHARD JILES

Scale: 1" = 100'

Date: 10-21-85

Drawn: Fuestan

Revised:

Surveyed by: **SADLER/BARNARD & ASSOC.**

31218 Pacific Highway South
Federal Way, Washington 98003

Phone: (206) 841-1599, 827-8884

Dwg. No. 85-159

G/L # 85-059



SURVEYOR'S CERTIFICATE

This map correctly represents a survey made by me or under my direction in conformance with the requirements of the Survey Recording Act at the request of _____

in October 1985

Signed and Sealed

Lic. No. 12288

RECORDING NO. 8702230002

RECORDER'S CERTIFICATE

Filed for record this 23 day of Feb, 1987
at 7:23 A.M. in book 7 of Surveys at page 30
at the request of Richard Jiles

Manager

Sup. of Records

vol 7 Survey Pg 30

1152 92-122