


9304120079

Survey in the NE1/4 of the NE1/4 of Section 13, Twp. 35 N., Rng. 3 E., W.M.

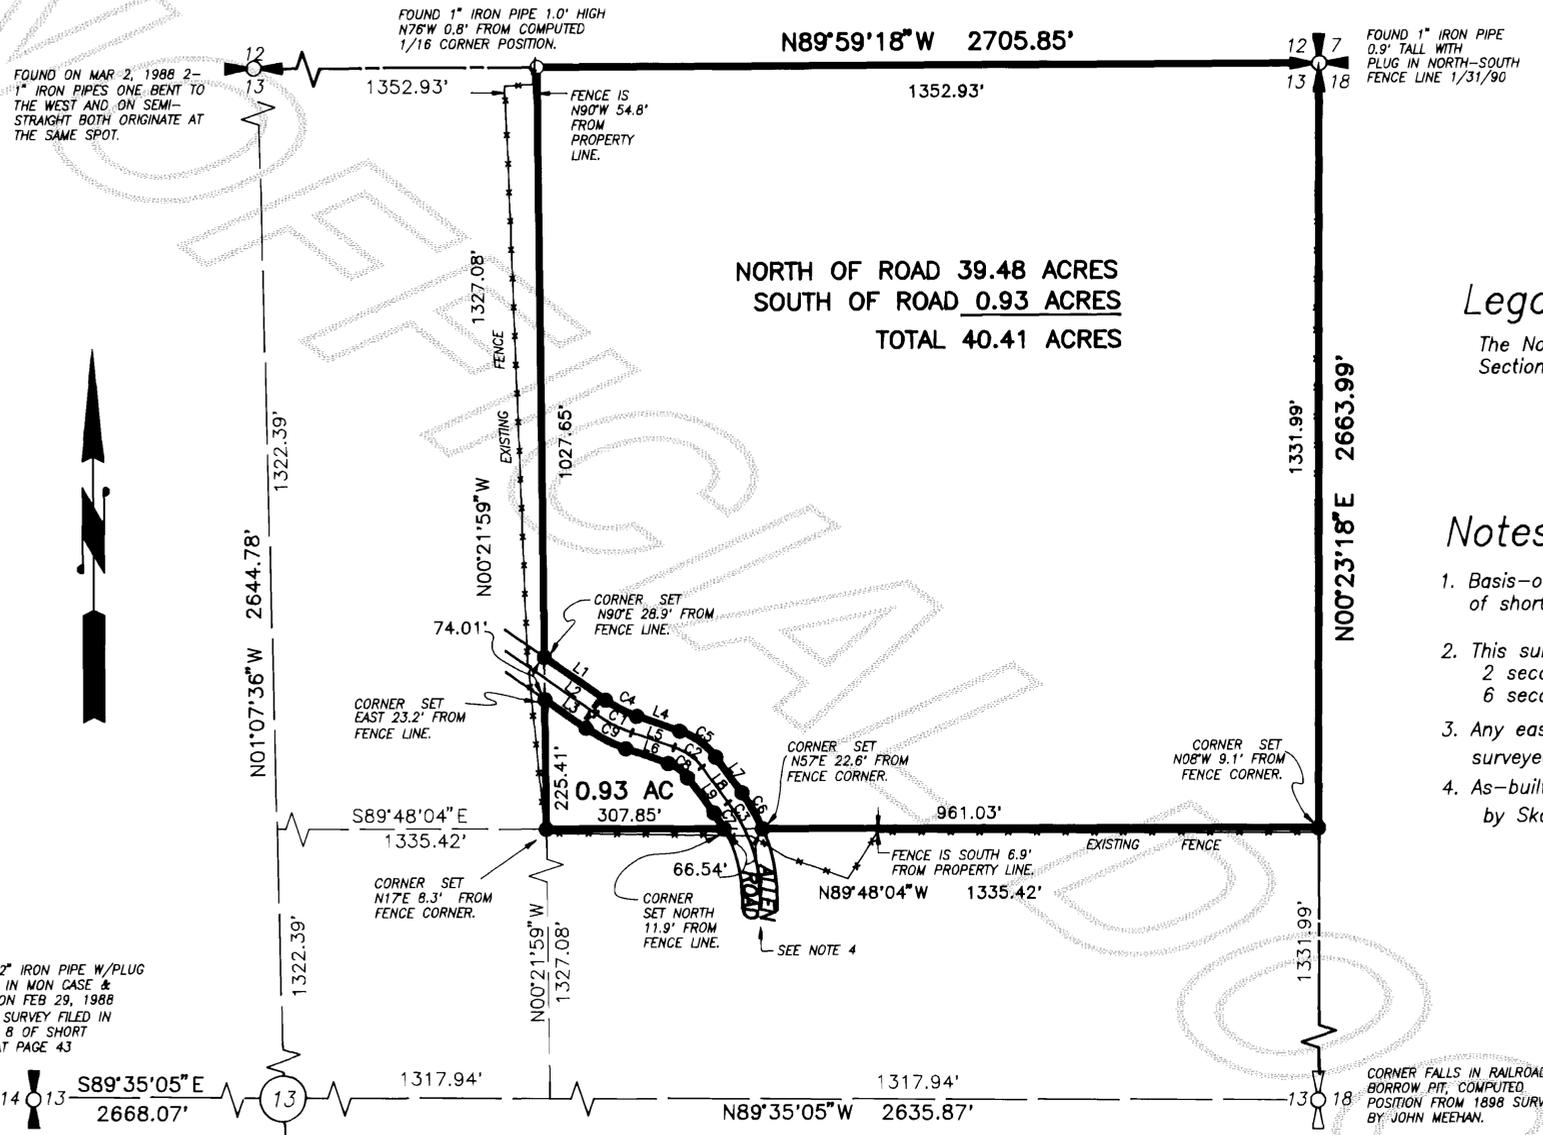

Legal Description

The Northeast quarter of the Northeast quarter of Section 13, Township 35 North, Range 3 East, W.M.


Notes

1. Basis-of-bearings - Short Plat No. 23-88 filed in Vol. 8 of short plats page 43 under A.F.# 8806080061.
2. This survey was accomplished by field traverse using: 2 second digital electronic Total Station, and 6 second optical micrometer Total Station.
3. Any easements that may lie within this property were not surveyed.
4. As-built Allen Road 60' width established November 3, 1884 by Skagit County Commissioners.

Legend

- Set 1/2" X 18" reinf. rod with yellow plastic cap marked "SKA SURV 17651" and white 2" X 2" witness stake, except as noted.

CURVE TABLE			LINE TABLE		
#	RADIUS	DELTA	LENGTH	#	LENGTH
C1	250.00'	16°00'08"	69.82'	L1	129.77'
C2	100.00'	34°27'00"	60.13'	L2	108.10'
C3	282.00'	10°51'03"	53.41'	L3	86.43'
C4	220.00'	16°00'08"	61.44'	L4	78.55'
C5	130.00'	34°27'00"	78.16'	L5	78.55'
C6	312.00'	13°26'35"	73.20'	L6	78.55'
C7	252.00'	07°33'40"	33.26'	L7	75.87'
C8	70.00'	34°27'00"	42.09'	L8	75.87'
C9	280.00'	16°00'08"	78.20'	L9	75.87'

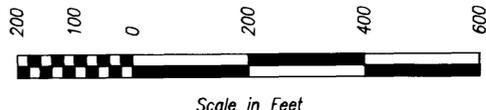

AUDITOR'S CERTIFICATE
 Filed for record this 12 day of April 1992 at 5:54 minutes past 10 o'clock P.M., and recorded in Volume 14 of Surveys at page 54, records of Skagit County, Wa.
 Cheryl J. Anderson
 County Auditor or Deputy Auditor
 A.F.# 9304120079

SURVEYOR'S CERTIFICATE
 This map correctly represents a survey made by me or under my direction in conformance with the Survey Recording Act in June 1992 at the request of Clifford Anderson.
 JOHN L. ABERNETHY
 Date 10/30/92
 CERT.# 17651



Skagit Surveyors INC.
 806 Metcalf St., Sedro-Woolley, WA 98284
 Phone: (206) 855-2121 FAX: (206) 855-1658

Survey for
 Clifford Anderson

DATE	REVISION	BY	JOB#	DRAWN	CHECKED	DATE	SCALE	SHEET
			955-90	CAD	DJM	10JUN92	1" = 200'	1 OF 1

V-14 Saw 1954