

FIRST AMENDMENT TO SURVEY MAP AND PLANS FOR ALPINE FAIRWAY VILLA CONDOMINIUM, PHASE II

IN A PORTION OF SECTION 27, TWP. 34 N., RGE. 4 E., W.M.

DEDICATION

KNOW ALL PERSONS BY THESE PRESENTS THAT WE, THE UNDERSIGNED OWNERS OF "ALPINE FAIRWAY VILLA CONDOMINIUM" IN FEE SIMPLE AND/OR MORTGAGE HOLDERS OF THE PROPERTY HEREIN DESCRIBED, HEREBY DECLARE THIS SURVEY MAP AND PLANS AND DEDICATE THE SAME FOR CONDOMINIUM PURPOSES. THIS SURVEY MAP AND PLANS AND ANY PORTION THEREOF SHALL BE RESTRICTED BY THE TERMS OF THE CONDOMINIUM DECLARATION FILED CONTEMPORANEOUSLY HERewith. THIS DEDICATION IS NOT FOR ANY OTHER USE THAN TO MEET THE REQUIREMENTS OF THE WASHINGTON CONDOMINIUM ACT (RCW 64.34) FOR A SURVEY AND PLANS, AND TO SUBMIT THE PROPERTY TO THE ACT AS PROVIDED IN THE DECLARATION.

IN WITNESS WHEREOF WE HAVE HEREUNTO SET OUR HANDS AND SEALS

THIS 31st DAY OF December, 1999

SEA-VAN INVESTMENTS ASSOCIATES, A WASHINGTON GENERAL PARTNERSHIP
Washington Federal Savings
UNITED STATES CORPORATION

LIGO CONSTRUCTION, INC.
A WASHINGTON CORPORATION
THE FARMER'S BANK OF CHINA

COUNTY TREASURER'S CERTIFICATE

THIS IS TO CERTIFY THAT ALL TAXES HERETOFORE LEVIED AND WHICH HAVE BECOME A LIEN UPON THE LANDS HEREIN DESCRIBED, HAVE BEEN FULLY PAID AND DISCHARGED ACCORDING TO THE RECORDS OF MY OFFICE, UP TO AND INCLUDING THE YEAR OF 1999.

THIS 31st DAY OF December, 1999

Shirley M. Meisick
 Skagit County Treasurer

DECLARATION REFERENCE

THE DECLARATION PREPARED UNDER THE WASHINGTON CONDOMINIUM ACT FOR THE CONDOMINIUM, TO WHICH THIS SURVEY MAP AND PLANS REFER, WAS RECORDED WITH THE AUDITOR OF SKAGIT COUNTY, WASHINGTON, ON December 3, 1999, UNDER AUDITOR'S FILE NO. 199912030105

ACKNOWLEDGMENT FOR SURVEYOR

STATE OF WASHINGTON)
) SS
 COUNTY OF SKAGIT)

I CERTIFY THAT I KNOW OR HAVE SATISFACTORY EVIDENCE THAT JEFFREY A. SKODJE, P.L.S. IS THE PERSON WHO APPEARED BEFORE ME AND SAID PERSON ACKNOWLEDGED THAT HE SIGNED THIS INSTRUMENT, AND HAS ACKNOWLEDGED IT TO BE THE FREE AND VOLUNTARY ACT OF SUCH PERSON FOR THE USES AND PURPOSES IN THIS INSTRUMENT AND IN THE WASHINGTON CONDOMINIUM ACT.

Cathy L. Scott
 NOTARY PUBLIC IN AND FOR
 THE STATE OF WASHINGTON

RESIDING AT Bau, WA.

MY COMMISSION EXPIRES: 6-21-03

DATE: 12-03-99

SURVEYOR'S CERTIFICATE


I HEREBY CERTIFY THAT THIS SURVEY MAP AND PLANS IS BASED ON AN ACTUAL SURVEY OF THE PROPERTY HEREIN DESCRIBED, THAT THE COURSES AND DISTANCES ARE SHOWN CORRECTLY AND THAT INFORMATION REQUIRED BY RCW 64.34.232 IS SHOWN OR SUPPLIED HEREIN. I FURTHER DECLARE THAT THE HORIZONTAL AND VERTICAL BOUNDARIES OF THE UNITS IN THIS CONDOMINIUM ARE SUBSTANTIALLY COMPLETED IN ACCORDANCE WITH THE PLANS CONTAINED HEREIN.

Jeffrey A. Skodje
 JEFFREY A. SKODJE, P.L.S.
 CERTIFICATE NO. 19645
 DATE 12-3-99



NOTES

1. BASIS OF BEARING: PLAT OF EAGLEMONT PHASE 1A, N 39° 40' 51" E BETWEEN THE FOUND SOUTH CORNER AND THE FOUND CORNER ALONG THE EAST LINE THEREOF.
2. THIS SURVEY WAS PERFORMED IN THE FIELD USING A LIETZ SET 4A ELECTRONIC DISTANCE MEASURING THEODOLITE.
3. PER ITEMS A, B, & C, SCHEDULE "B-1" OF FIRST AMERICAN TITLE COMPANY SUBDIVISION GUARANTEE, ORDER NO. 58487, THE SUBJECT PARCELS ARE SUBJECT TO RESERVATIONS FOR OIL, GASES, COAL, ORES, MINERALS, FOSSILS, ETC. AS SET FORTH IN INSTRUMENTS RECORDED UNDER SKAGIT COUNTY AUDITOR'S FILE NOS. 348986, 128138, AND 102029, RESPECTIVELY.
4. PER ITEM C, SCHEDULE "B-1" OF LAND TITLE COMPANY SUBDIVISION GUARANTEE, ORDER NO. S-90972, THE SUBJECT PARCELS ARE SUBJECT TO DECLARATION OF COVENANTS, CONDITIONS, AND RESTRICTIONS AS RECORDED UNDER SKAGIT COUNTY AUDITOR'S FILE NO. 9401250030 AND AS AMENDED UNDER SKAGIT COUNTY AUDITOR'S FILE NOS. 9512110030, & 9603180110, INCLUDING 5-FOOT SIDE YARD AND 10-FOOT REAR YARD EASEMENTS FOR UTILITIES AND DRAINAGE.
5. PER ITEMS F & G, SCHEDULE "B-1" OF LAND TITLE COMPANY SUBDIVISION GUARANTEE, ORDER NO. S-90972, THE SUBJECT PARCELS ARE SUBJECT TO UTILITY EASEMENT PROVISIONS AND PRIVATE DRAINAGE EASEMENTS AS SET FORTH ON THE FACE OF "ALPINE FAIRWAY VILLA", RECORDED IN VOLUME 17 OF PLATS, PAGES 32 AND 33, RECORDS OF SKAGIT COUNTY, WASHINGTON.
6. PER ITEM E, SCHEDULE "B-1" OF LAND TITLE COMPANY SUBDIVISION GUARANTEE, ORDER NO. S-90972, ALL LOTS ARE SUBJECT TO AND TOGETHER WITH THE EASEMENT AS SHOWN, THE PURPOSE OF WHICH IS FOR INGRESS-EGRESS, UTILITIES AND PARKING AS SHOWN ON SHEET 1 OF "ALPINE FAIRWAY VILLA", AN EASEMENT WAS GRANTED TO THE CITY OF MOUNT VERNON ON THE FACE OF SAID PLAT FOR THE PURPOSES OF MAINTENANCE, INSPECTION AND CONSTRUCTION OF SANITARY SEWAGE FACILITIES WITH NECESSARY APPURTENANCES. THE CITY SHALL BE RESPONSIBLE FOR THE MAINTENANCE OF THE SEWER MAIN LINE BUT NOT THE SIDE SEWER LATERALS. THE CITY SHALL NOT BE RESPONSIBLE FOR THE MAINTENANCE OF THE ROAD, BRIDGE OR STORM DRAINAGE. ALSO:
 - A. LOT 6 IS SUBJECT TO A 20 FOOT EASEMENT FOR INSTALLATION AND MAINTENANCE OF A WATERLINE, IN FAVOR OF SKAGIT COUNTY PUD, SEE PUD EASE. PROVISION ON PLAT.
 - B. LOTS 1 THROUGH 6 INCLUSIVE, ARE SUBJECT TO AN EASEMENT FOR STORM WATER CONVEYANCE, FOR THE EQUAL BENEFIT OF LOTS 1 THROUGH 10 INCLUSIVE, TOGETHER WITH THE RIGHT OF INGRESS-EGRESS FOR THE INSTALLATION AND MAINTENANCE OF SAID STORM LINES, OVER, UNDER AND ACROSS. SEE EASE. DEDICATION THIS SHEET.
 - C. LOTS 2 AND 3 INCLUSIVE ARE SUBJECT TO A 4 FOOT EASEMENT AS SHOWN, FOR STORM WATER CONVEYANCE, FOR THE EQUAL BENEFIT OF LOTS 1 THROUGH 10 INCLUSIVE, TOGETHER WITH THE RIGHT OF INGRESS-EGRESS FOR THE INSTALLATION AND MAINTENANCE OF SAID STORM LINES, OVER, UNDER AND ACROSS. SEE EASE. DEDICATION ON PLAT.
 - D. THE 10 FOOT UTILITY EASEMENT IS LOCATED ADJOINING THE ROADWAY-UTILITY EASEMENT AS SHOWN AND REFERENCED ABOVE.
 - E. LOT 1 IS SUBJECT TO A 20 FOOT SEWER EASEMENT FOR THE BENEFIT OF LOT 2.
 - F. ALL DEVELOPMENT WITHIN THE SUBJECT PARCELS SHALL CONFORM TO THE RECOMMENDATIONS AND CONDITIONS OF APPROVAL FOR THE EAGLEMONT TRACT 202 PHASE 1 FINAL PLANNED UNIT DEVELOPMENT APPROVED BY THE CITY OF MOUNT VERNON CITY COUNCIL ON FEBRUARY 25, 1998.
7. PER ITEM I, SCHEDULE "B-1" OF LAND TITLE COMPANY SUBDIVISION GUARANTEE, ORDER NO. S-90972, PARCELS ARE SUBJECT TO P.U.D. WATER PIPELINE EASEMENT PROVISION AS DISCLOSED ON THE FACE OF "ALPINE FAIRWAY VILLA".
8. PER ITEM J, SCHEDULE "B-1" OF LAND TITLE COMPANY SUBDIVISION GUARANTEE, ORDER NO. S-90972, PARCELS ARE SUBJECT TO BUFFER EASEMENT PROVISION AS DISCLOSED ON THE FACE OF "ALPINE FAIRWAY VILLA".
9. PER ITEM A, SCHEDULE "B-1" OF LAND TITLE COMPANY SUBDIVISION GUARANTEE, ORDER NO. S-90972, PARCELS ARE SUBJECT TO AN EASEMENT "10 FEET IN WIDTH PER MUTUAL AGREEMENT..." TO CASCADE NATURAL GAS CORPORATION AS SET FORTH BY INSTRUMENT RECORDED UNDER AUDITOR'S FILE NO. 9310110127. THE EXACT LOCATION NOT DISCLOSED IN SAID INSTRUMENT.
10. PER ITEM B, SCHEDULE "B-1" OF LAND TITLE COMPANY SUBDIVISION GUARANTEE, ORDER NO. S-90972, PARCELS ARE SUBJECT TO AN EASEMENT TO PUGET SOUND POWER & LIGHT CO. AS SET FORTH BY INSTRUMENT RECORDED UNDER AUDITOR'S FILE NO. 931020145. SAID EASEMENT AFFECTS "ALL STREETS, ROAD RIGHTS-OF-WAY, GREEN BELTS, OPEN SPACES, AND UTILITY EASEMENTS AS NOW OR HEREAFTER DESIGNED, PLATTED,..." AND "A STRIP OF LAND 10 FEET IN WIDTH ACROSS ALL LOTS, TRACTS, AND SPACES, BEING PARALLEL TO AND COINCIDENT WITH THE BOUNDARIES OF ALL PRIVATE/PUBLIC STREET AND ROAD RIGHTS-OF-WAY".
11. PER ITEM H, SCHEDULE "B-1" OF LAND TITLE COMPANY SUBDIVISION GUARANTEE, ORDER NO. S-90972, PARCELS ARE SUBJECT TO IMPACT FEES PAYABLE ON ISSUANCE OF ABUILDING PERMIT.
12. PER ITEM K, SCHEDULE "B-1" OF LAND TITLE COMPANY SUBDIVISION GUARANTEE, ORDER NO. S-90972, REFER TO CONDOMINIUM PHASE 1 DECLARATION RECORDED UNDER A.F. NO. 9905260007.

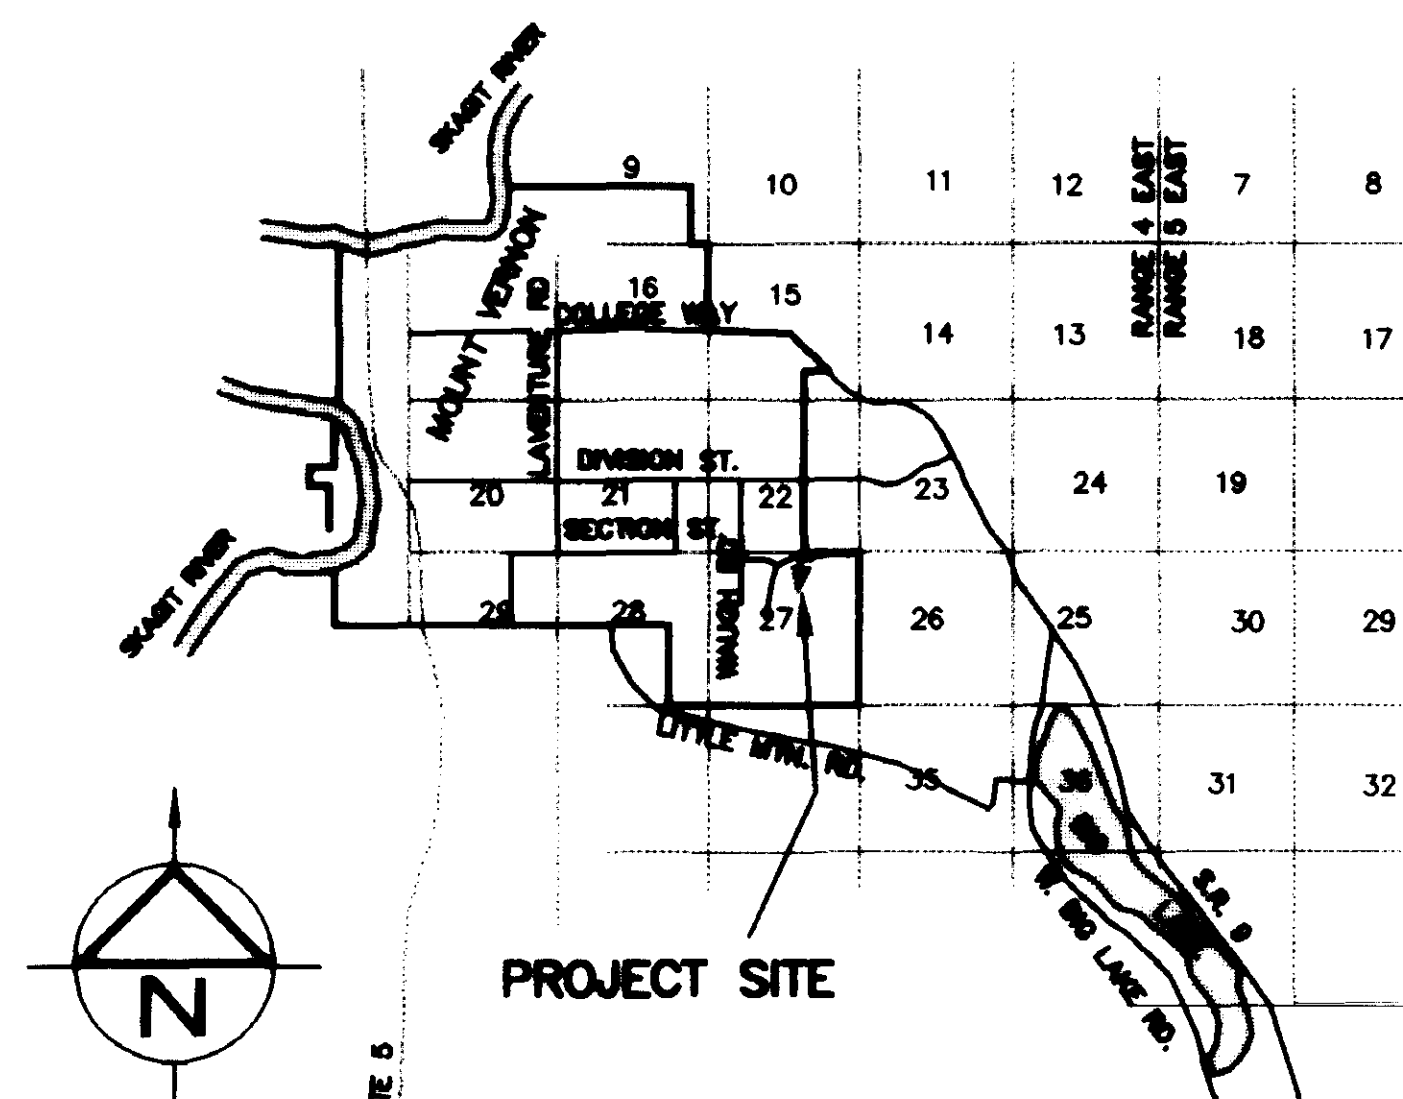

VICINITY MAP
 NOT TO SCALE

ACKNOWLEDGMENT

STATE OF Washington
) SS
 COUNTY OF Skagit)

I HEREBY CERTIFY THAT I KNOW OR HAVE SATISFACTORY EVIDENCE THAT Edw. D. Boudinot IS THE PERSON WHO APPEARED BEFORE ME, AND SAID PERSON ACKNOWLEDGED THAT (S)HE SIGNED THIS INSTRUMENT, ON OATH THAT (S)HE WAS AUTHORIZED TO EXECUTE THE INSTRUMENT AND ACKNOWLEDGED IT AS THE General Manager SEA-VAN INVESTMENTS ASSOCIATES TO BE THE FREE AND VOLUNTARY ACT OF SUCH PARTY FOR THE USES AND PURPOSES MENTIONED IN THE INSTRUMENT.

DATED 12-1-1999

Notary Public
 RESIDING AT Sedro-Woolley

ACKNOWLEDGMENT

STATE OF Washington
) SS
 COUNTY OF Skagit)

I HEREBY CERTIFY THAT I KNOW OR HAVE SATISFACTORY EVIDENCE THAT Edw. D. Boudinot IS THE PERSON WHO APPEARED BEFORE ME, AND SAID PERSON ACKNOWLEDGED THAT (S)HE SIGNED THIS INSTRUMENT, ON OATH THAT (S)HE WAS AUTHORIZED TO EXECUTE THE INSTRUMENT AND ACKNOWLEDGED IT AS THE General Manager Ligo Construction Inc. TO BE THE FREE AND VOLUNTARY ACT OF SUCH PARTY FOR THE USES AND PURPOSES MENTIONED IN THE INSTRUMENT.

DATED 12-1-1999

Notary Public
 RESIDING AT Sedro-Woolley

ACKNOWLEDGMENT FOR MORTGAGEE

STATE OF WASHINGTON)
) SS
 COUNTY OF SKAGIT)

I HEREBY CERTIFY THAT I KNOW OR HAVE SATISFACTORY EVIDENCE THAT Doug Powell IS THE PERSON WHO APPEARED BEFORE ME, AND SAID PERSON ACKNOWLEDGED THAT (S)HE SIGNED THIS INSTRUMENT, ON OATH THAT (S)HE WAS AUTHORIZED TO EXECUTE THE INSTRUMENT AND ACKNOWLEDGED IT AS THE Vice President Washington Federal Savings TO BE THE FREE AND VOLUNTARY ACT OF SUCH PARTY FOR THE USES AND PURPOSES MENTIONED IN THE INSTRUMENT.

DATED December 1, 1999

Cheryl C. Holmstrom
 NOTARY PUBLIC
 RESIDING AT Mount Vernon

ACKNOWLEDGMENT FOR MORTGAGEE

STATE OF WASHINGTON)
) SS
 COUNTY OF SKAGIT)

I HEREBY CERTIFY THAT I KNOW OR HAVE SATISFACTORY EVIDENCE THAT Paul Liu IS THE PERSON WHO APPEARED BEFORE ME, AND SAID PERSON ACKNOWLEDGED THAT (S)HE SIGNED THIS INSTRUMENT, ON OATH THAT (S)HE WAS AUTHORIZED TO EXECUTE THE INSTRUMENT AND ACKNOWLEDGED IT AS THE VP GM Farmers Bank of China TO BE THE FREE AND VOLUNTARY ACT OF SUCH PARTY FOR THE USES AND PURPOSES MENTIONED IN THE INSTRUMENT.

DATED December 2, 1999

Hong Kiew Freeman
 NOTARY PUBLIC
 RESIDING AT Issaquah

AUDITOR'S CERTIFICATE

FILED FOR RECORD AT THE REQUEST OF LEONARD, BOUDINOT & SKODJE, INC. THIS 3rd DAY OF December, 1999, AND RECORDED UNDER AUDITOR'S FILE NO. 199912030105 RECORDS OF SKAGIT COUNTY, WA.

Kathy Hilby Judy Zuvale

Leonard, Boudinot & Skodje Inc.
 PROFESSIONAL ENGINEERS & LAND SURVEYORS
 P.O. Box 1228, Mount Vernon, WA 98273
 (360) 336-5751

FIRST AMENDMENT TO SURVEY MAP AND PLANS FOR ALPINE FAIRWAY VILLA CONDOMINIUM, PHASE II

IN A PORTION OF SECTION 27, TWP. 34 N., RGE. 4 E., W.M.

199912030104
Kathy Hill, Skagit County Auditor

12/3/1999 Page 2 of 5 3:12:31PM

LEGAL DESCRIPTION


TRACT 202, "PLAT OF EAGLEMONT, PHASE 1A", AS PER PLAT RECORDED IN VOLUME 15 OF PLATS, PAGES 130 THROUGH 146, INCLUSIVE, RECORDS OF SKAGIT COUNTY, WASHINGTON.

TOGETHER WITH THAT PORTION OF LOT 67 OF SAID PLAT OF EAGLEMONT, PHASE 1A, DESCRIBED AS FOLLOWS: COMMENCING AT THE NORTHEAST CORNER OF SAID TRACT 202 THENCE S 85°36'34" W, ALONG THE NORTHEASTERLY LINE OF SAID TRACT 202 A DISTANCE OF 68.47 FEET TO THE TRUE POINT OF BEGINNING; THENCE CONTINUE S 85°36'34" W A DISTANCE OF 60.17 FEET; THENCE N 40°26'15" W A DISTANCE OF 43.54 FEET TO A POINT ON THE NORTHEASTERLY LINE OF SAID TRACT 202; THENCE S 84°00'58" E A DISTANCE OF 22.04 FEET; THENCE N 52°23'42" E A DISTANCE OF 36.99 FEET; THENCE S 37°10'42" E A DISTANCE OF 61.26 FEET TO THE TRUE POINT OF BEGINNING.

EXCEPTING THEREFROM THAT PORTION OF TRACT 202 DESCRIBED AS FOLLOWS: BEGINNING AT THE NORTHEASTERLY CORNER OF SAID TRACT 202; THENCE S 85°36'34" W A DISTANCE OF 68.47 FEET ALONG THE NORTHEASTERLY LINE THEREOF; THENCE S 37°10'42" E A DISTANCE OF 59.04 FEET TO THE EASTERLY LINE OF SAID TRACT 202; THENCE N 31°56'07" E, ALONG THE EASTERLY LINE THEREOF A DISTANCE OF 61.61 FEET TO THE TRUE POINT OF BEGINNING.

SITUATE IN THE COUNTY OF SKAGIT, STATE OF WASHINGTON.

(DESCRIPTION FROM "ALPINE FAIRWAY VILLA", PER PLAT RECORDED IN VOLUME 17 OF PLATS, PAGES 32 AND 33, RECORDS OF SKAGIT COUNTY, WA)

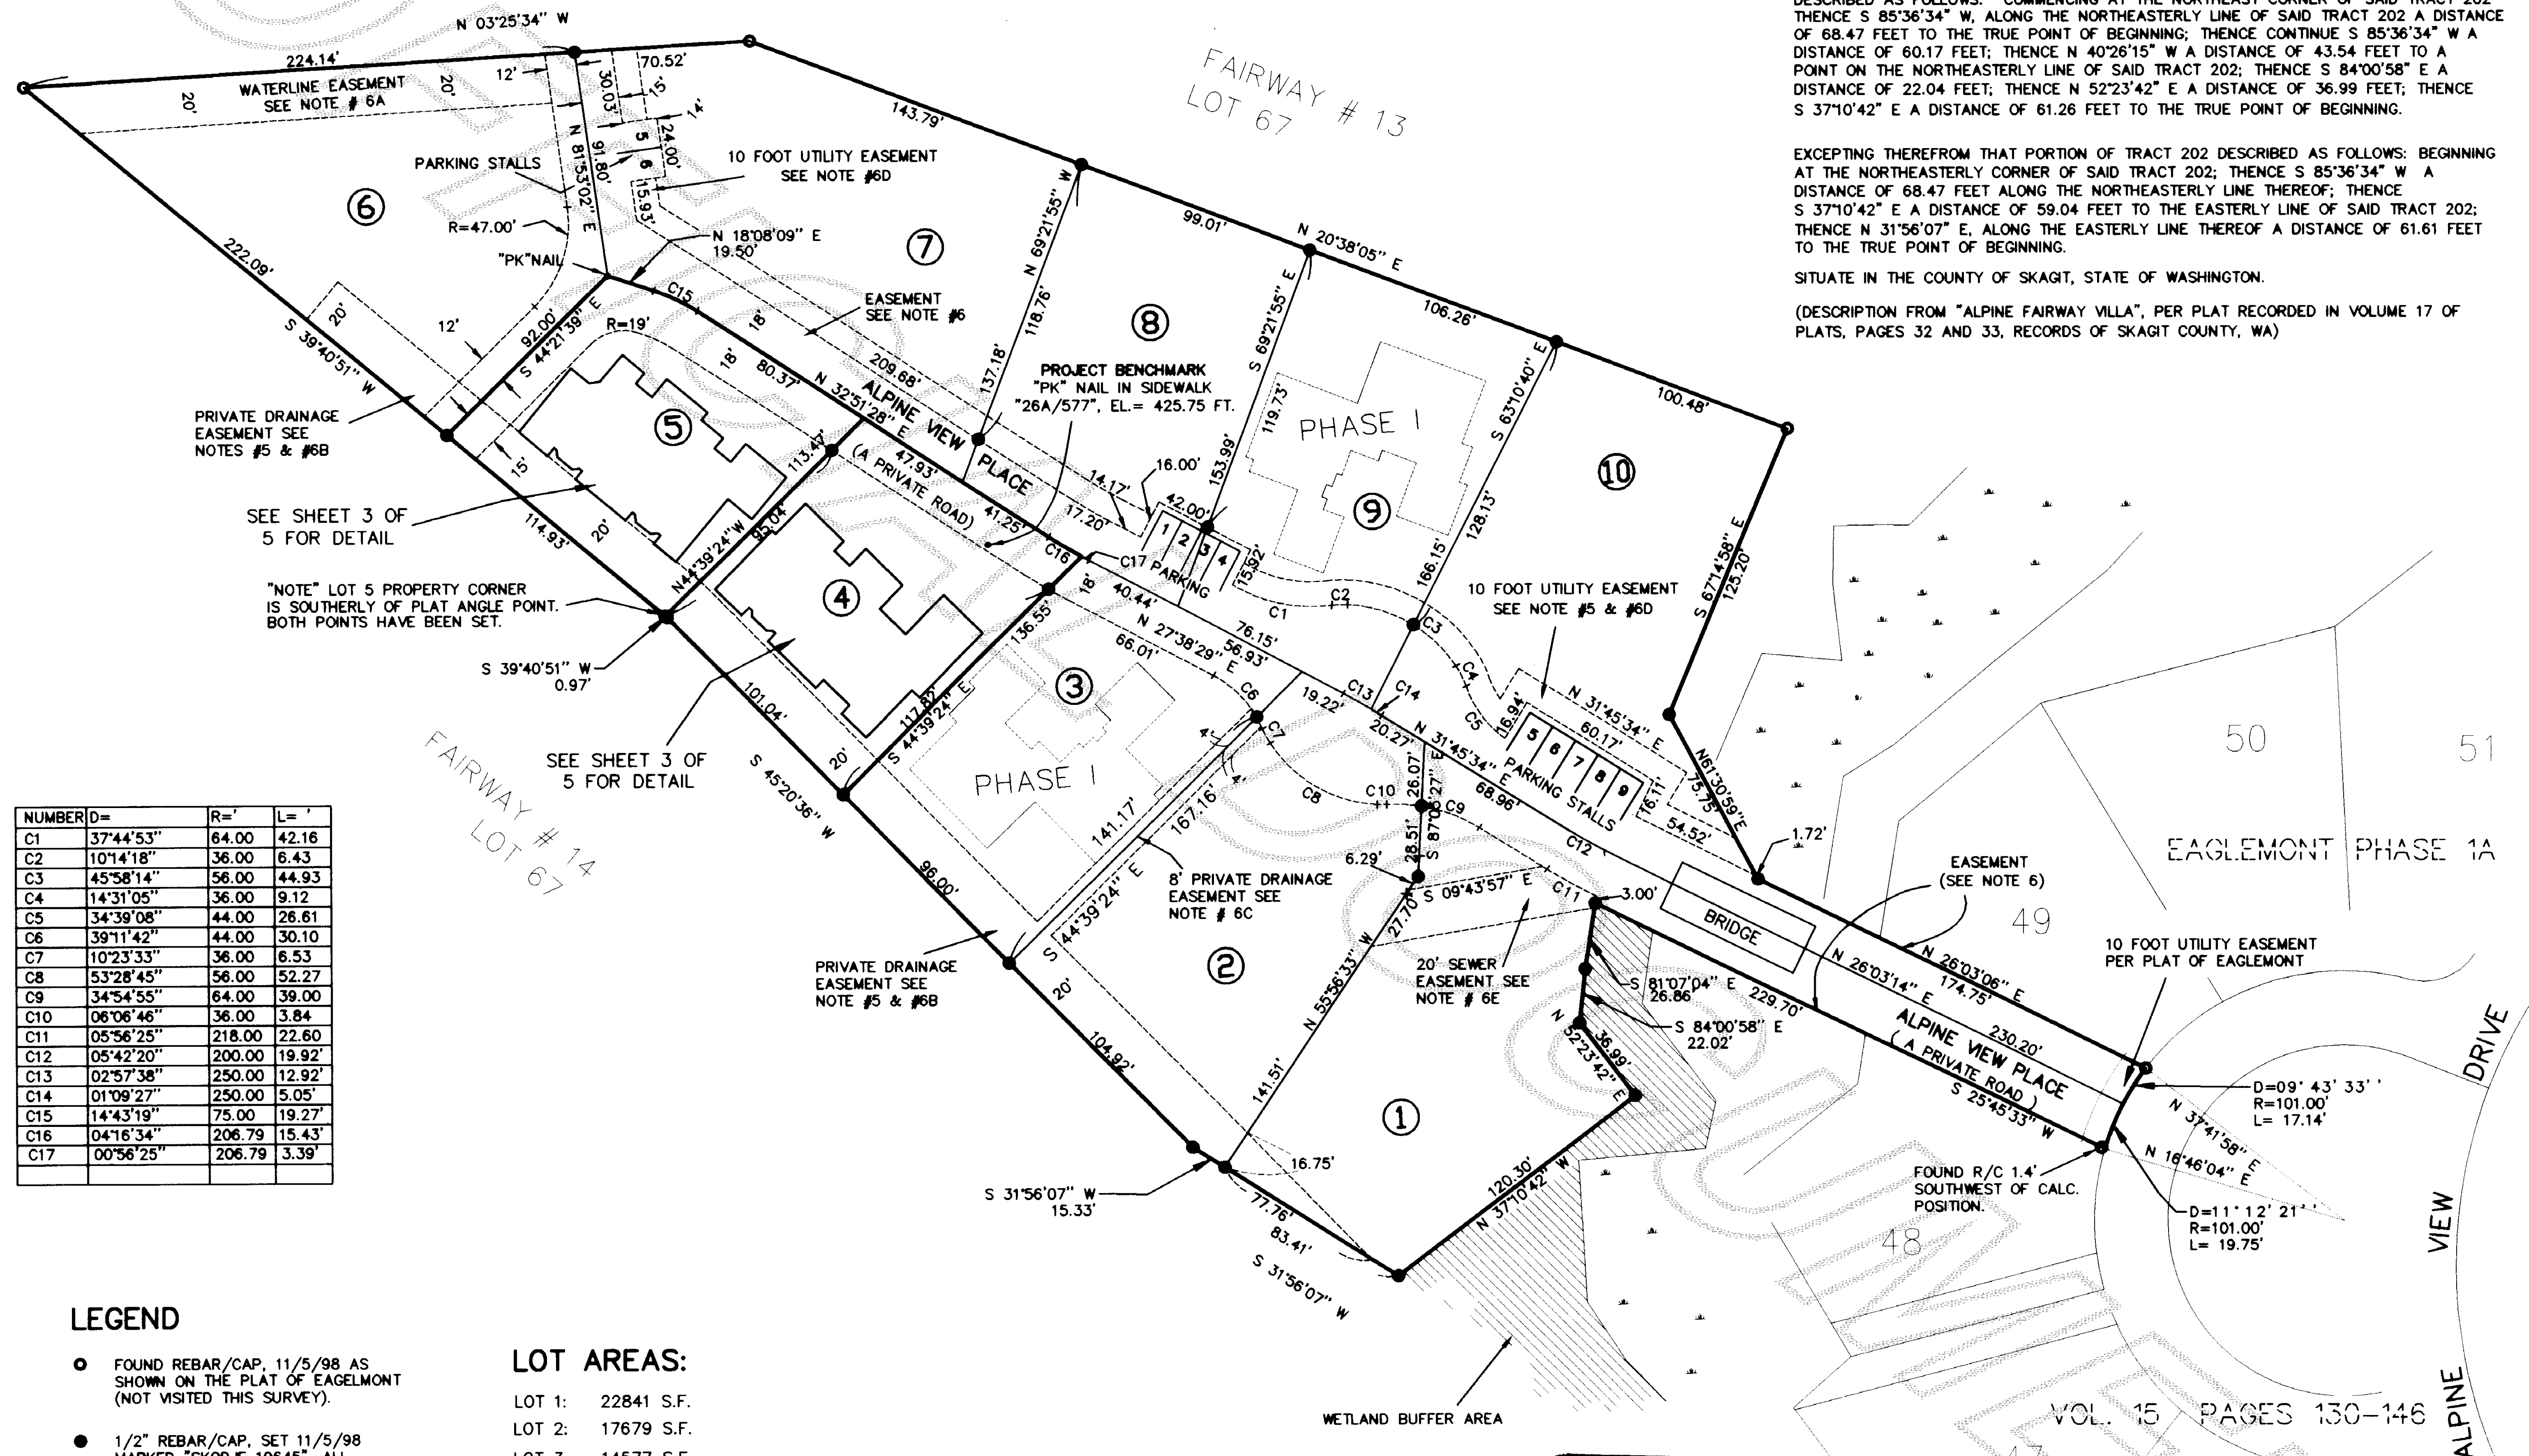

LEGEND


- FOUND REBAR/CAP, 11/5/98 AS SHOWN ON THE PLAT OF EAGLEMONT (NOT VISITED THIS SURVEY).
- 1/2" REBAR/CAP, SET 11/5/98 MARKED "SKODJE 19645", ALL FRONT CORNERS WERE SET AT THE ROAD EASEMENT LINE. (NOT VISITED THIS SURVEY).
- WETLANDS

LOT AREAS:

LOT 1:	22841 S.F.
LOT 2:	17679 S.F.
LOT 3:	14577 S.F.
LOT 4:	12719 S.F.
LOT 5:	12050 S.F.
LOT 6:	20414 S.F.
LOT 7:	21823 S.F.
LOT 8:	14527 S.F.
LOT 9:	15566 S.F.
LOT 10:	24038 S.F.

NOTE:

LOTS 1, 2, 6, 7, 8, & 10 ARE SUBJECT TO THE FOLLOWING DEVELOPMENT RIGHTS:
"SUBJECT TO DEVELOPMENT RIGHTS SET FORTH IN THE DECLARATION".
"MAY BE WITHDRAWN FROM THE CONDOMINIUM".

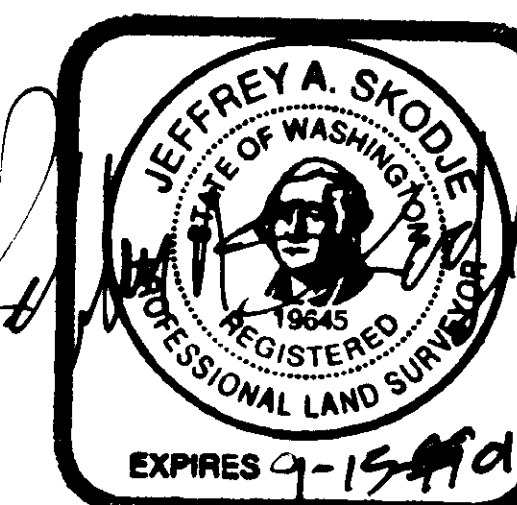

SURVEY MAP

SHEET 2 OF 5

DWN BY: JB/ML DATE: OCT. 1999
FIELD BOOK: 586 PGS. 23-25

LEONARD, BOUDINOT and SKODJE, INC.
CIVIL ENGINEERS AND LAND SURVEYORS
603 SOUTH FIRST ST., MOUNT VERNON, WA 98273 (360)336-5751

SCALE: 1" = 50'
JOB NO: 99194

FIRST AMENDMENT TO SURVEY MAP AND PLANS FOR ALPINE FAIRWAY VILLA CONDOMINIUM, PHASE II

IN A PORTION OF SECTION 27, TWP. 34 N., RGE. 4 E., W.M.

199912030104
Kathy Hill, Skagit County Auditor


12/3/1999 Page 4 of 6 3:12:31PM

SURVEY NOTES

1. OUTSIDE BUILDING DIMENSIONS SHOWN ON THIS SHEET WERE MEASURED TO CORNERS OF SIDING.
2. UNDERGROUND UTILITIES WERE NOT LOCATED FOR THIS SURVEY. CONTRACTORS SHOULD CALL UTILITY LOCATE SERVICES PRIOR TO DIGGING FOR CONSTRUCTION.
3. THE CRAWL SPACE BENEATH EACH UNIT IS A LIMITED COMMON ELEMENT FOR THAT UNIT AS STATED IN THE DECLARATION OF CONDOMINIUM.
4. DECKS AND PARKING (LCE) AT UNITS 4B & 4C WERE NOT CONSTRUCTED AT THE TIME OF THIS SURVEY. THESE FEATURES ARE DEPICTED HEREON AS PLANNED.

LEGEND

- (CE) DENOTES COMMON ELEMENT
- (LCE) DENOTES LIMITED COMMON ELEMENT
- DENOTES REBAR WITH CAP MARKED "SKODJE 19645", SET 11/5/98.

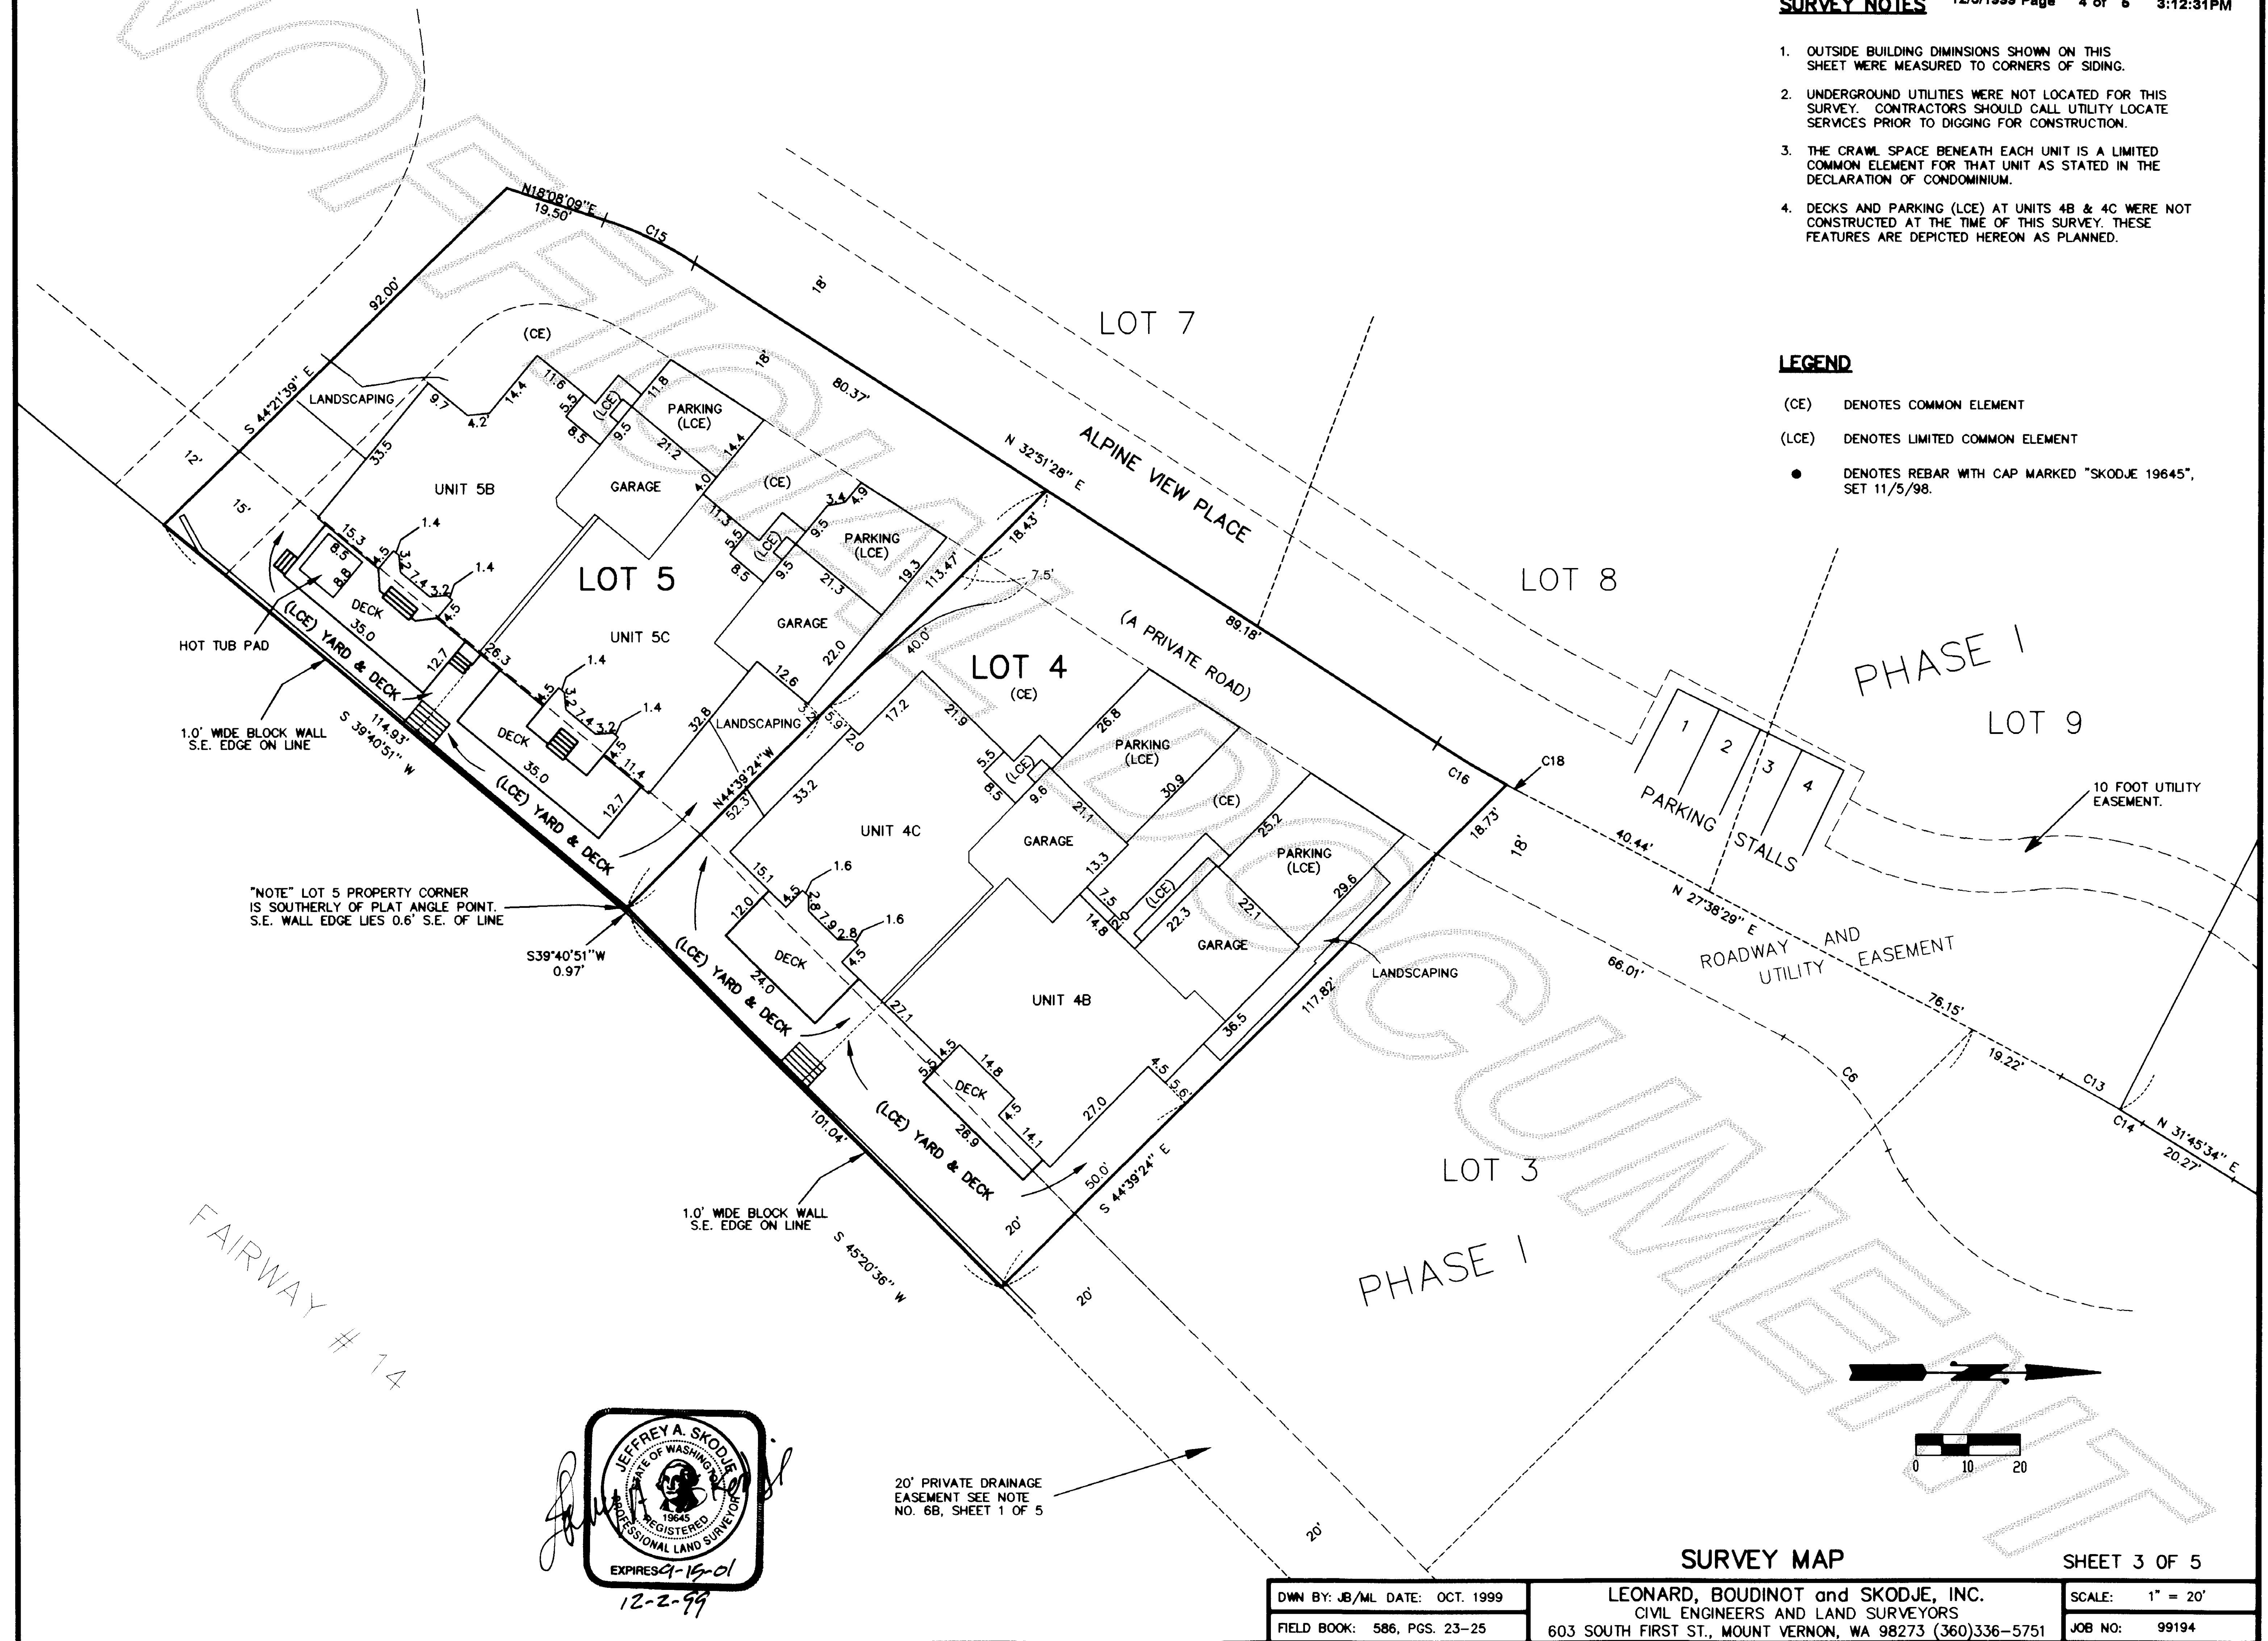

SURVEY MAP

SHEET 3 OF 5

DWN BY: JB/ML DATE: OCT. 1999

FIELD BOOK: 586, PGS. 23-25

LEONARD, BOUDINOT and SKODJE, INC.
CIVIL ENGINEERS AND LAND SURVEYORS




603 SOUTH FIRST ST., MOUNT VERNON, WA 98273 (360)336-5751

SCALE: 1" = 20'

JOB NO: 99194

FIRST AMENDMENT TO SURVEY MAP AND PLANS FOR ALPINE FAIRWAY VILLA CONDOMINIUM, PHASE II

199912030104
Kathy Hill, Skagit County Auditor
12/3/1999 Page 3 of 5 3:12:31PM

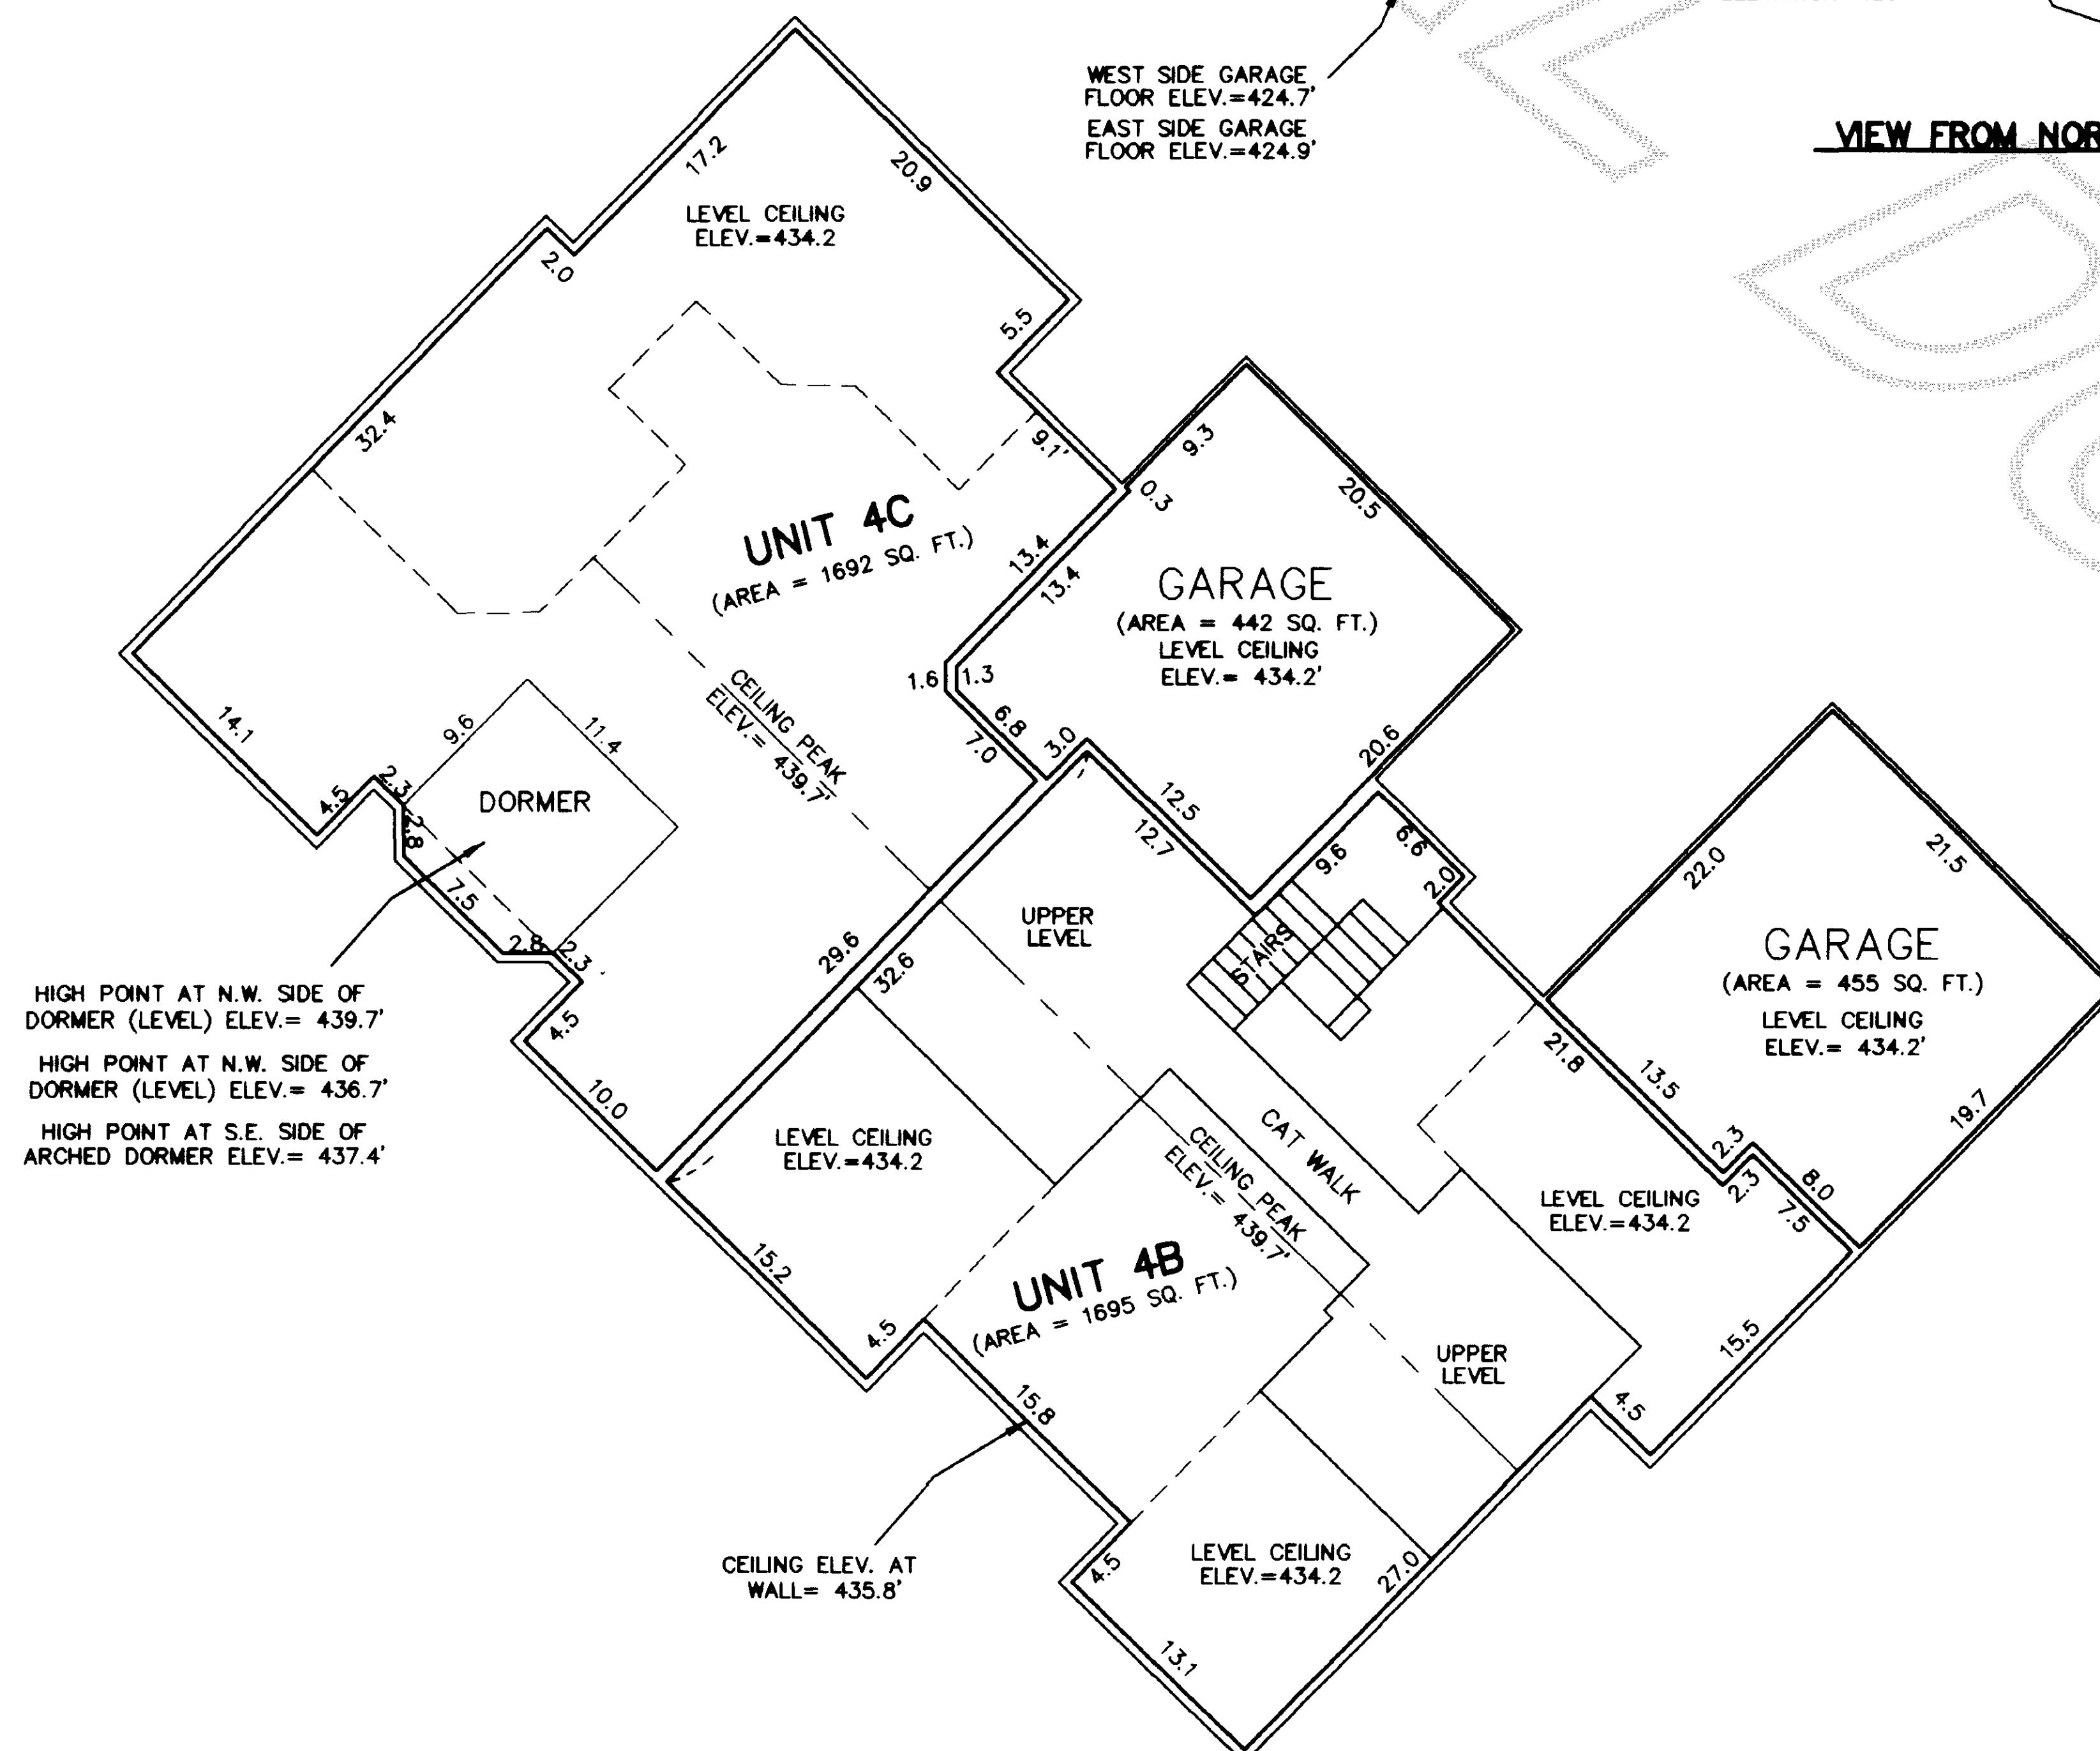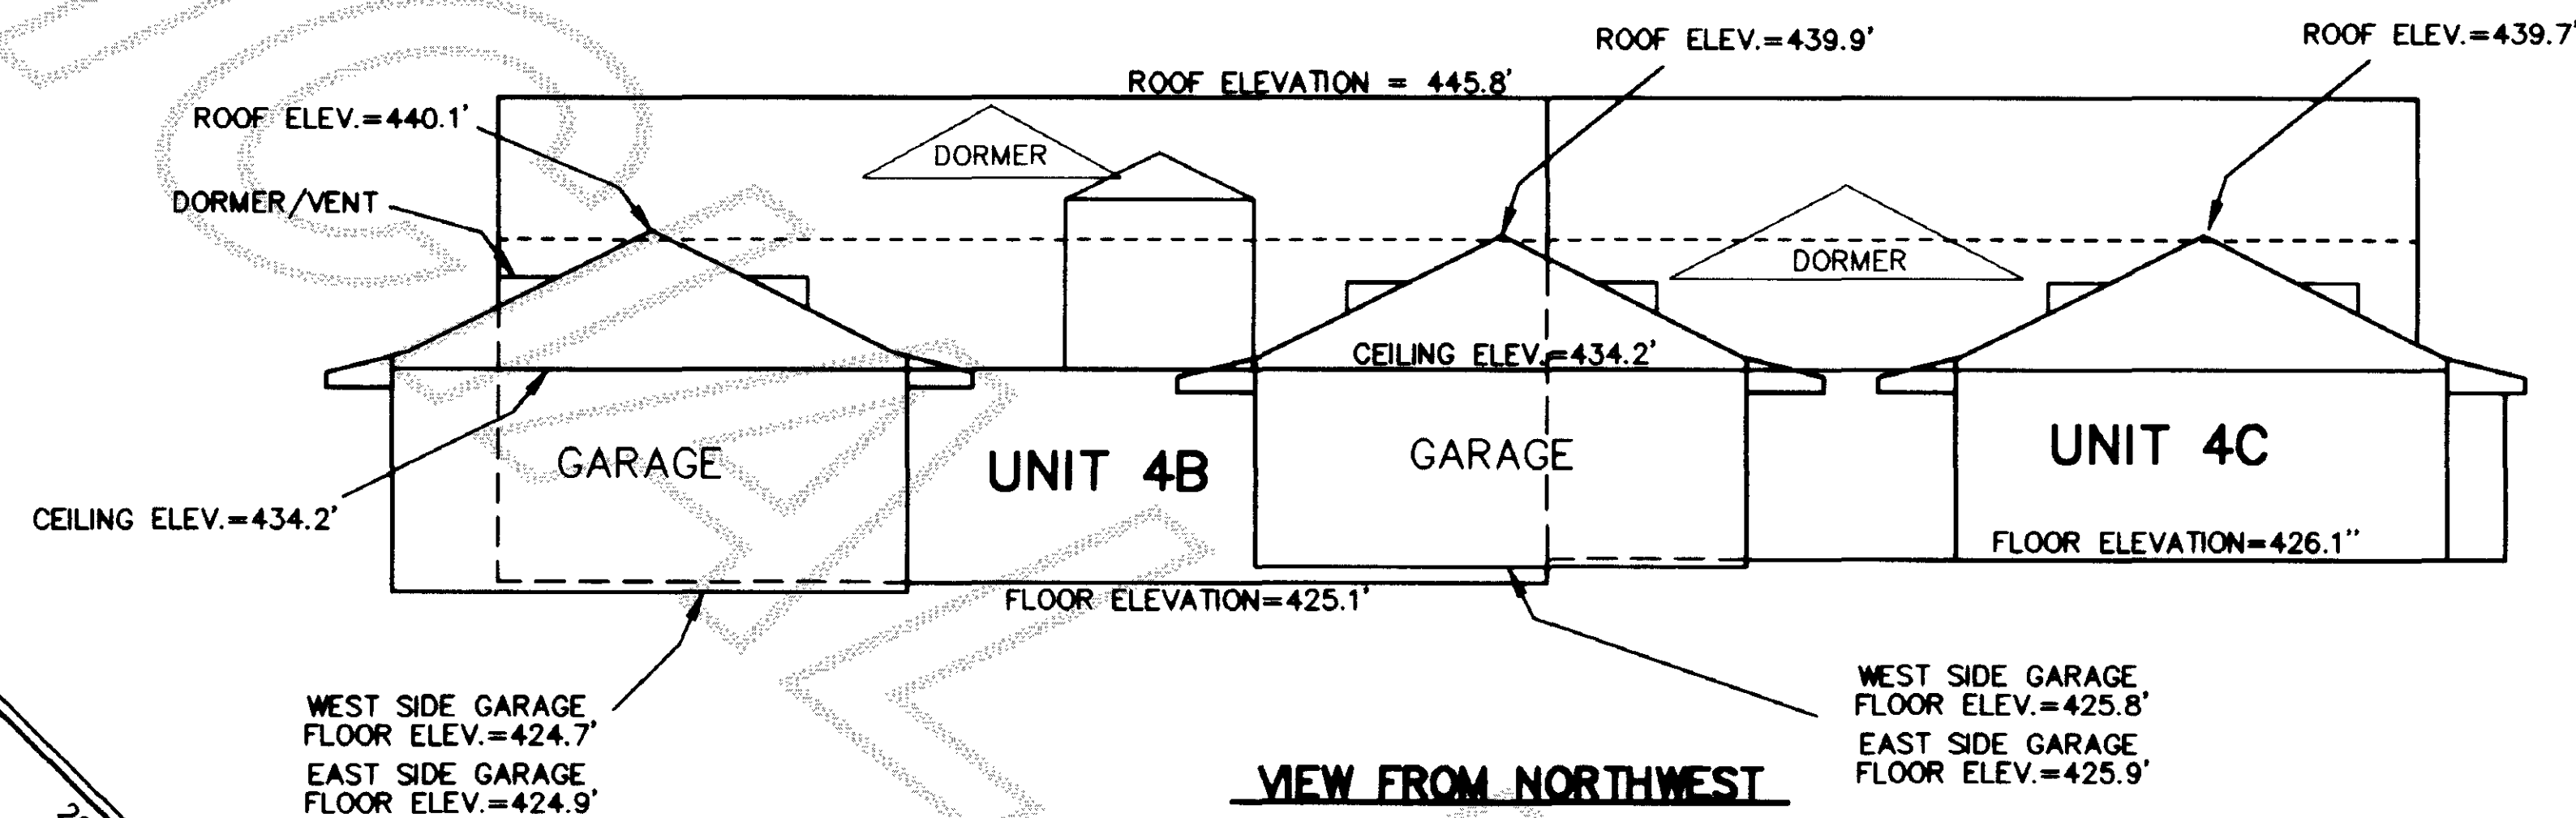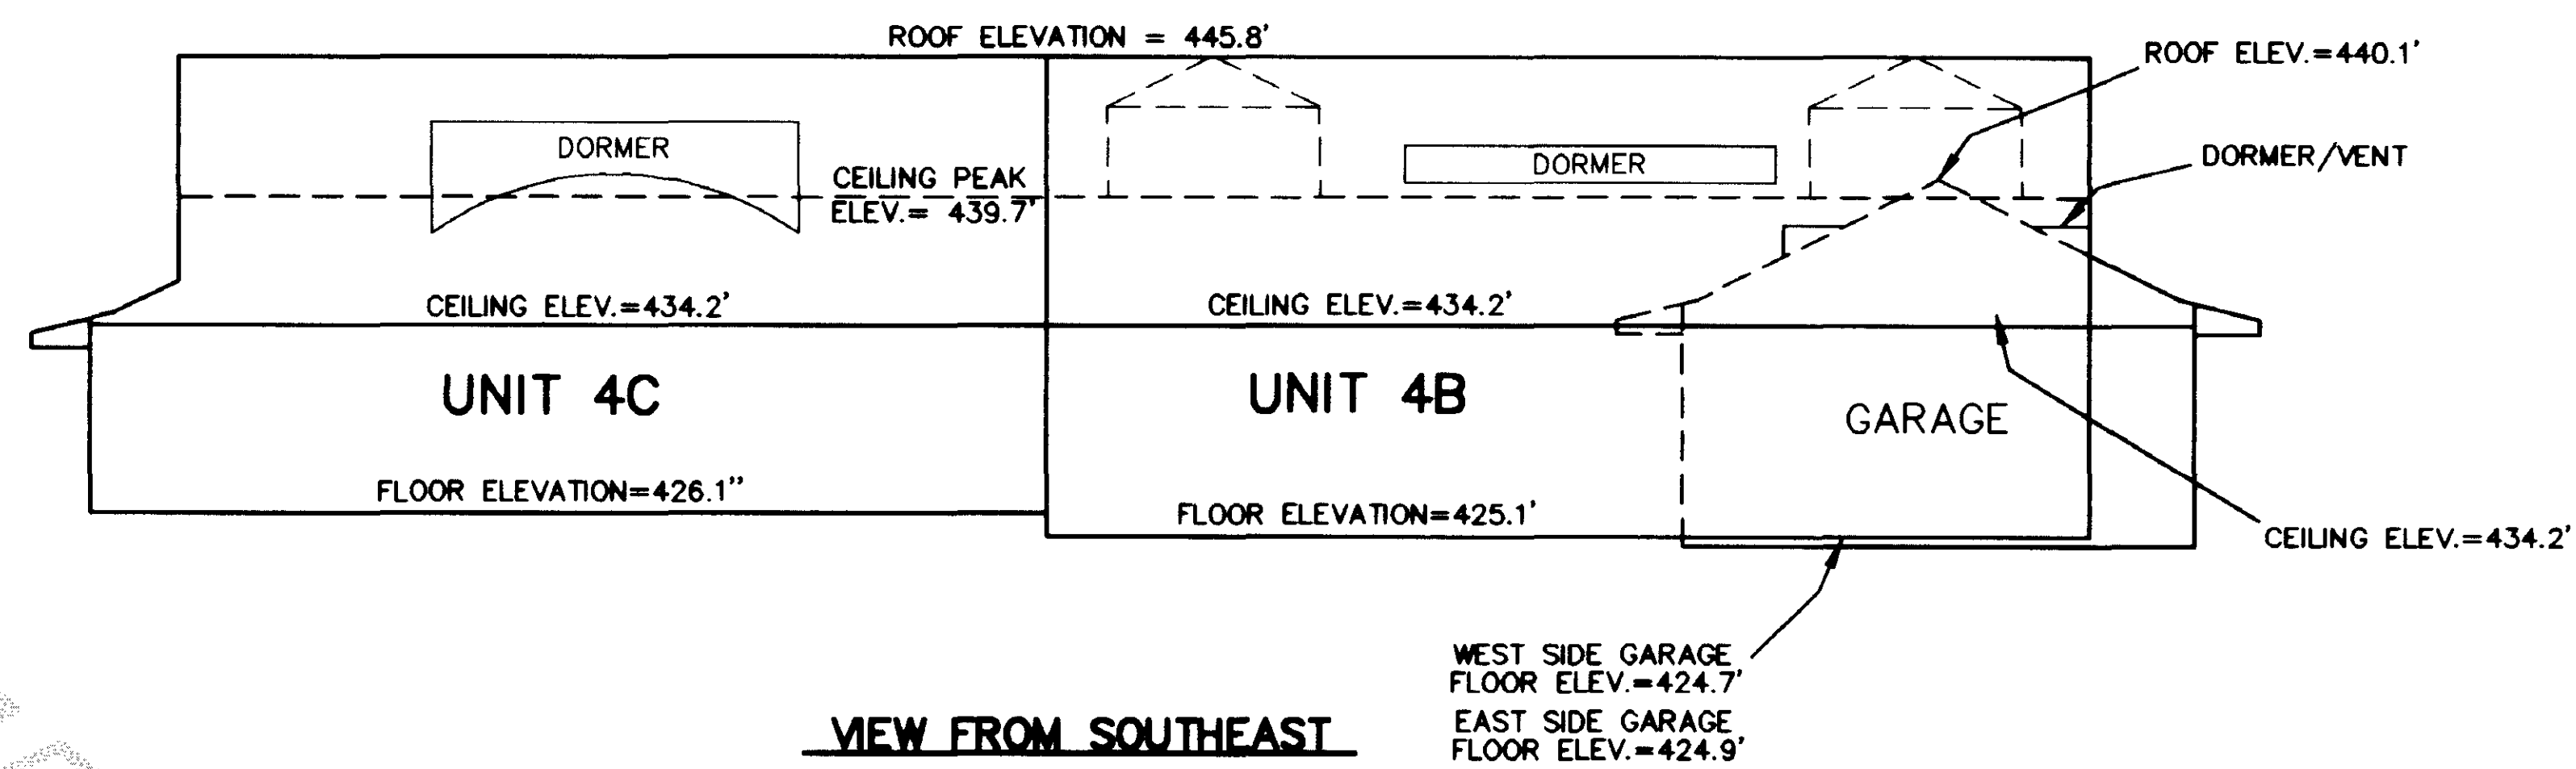

NOTES:


1. FLOOR ELEVATIONS TO SUBSURFACE.
2. CEILING ELEVATIONS TO BOTTOM OF JOIST.
3. UPPER LEVEL FLOOR ELEVATION = 435.2'.

LEGEND


(LCE) = LIMITED COMMON ELEMENT

VERTICAL DATUM:

NGVD 1929

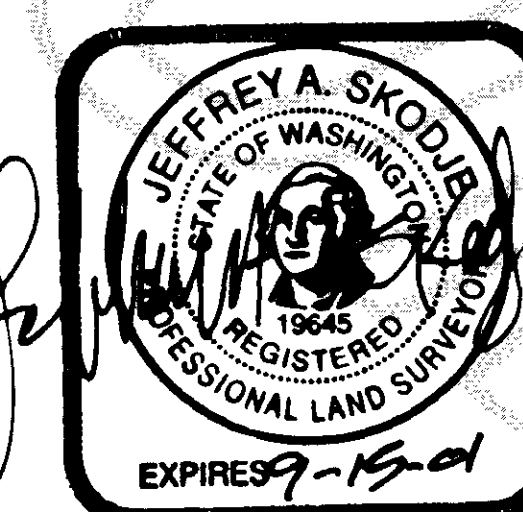

12-2-99

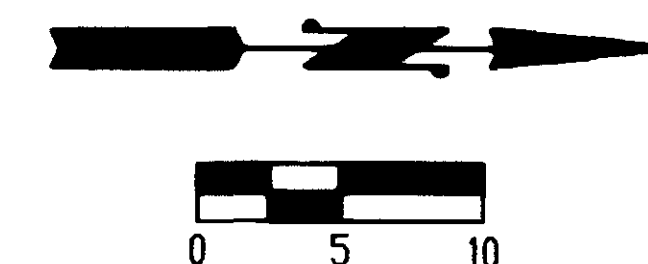

CONDOMINIUM PLANS

SHEET 4 OF 5

DWN BY: JB/ML DATE: OCT. 1999

FIELD BOOK: 586, PGS. 23-25




LEONARD, BOUDINOT and SKODJE, INC.
CIVIL ENGINEERS AND LAND SURVEYORS
603 SOUTH FIRST ST., MOUNT VERNON, WA 98273 (360)336-5751

SCALE: 1" = 10'

JOB NO: 99194

FIRST AMENDMENT TO SURVEY MAP AND PLANS FOR ALPINE FAIRWAY VILLA CONDOMINIUM, PHASE II

199912030104
Kathy Hill, Skagit County Auditor
12/3/1999 Page 6 of 5 3:12:31PM

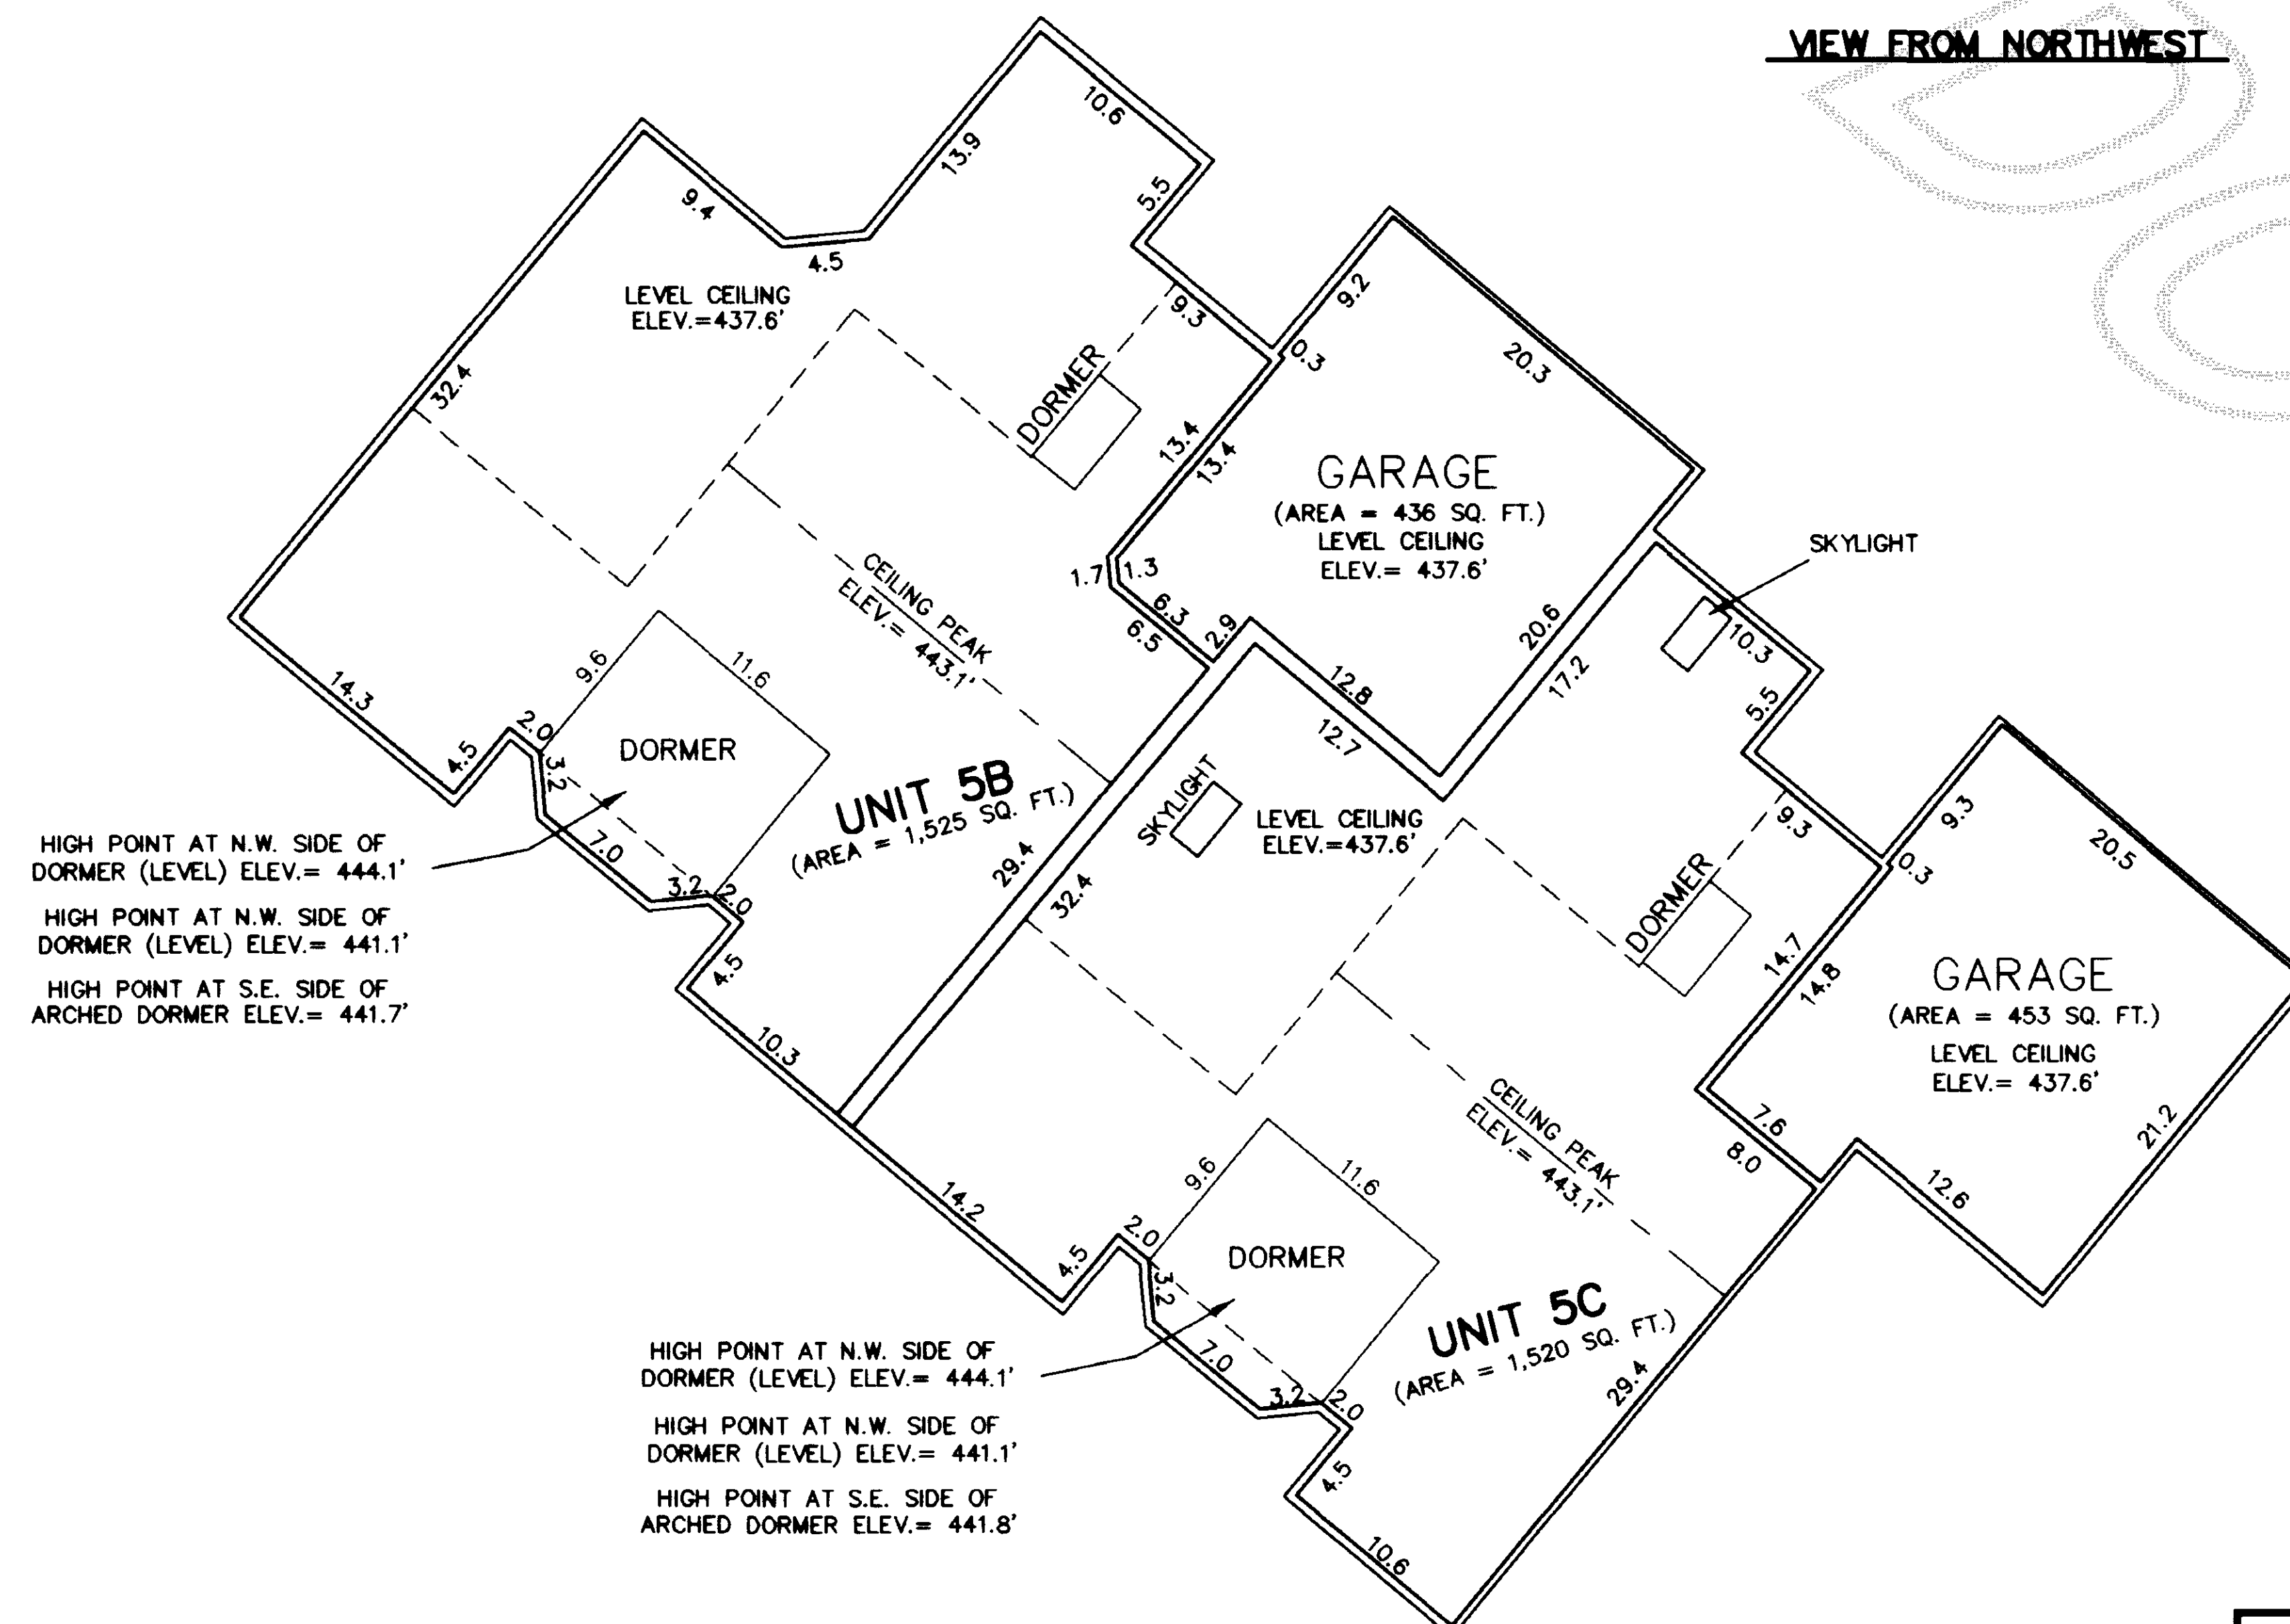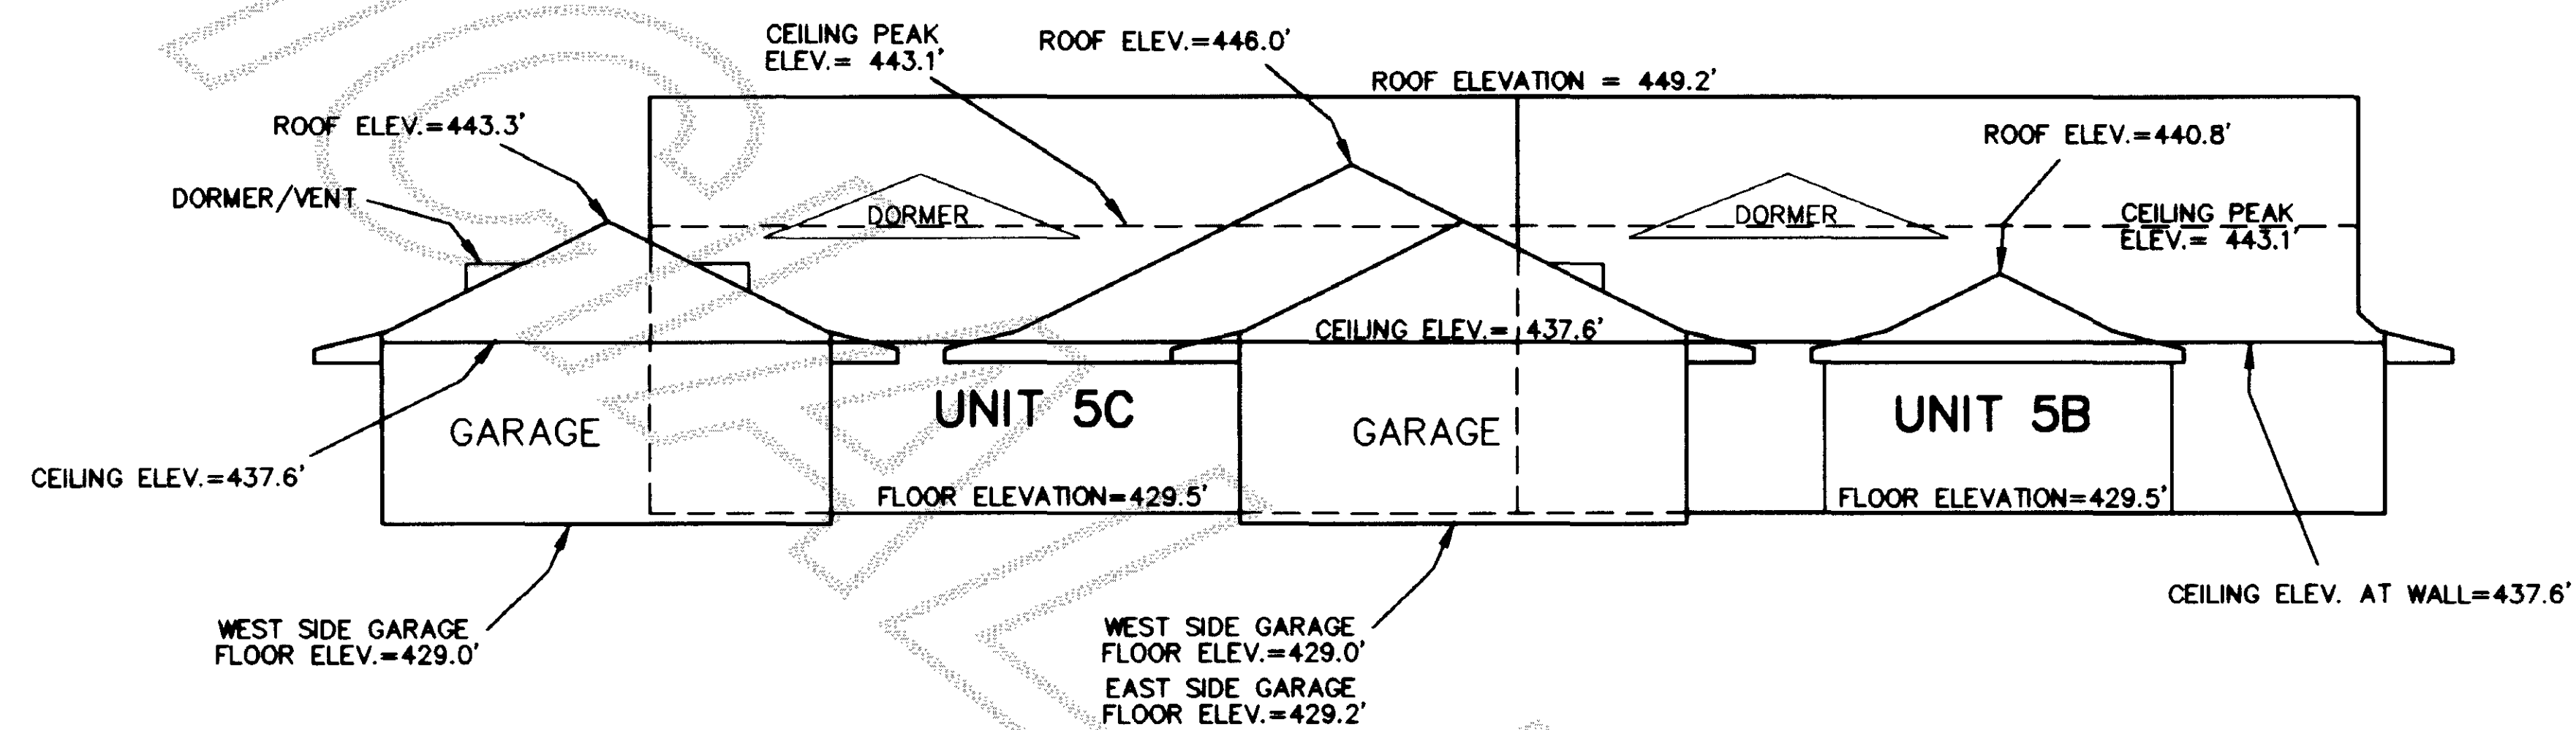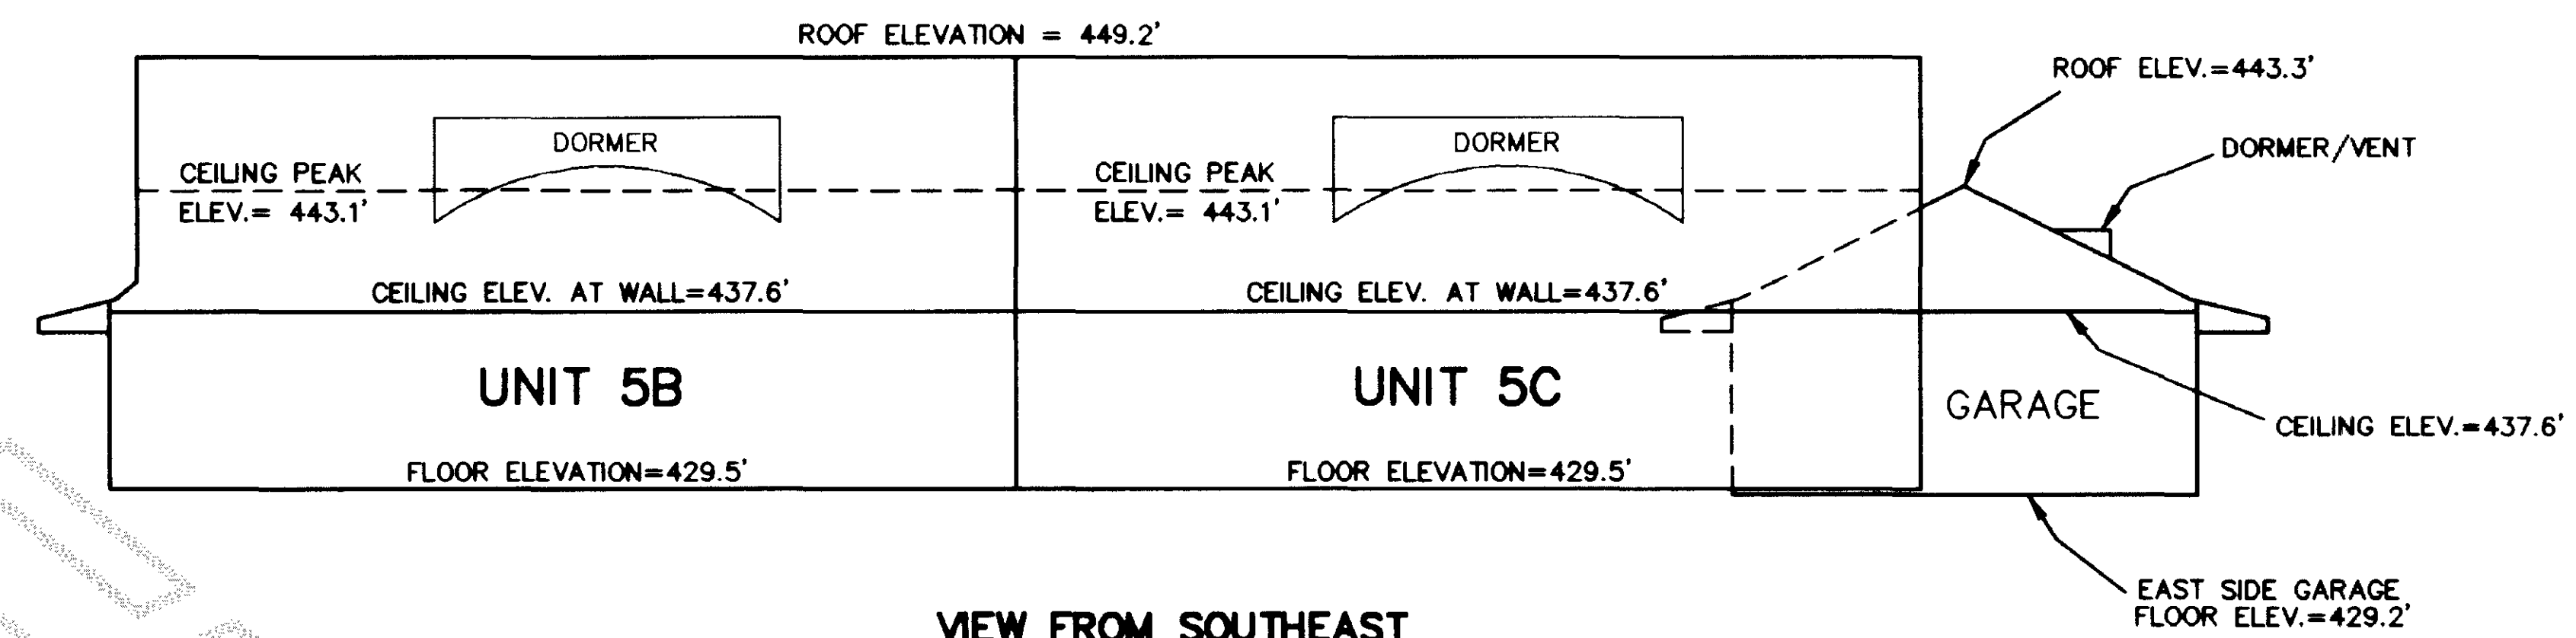

NOTES:


FLOOR ELEVATIONS TO SUBSURFACE.
CEILING ELEVATIONS TO BOTTOM OF JOIST.

LEGEND

(LCE) = LIMITED COMMON ELEMENT

VERTICAL DATUM:

NGVD 1929

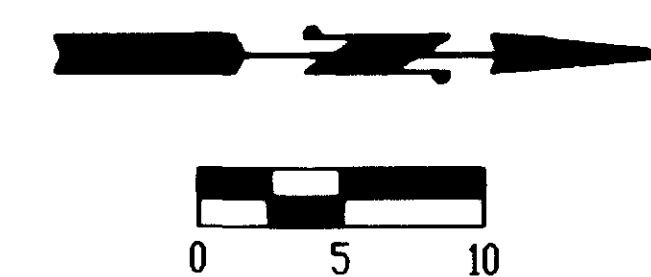

CONDOMINIUM PLANS

SHEET 5 OF 5

DWN BY: JB/ML DATE: OCT. 1999
FIELD BOOK: 586, PGS. 23-25

LEONARD, BOUDINOT and SKODJE, INC.
CIVIL ENGINEERS AND LAND SURVEYORS
603 SOUTH FIRST ST., MOUNT VERNON, WA 98273 (360)336-5751

SCALE: 1" = 10'
JOB NO: 99194