

WESTPOINT CONDOMINIUM

200004200062
Kathy Hill, Skagit County Auditor
4/20/2000 Page 1 of 4 2:14:42PM

DEDICATION

KNOW ALL PERSONS BY THESE PRESENTS THAT WE, THE UNDERSIGNED OWNERS OF "WESTPOINT CONDOMINIUM" IN FEE SIMPLE AND/OR MORTGAGE HOLDERS OF THE PROPERTY HEREBY DESCRIBED, HEREBY DECLARE THIS SURVEY MAP AND PLANS AND DEEDS TO BE THE SAME FOR CONDOMINIUM PURPOSES. THIS SURVEY MAP AND PLANS AND ANY PORTION THEREOF SHALL BE RESTRICTED BY THE TERMS OF THE CONDOMINIUM DECLARATION FILED CONTEMPORANEOUSLY HERewith. THIS DEDICATION IS NOT FOR ANY OTHER USE THAN TO MEET THE REQUIREMENTS OF THE WASHINGTON CONDOMINIUM ACT (RCW 64.34) FOR A SURVEY AND PLANS, AND TO SUBMIT THE PROPERTY TO THE ACT AS PROVIDED IN THE DECLARATION.

[Signature]
FRONTIER BANK
712 C Ave. V.P.
DANIEL R. MITZEL, GENERAL PARTNER
ALLEGRE-MITZEL PARTNERSHIP
A WASHINGTON GENERAL PARTNERSHIP

COUNTY TREASURER'S CERTIFICATE

THIS IS TO CERTIFY THAT ALL TAXES HERETOFORE LEVIED AND WHICH HAVE BECOME A LIEN UPON THE LANDS HEREBY DESCRIBED, HAVE BEEN FULLY PAID AND DISCHARGED ACCORDING TO THE RECORDS OF MY OFFICE, UP TO AND INCLUDING THE YEAR OF 2000.

THIS 18th DAY OF April, 2000
[Signature]
SKAGIT COUNTY TREASURER




DECLARATION REFERENCE

THE DECLARATION PREPARED UNDER THE WASHINGTON CONDOMINIUM ACT FOR THE CONDOMINIUM, TO WHICH THIS SURVEY AND SET OF PLANS REFER, WAS RECORDED WITH THE AUDITOR OF SKAGIT COUNTY, WASHINGTON ON 04/22/00 2002, UNDER AUDITOR'S FILE NO. 200004200062 ON RECORDS OF SKAGIT COUNTY, WASHINGTON.

ACKNOWLEDGMENT FOR SURVEYOR

STATE OF WASHINGTON)
COUNTY OF SKAGIT) SS
I, HEREBY CERTIFY THAT I KNOW OR HAVE SATISFACTORY EVIDENCE THAT JEFFREY A. SKODJE, P.L.S. IS THE PERSON WHO APPEARED BEFORE ME AND SAID PERSON ACKNOWLEDGED THAT HE SIGNED THIS INSTRUMENT, AND HAS ACKNOWLEDGED IT TO BE THE FREE AND VOLUNTARY ACT OF SUCH PERSON FOR THE USES AND PURPOSES IN THIS INSTRUMENT AND IN THE WASHINGTON CONDOMINIUM ACT.

RESIDING AT Sedra-Woolley WA
MY COMMISSION EXPIRES: 11-1-03
DATE: 4/20/00

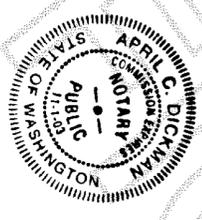

SURVEYOR'S CERTIFICATE

THIS MAP CORRECTLY REPRESENTS A SURVEY MADE BY ME OR UNDER MY DIRECTION IN CONFORMANCE WITH THE REQUIREMENTS OF THE SURVEY RECORDING ACT AT THE REQUEST OF ALAN BUCHANAN.

I HEREBY CERTIFY THAT THIS SURVEY MAP AND PLANS FOR BUCHANAN BEACH CONDOMINIUM ARE BASED ON AN ACTUAL SURVEY OF THE DESCRIBED PROPERTY; THAT THE COURSES AND DISTANCES OF BOUNDARY LINES AND ALL HORIZONTAL AND VERTICAL UNIT BOUNDARIES ARE CORRECTLY SHOWN; AND THAT ALL INFORMATION REQUIRED BY RCW 64.34.237 IS SUPPLIED HEREBY.

[Signature]
JEFFREY A. SKODJE, P.L.S.
CERTIFICATE NO. 19845 DATE 4-20-2000



LEGAL DESCRIPTION

PARCEL "A":
TRACTS 3 AND 4 AS SHOWN ON SURVEY MAP RECORDED FEBRUARY 25, 1983, OF BOOK 4 OF SURVEYS PAGE 85, UNDER AUDITOR'S FILE NO. 8302250027 RECORDS OF SKAGIT COUNTY, WASHINGTON, BEING A PORTION OF THE WEST 1/2 OF THE WEST 1/2 OF GOVERNMENT LOT 2, SECTION 6, TOWNSHIP 34 NORTH, RANGE 4 EAST, W.M.

PARCEL "B":
THAT PORTION OF GOVERNMENT LOT 3, SECTION 6, TOWNSHIP 34 NORTH, RANGE 4 EAST, W.M., DESCRIBED AS FOLLOWS:


BEGINNING AT A POINT ON THE EAST LINE OF SAID GOVERNMENT LOT 3, 186 FEET SOUTH OF THE NORTHEAST CORNER THEREOF; THENCE NORTH 88°42' WEST PARALLEL TO THE NORTH LINE OF SAID LOT 3, 100 FEET; THENCE SOUTH PARALLEL TO THE EAST LINE OF SAID LOT 3 TO THE NORTH RIGHT-OF-WAY LINE OF THE GREAT NORTHERN RAILWAY COMPANY RAILROAD; THENCE NORTH 63°36' EAST ALONG SAID RAILWAY COMPANY'S NORTH RIGHT-OF-WAY LINE TO THE EAST LINE OF SAID LOT 3; THENCE NORTH ALONG THE EAST LINE OF SAID LOT 3, 573.22 FEET, MORE OR LESS, TO THE POINT OF BEGINNING.

EXCEPT THAT PORTION OF GOVERNMENT LOT 3, SECTION 6, TOWNSHIP 34 NORTH, RANGE 4 EAST, W.M. DESCRIBED AS FOLLOWS:
BEGINNING AT A POINT ON THE EAST LINE OF SAID GOVERNMENT LOT 3, SAID POINT LYING SOUTH 0°01'24" EAST, 186.00 FEET FROM THE NORTHEAST CORNER THEREOF; THENCE SOUTH 0°01'24" EAST, ALONG SAID EAST LINE, 5.00 FEET; THENCE NORTH 88°41'40" WEST, PARALLEL WITH THE NORTH LINE OF SAID GOVERNMENT LOT 3, A DISTANCE OF 100.00 FEET; THENCE NORTH 0°01'24" WEST, PARALLEL WITH SAID EAST LINE OF GOVERNMENT LOT 3, A DISTANCE OF 5.00 FEET; THENCE SOUTH 88°41'40" EAST, 100.00 FEET TO THE TRUE POINT OF BEGINNING.

SITUATE IN THE COUNTY OF SKAGIT, STATE OF WASHINGTON.
PARCEL "C":
A NON-EXCLUSIVE EASEMENT FOR INGRESS, EGRESS, AND UTILITIES ESTABLISHED BY THAT CERTAIN QUIT CLAIM DEED RECORDED MARCH 16, 2000, SAID AUDITOR'S FILE NO. 2000031600986 OVER, ACROSS AND UNDER A PORTION OF TRACT 2 OF SURVEY RECORDED IN BOOK 4 OF SURVEYS, PAGE 85, RECORDS OF SKAGIT COUNTY, WASHINGTON, BEING A PORTION OF GOVERNMENT LOT 2 OF SECTION 6, TOWNSHIP 34 NORTH, RANGE 4 EAST, W.M.

OCCUPATIONAL INDICATORS & EXISTING FENCELINE NOTE

THIS SURVEY HAS DEPICTED EXISTING FENCE LINES IN ACCORDANCE WITH W.A.C. CH. 332.130. THESE OCCUPATIONAL INDICATORS MAY INDICATE A POTENTIAL FOR CLAIMS OF UNWRITTEN TITLE OWNERSHIP. THE LEGAL RESOLUTION OF OWNERSHIP BASED UPON UNWRITTEN TITLE CLAIMS HAS NOT BEEN RESOLVED BY THIS BOUNDARY SURVEY.

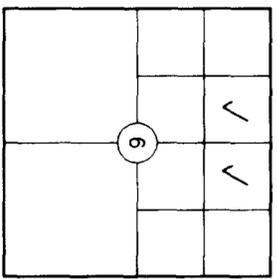

VICINITY MAP
SECTION 6, TWP. 34 N., RGE. 4 E., W.M.

AUDITOR'S CERTIFICATE

FILED FOR RECORD AT THE REQUEST OF LEONARD, BOUDINOT & SKODJE, INC. THIS 20th DAY OF April, 2000, AND RECORDED UNDER AUDITOR'S FILE NO. 200004200062, RECORDS OF SKAGIT COUNTY, WASHINGTON.

[Signature]
Kathy Hill, Skagit County Auditor

ACKNOWLEDGMENT

STATE OF WASHINGTON)
COUNTY OF Skagit) SS

I HEREBY CERTIFY THAT I KNOW OR HAVE SATISFACTORY EVIDENCE THAT DANIEL R. MITZEL IS THE PERSON WHO APPEARED BEFORE ME, AND SAID PERSON ACKNOWLEDGED THAT HE SIGNED THIS INSTRUMENT, ON OATH THAT HE WAS AUTHORIZED TO EXECUTE THE INSTRUMENT AND ACKNOWLEDGED IT AS GENERAL PARTNER OF ALLEGRE-MITZEL PARTNERSHIP, A WASHINGTON GENERAL PARTNERSHIP, TO BE THE FREE AND VOLUNTARY ACT OF SUCH PARTY FOR THE USES AND PURPOSES MENTIONED IN THE INSTRUMENT.

DATED April 17, 2000
[Signature]
NOTARY PUBLIC
RESIDING AT Everett WA
My Comm. Expires 3-15-03



ACKNOWLEDGMENT

STATE OF Washington)
COUNTY OF Skagit) SS

I HEREBY CERTIFY THAT I KNOW OR HAVE SATISFACTORY EVIDENCE THAT Leonard, Boudinot & Skodje, Inc. IS THE PERSON WHO APPEARED BEFORE ME, AND SAID PERSON ACKNOWLEDGED THAT (S)HE SIGNED THIS INSTRUMENT, ON OATH THAT (S)HE WAS AUTHORIZED TO EXECUTE THE INSTRUMENT AND ACKNOWLEDGED IT AS THE Legal Entity OF Frederick Skodje AND PURPOSES MENTIONED IN THE INSTRUMENT.

DATED April 17, 2000
[Signature]
NOTARY PUBLIC
RESIDING AT Everett



NOTES

- FOR FURTHER SURVEY INFORMATION REFER TO SURVEYS RECORDED IN BOOK 4 OF SURVEYS, PAGE 85 AND BOOK 8 OF SURVEYS, PAGE 191, RECORDS OF SKAGIT COUNTY, WASHINGTON.
- UNIT ELEVATION LIMITS:
35.0 FEET ABOVE GROUND LEVEL
10.0 FEET BELOW GROUND LEVEL
- THAT PORTION OF WATERLINE EASEMENT SET FORTH BY INSTRUMENT RECORDED UNDER AUDITOR'S FILE NO. 198908090001, WITHIN THE BOUNDARIES OF THE SUBJECT PARCEL, WAS RELINQUISHED BY INSTRUMENT RECORDED UNDER AUDITOR'S FILE NO. 198908090001.
- PLUG SET SOUND POWER & LIGHT CO. EASEMENT SET FORTH BY INSTRUMENT RECORDED UNDER AUDITOR'S FILE NO. 8305080039 INCLUDES A STRIP OF LAND 7 FEET IN WIDTH LYING PARALLEL AND ADJACENT TO THE 50-FOOT WIDE PRIVATE ROAD (PAULI DRIVE) SHOWN HEREON, AND AS SHOWN ON SURVEY RECORDED IN BOOK 4 OF SURVEYS, PAGE 85, THOSE PORTIONS OF SAID EASEMENT LYING WITHIN THE BOUNDARIES OF THE SUBJECT PARCEL, WERE RELINQUISHED BY INSTRUMENT RECORDED UNDER AUDITOR'S FILE NO. 200004100078.
- PER INSTRUMENT RECORDED UNDER AUDITOR'S FILE NO. 2850, THAT PORTION OF THE SUBJECT PARCEL LYING WITHIN 200 FEET OF THE BURLINGTON NORTHERN RAILWAY CO. RIGHT-OF-WAY IS SUBJECT TO AN EASEMENT TO CUT DOWN DANGEROUS TREES.
- THIS SURVEY WAS PERFORMED IN THE FIELD USING A LEITZ SET 4A ELECTRONIC DISTANCE MEASURING THEODOLITE.
- BAISIS OF BEARING: PER SURVEY RECORDED IN BOOK 8 OF SURVEYS, PAGE 191, RECORDS OF SKAGIT COUNTY, WA, THE BEARING ALONG THE SOUTH BOUNDARY OF THE SUBJECT PARCEL BETWEEN FOUND REBARs, SHOWN HEREON AS SOUTH 63°34'58" WEST.
- VERTICAL DATUM: MEAN SEA LEVEL (NGVD 1929), BASED ON DIFFERENTIAL LEVEL TIES TO CITY OF BURLINGTON BENCHMARK NO. 259, TOP OF 2" IRON PETERSON ROAD, HAVING AN ELEVATION OF 29.63 FEET.
- THAT PORTION OF ACCESS AND UTILITY EASEMENT SET FORTH BY INSTRUMENT RECORDED UNDER AUDITOR'S FILE NO. 8305100034 LYING WITHIN THE BOUNDARIES OF THE SUBJECT PARCEL IS HEREBY RELINQUISHED.
- AN EASEMENT IS HEREBY GRANTED TO ALL UNITS FOR COMMON ELEMENT DUMPER PADS AND USE OF GARBAGE DUMPSTERS LOCATED WITHIN UNITS 22 AND 33 AS SHOWN ON SHEET 2 OF 4.

SURVEY MAP AND PLANS

DWN BY: MAL DATE: FEB. 2000
FIELD BOOK: 572, 584, & 595

LEONARD, BOUDINOT and SKODJE, INC.
CIVIL ENGINEERS AND LAND SURVEYORS
603 SOUTH FIRST ST., MOUNT VERNON, WA 98273 (360) 336-5751

SCALE: -
JOB NO: 97232

WESTPOINT CONDOMINIUM

SET REBAR WITH CAP AT COMPUTED POSITION, LIES 0.3' S. & 1.0' E. OF FENCE CORNER

NOTE: SEE SHEET 3 OF 4 FOR DEPICTION OF EASEMENTS.
NOTE: SEE SHEET 4 OF 4 FOR CONDOMINIUM PHASES NOTE AND DESCRIPTIONS.


TRACT 2
SURVEY BOOK 4,
PAGE 85

SET REBAR WITH CAP 12.0' S. OF FENCELINE & 1.00' S. OF UNIT CORNER


COMMON ELEMENT (PLAY AREA AND ALTERNATE FIRE ACCESS)

FOUND REBAR WITH CAP MARKED 'LS 8992' 1.3' W. OF FENCE CORNER

FOUND REBAR WITH NO CAP AT COMPUTED POSITION, LIES 0.2' S. & 0.6' W. OF FENCE CORNER

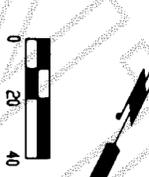

200004200062
Kathy Hill, Skagit County Auditor
4/20/2000 Page 2 of 4 2:14:42PM

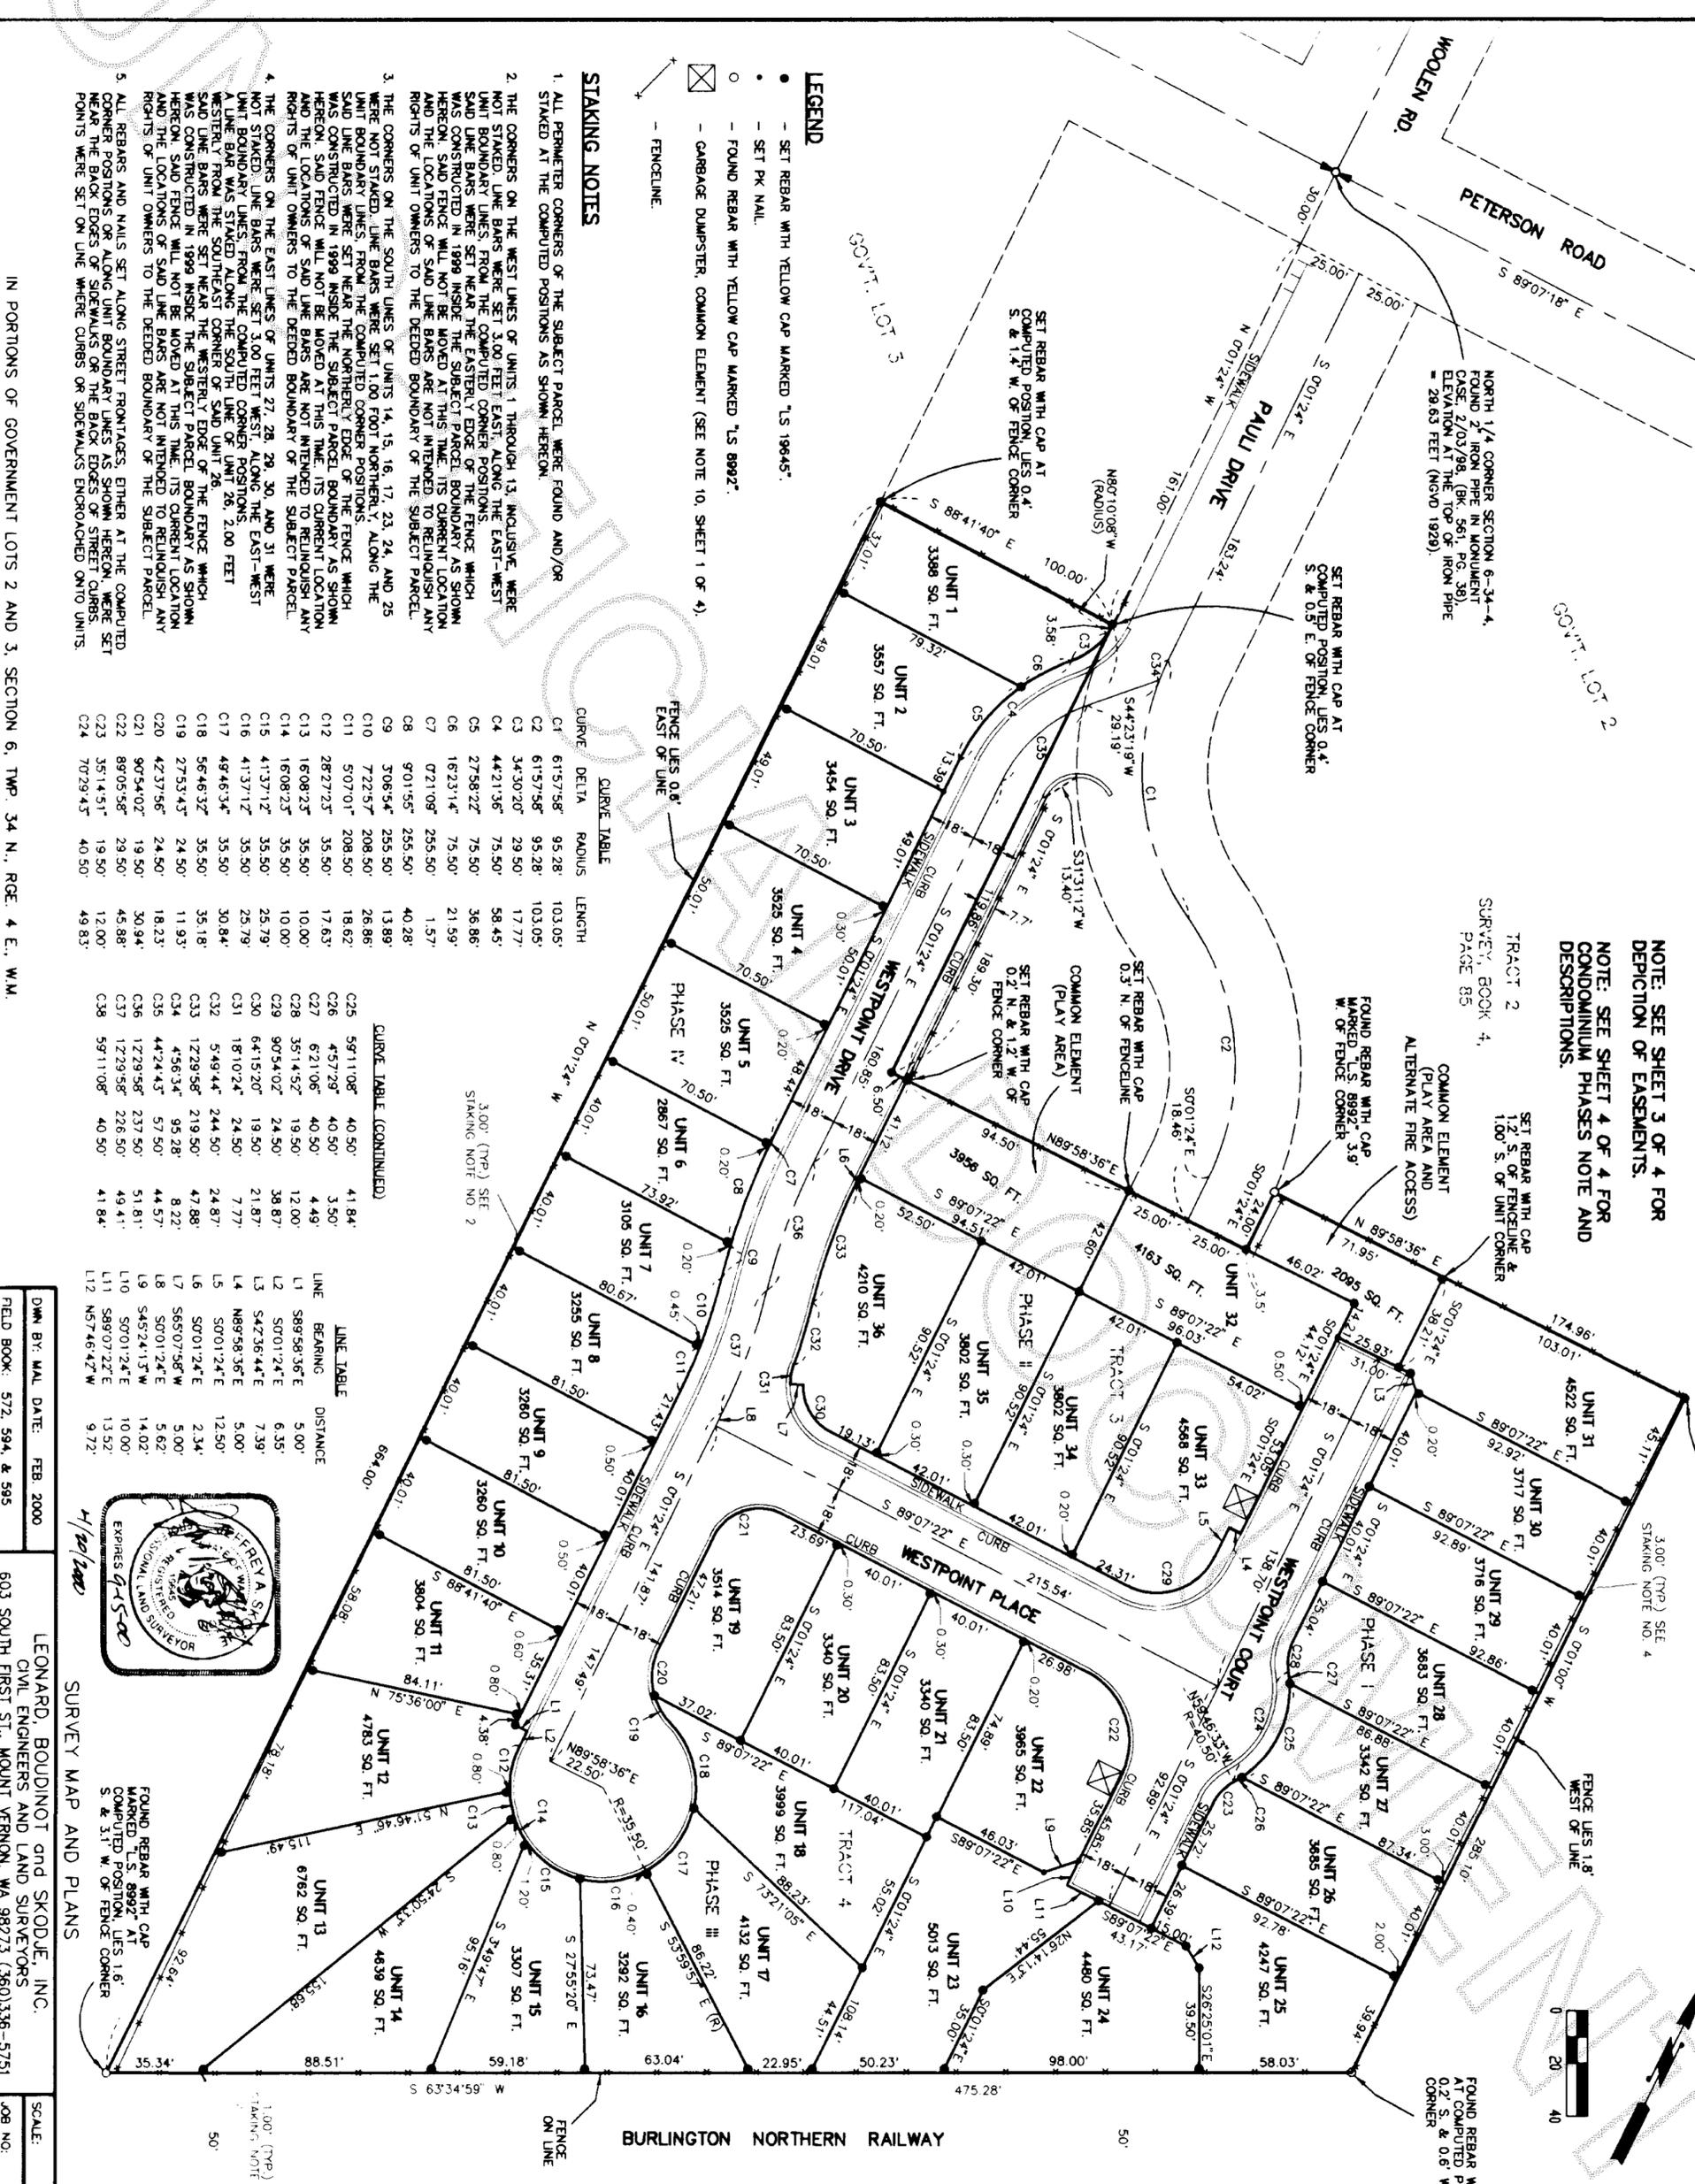

LEGEND

- SET REBAR WITH YELLOW CAP MARKED 'LS 19645'
- SET PK NAIL
- FOUND REBAR WITH YELLOW CAP MARKED 'LS 8992'
- ⊗ GARBAGE DUMPSTER, COMMON ELEMENT (SEE NOTE 10, SHEET 1 OF 4)
- FENCELINE

STAKING NOTES

1. ALL PERMETER CORNERS OF THE SUBJECT PARCEL WERE FOUND AND/OR STAKED AT THE COMPUTED POSITIONS AS SHOWN HEREON.
2. THE CORNERS ON THE WEST LINES OF UNITS 1 THROUGH 13, INCLUSIVE, WERE NOT STAKED. LINE BARS WERE SET 3.00 FEET EAST, ALONG THE EAST-WEST UNIT BOUNDARY LINES, FROM THE COMPUTED CORNER POSITIONS. SAID LINE BARS WERE SET NEAR THE EASTERN EDGE OF THE FENCE WHICH WAS CONSTRUCTED IN 1999 INSIDE THE SUBJECT PARCEL BOUNDARY AS SHOWN HEREON. SAID FENCE WILL NOT BE MOVED AT THIS TIME. ITS CURRENT LOCATION AND THE LOCATIONS OF SAID LINE BARS ARE NOT INTENDED TO RELINQUISH ANY RIGHTS OF UNIT OWNERS TO THE DEEDED BOUNDARY OF THE SUBJECT PARCEL.
3. THE CORNERS ON THE SOUTH LINES OF UNITS 14, 15, 16, 17, 23, 24, AND 25 WERE NOT STAKED. LINE BARS WERE SET 1.00 FOOT NORTHERLY ALONG THE UNIT BOUNDARY LINES, FROM THE COMPUTED CORNER POSITIONS. SAID LINE BARS WERE SET NEAR THE NORTHERLY EDGE OF THE FENCE WHICH WAS CONSTRUCTED IN 1999 INSIDE THE SUBJECT PARCEL BOUNDARY AS SHOWN HEREON. SAID FENCE WILL NOT BE MOVED AT THIS TIME. ITS CURRENT LOCATION AND THE LOCATIONS OF SAID LINE BARS ARE NOT INTENDED TO RELINQUISH ANY RIGHTS OF UNIT OWNERS TO THE DEEDED BOUNDARY OF THE SUBJECT PARCEL.
4. THE CORNERS ON THE EAST LINES OF UNITS 27, 28, 29, 30, AND 31 WERE NOT STAKED. LINE BARS WERE SET 3.00 FEET WEST, ALONG THE EAST-WEST UNIT BOUNDARY LINES, FROM THE COMPUTED CORNER POSITIONS. SAID LINE BARS WERE SET NEAR THE WESTERN EDGE OF THE FENCE WHICH WAS CONSTRUCTED IN 1999 INSIDE THE SUBJECT PARCEL BOUNDARY AS SHOWN HEREON. SAID FENCE WILL NOT BE MOVED AT THIS TIME. ITS CURRENT LOCATION AND THE LOCATIONS OF SAID LINE BARS ARE NOT INTENDED TO RELINQUISH ANY RIGHTS OF UNIT OWNERS TO THE DEEDED BOUNDARY OF THE SUBJECT PARCEL.
5. ALL REBARS AND NAILS SET ALONG STREET FRONTAGES, EITHER AT THE COMPUTED CORNER POSITIONS OR ALONG UNIT BOUNDARY LINES AS SHOWN HEREON, WERE SET NEAR THE BACK EDGES OF SIDEWALKS OR THE BACK EDGES OF STREET CURBS. POINTS WERE SET ON LINE WHERE CURBS OR SIDEWALKS ENDOACHED ONTO UNITS.

CURVE TABLE

CURVE	DELTA	RADIUS	LENGTH
C1	61°57'58"	95.28	103.05'
C2	61°57'58"	95.28	103.05'
C3	34°30'20"	29.50	17.77'
C4	44°21'36"	75.50	58.45'
C5	27°58'22"	75.50	36.86'
C6	16°23'14"	75.50	21.59'
C7	02°19'08"	255.50	1.57'
C8	9°01'55"	255.50	40.28'
C9	3°08'54"	255.50	13.89'
C10	7°22'57"	208.50	26.86'
C11	5°07'01"	208.50	18.62'
C12	28°27'25"	35.50	17.63'
C13	16°08'25"	35.50	10.00'
C14	16°08'25"	35.50	10.00'
C15	41°37'12"	35.50	25.79'
C16	41°37'12"	35.50	25.79'
C17	49°46'34"	35.50	30.84'
C18	56°46'32"	35.50	35.18'
C19	27°53'45"	24.50	11.93'
C20	42°37'56"	24.50	18.23'
C21	90°54'02"	19.50	50.94'
C22	89°05'58"	29.50	45.88'
C23	35°14'51"	19.50	12.00'
C24	70°29'45"	40.50	49.83'

CURVE TABLE (CONTINUED)

C25	58°11'08"	40.50	41.84'
C26	4°57'29"	40.50	3.50'
C27	6°21'06"	40.50	4.49'
C28	35°14'52"	19.50	12.00'
C29	90°54'02"	24.50	38.87'
C30	64°15'20"	19.50	21.87'
C31	18°10'24"	24.50	7.77'
C32	5°49'44"	244.50	24.87'
C33	12°29'58"	219.50	47.88'
C34	4°56'34"	95.28	8.22'
C35	44°24'45"	57.50	44.57'
C36	12°29'58"	237.50	51.81'
C37	12°29'58"	226.50	49.41'
C38	58°11'08"	40.50	41.84'

LINE TABLE

LINE	BEARING	DISTANCE
L1	S89°58'36"E	5.00'
L2	S07°01'24"E	6.35'
L3	S42°36'44"E	7.39'
L4	N89°58'36"E	5.00'
L5	S07°01'24"E	12.50'
L6	S07°01'24"E	2.34'
L7	S65°07'58"W	5.00'
L8	S07°01'24"E	5.62'
L9	S45°24'15"W	14.02'
L10	S07°01'24"E	10.00'
L11	S89°07'22"E	13.52'
L12	N57°46'42"W	9.72'

IN PORTIONS OF GOVERNMENT LOTS 2 AND 3, SECTION 6, TWP. 34 N., RGE. 4 E., W.M.



LEONARD, BOUDINOT and SKODJE, INC.
CIVIL ENGINEERS AND LAND SURVEYORS
603 SOUTH FIRST ST., MOUNT VERNON, WA 98273 (360) 336-5751

SURVEY MAP AND PLANS

DATE: FEB 2000
FIELD BOOK: 572, 594, & 595

SCALE: 1"=40'
JOB NO.: 97232

2 OF 4

WESTPOINT CONDOMINIUM

200004200062
Kathy Hill, Skagit County Auditor
4/20/2000 Page 4 of 4 2:14:42PM

LEGAL DESCRIPTION FOR: PHASE I

THOSE PORTIONS OF TRACT 3 AND TRACT 4 AS SHOWN ON SURVEY RECORDED IN BOOK 4 OF SURVEYS AT PAGE 85, RECORDS OF SKAGIT COUNTY, WASHINGTON, UNDER AUDITOR'S FILE NO. 8302250027, BEING IN A PORTION OF GOVERNMENT LOT 2, SECTION 6, TOWNSHIP 34 NORTH, RANGE 4 EAST, W.M., DESCRIBED AS FOLLOWS:

BEGINNING AT THE NORTHEAST CORNER OF SAID TRACT 3; THENCE SOUTH 0° 01' 00" WEST ALONG THE EAST LINE OF SAID TRACT 3 AND SAID TRACT 4, A DISTANCE OF 285.10 FEET TO THE SOUTHEAST CORNER OF SAID TRACT 4; THENCE SOUTH 63° 34' 59" WEST ALONG THE SOUTH LINE OF SAID TRACT 4, A DISTANCE OF 208.28 FEET; THENCE NORTH 0° 01' 24" WEST 183.03 FEET; THENCE SOUTH 89° 07' 22" EAST 38.98 FEET TO THE BEGINNING OF A CURVE TO THE RIGHT HAVING A RADIUS OF 28.50 FEET; THENCE SOUTHERLY ALONG THE ARC OF SAID CURVE TO THE RIGHT THROUGH CENTRAL ANGLE OF 89° 05' 58" AN ARC DISTANCE OF 45.88 FEET; THENCE SOUTH 0° 01' 24" EAST 45.88 FEET; THENCE SOUTH 89° 22' 51" WEST 36.00 FEET; THENCE NORTH 0° 01' 24" WEST 183.03 FEET TO THE BEGINNING OF A CURVE TO THE RIGHT HAVING A RADIUS OF 18.50 FEET; THENCE NORTHERLY ALONG THE ARC OF SAID CURVE TO THE RIGHT THROUGH CENTRAL ANGLE OF 51° 51' AN ARC DISTANCE OF 12.00 FEET; TO THE BEGINNING OF A CURVE TO THE LEFT HAVING A RADIUS OF 40.30 FEET; THENCE NORTHERLY ALONG THE ARC OF SAID CURVE TO THE LEFT THROUGH A CENTRAL ANGLE OF 70° 29' 43" AN ARC DISTANCE OF 49.83 FEET TO THE BEGINNING OF A CURVE TO THE RIGHT HAVING A RADIUS OF 18.50 FEET; THENCE NORTHERLY ALONG THE ARC OF SAID CURVE TO THE RIGHT THROUGH A CENTRAL ANGLE OF 35° 14' 52" AN ARC DISTANCE OF 12.00 FEET; THENCE NORTH 0° 01' 24" WEST 105.06 FEET; THENCE NORTH 42° 38' 44" WEST 7.39 FEET; THENCE SOUTH 89° 58' 36" WEST 1.0301 FEET FROM THE POINT OF BEGINNING; THENCE NORTH 89° 58' 36" EAST, ALONG SAID NORTH LINE, 103.01 FEET TO THE POINT OF BEGINNING.

LEGAL DESCRIPTION FOR: PHASE III
THOSE PORTIONS OF GOVERNMENT LOT 3 AND TRACT 4 LYING WITHIN A EAST GOVERNMENT LOT 2, ALL OF SECTION 6, TOWNSHIP 34 NORTH, RANGE 4 EAST, W.M., AS SHOWN ON SURVEY RECORDED IN BOOK 4 OF SURVEYS AT PAGE 85, RECORDS OF SKAGIT COUNTY, WASHINGTON, UNDER AUDITOR'S FILE NO. 8302250027, DESCRIBED AS FOLLOWS:
COMMENCING AT THE SOUTHEAST CORNER OF SAID TRACT 4; THENCE SOUTH 63° 34' 59" WEST ALONG THE SOUTH LINE OF SAID TRACT 208.28 FEET TO THE TRUE POINT OF BEGINNING; THENCE CONTINUING SOUTH 63° 34' 59" WEST ALONG SAID SOUTH LINE, A DISTANCE OF 187.41 FEET TO THE SOUTHWEST CORNER OF SAID TRACT; THENCE CONTINUING SOUTH 63° 34' 59" WEST 111.61 FEET; THENCE NORTH 0° 01' 24" WEST 228.90 FEET; THENCE SOUTH 89° 41' 40" EAST 38.98 FEET; THENCE SOUTH 0° 01' 24" EAST 38.98 FEET TO THE BEGINNING OF A CURVE TO THE LEFT HAVING A RADIUS OF 28.50 FEET; THENCE SOUTHERLY ALONG THE ARC OF SAID CURVE TO THE LEFT THROUGH A CENTRAL ANGLE OF 89° 05' 58" AN ARC DISTANCE OF 45.88 FEET; THENCE SOUTH 89° 22' 51" WEST 36.00 FEET; THENCE NORTH 0° 01' 24" WEST 183.03 FEET TO THE BEGINNING OF A CURVE TO THE RIGHT HAVING A RADIUS OF 18.50 FEET; THENCE NORTHERLY ALONG THE ARC OF SAID CURVE TO THE RIGHT THROUGH A CENTRAL ANGLE OF 51° 51' AN ARC DISTANCE OF 12.00 FEET; TO THE BEGINNING OF A CURVE TO THE LEFT HAVING A RADIUS OF 40.30 FEET; THENCE NORTHERLY ALONG THE ARC OF SAID CURVE TO THE LEFT THROUGH A CENTRAL ANGLE OF 70° 29' 43" AN ARC DISTANCE OF 49.83 FEET; THENCE NORTHERLY ALONG THE ARC OF SAID CURVE TO THE RIGHT THROUGH A CENTRAL ANGLE OF 35° 14' 52" AN ARC DISTANCE OF 12.00 FEET; THENCE NORTH 0° 01' 24" WEST 105.06 FEET; THENCE NORTH 42° 38' 44" WEST 7.39 FEET; THENCE SOUTH 89° 58' 36" WEST 1.0301 FEET TO A POINT WHICH LIES NORTH 0° 01' 24' WEST, 183.03 FEET FROM THE TRUE POINT OF BEGINNING; THENCE SOUTH 0° 01' 24' EAST, 183.03 FEET TO THE TRUE POINT OF BEGINNING.

LEGAL DESCRIPTION FOR: PHASE II

THOSE PORTIONS OF TRACT 3 AND TRACT 4 AS SHOWN ON SURVEY RECORDED IN BOOK 4 OF SURVEYS AT PAGE 85, RECORDS OF SKAGIT COUNTY, WASHINGTON, UNDER AUDITOR'S FILE NO. 8302250027, BEING IN A PORTION OF GOVERNMENT LOT 2, SECTION 6, TOWNSHIP 34 NORTH, RANGE 4 EAST, W.M., DESCRIBED AS FOLLOWS:

COMMENCING AT THE NORTHEAST CORNER OF SAID TRACT 3; THENCE SOUTH 89° 58' 36" WEST, ALONG THE NORTH LINE OF SAID TRACT 3, A DISTANCE OF 174.96 FEET TO AN ANGLE POINT IN SAID TRACT 3; THENCE SOUTH 0° 01' 24" WEST, ALONG THE WEST LINE OF SAID TRACT 3, A DISTANCE OF 24.00 FEET TO AN ANGLE POINT IN SAID TRACT 3; THE POINT OF BEGINNING; THENCE SOUTH 89° 58' 36" WEST, ALONG THE NORTH LINE OF SAID TRACT 3, A DISTANCE OF 50.00 FEET TO A POINT ON THE WEST MARGIN OF PAUL DRIVE AS SHOWN ON SAID SURVEY; THENCE SOUTH 89° 07' 22" WEST, ALONG SAID WEST MARGIN, 42.60 FEET; THENCE NORTH 89° 07' 22" WEST, 94.51 FEET; THENCE SOUTH 0° 01' 24" EAST, 2.34 FEET TO THE BEGINNING OF A CURVE TO THE LEFT HAVING A RADIUS OF 219.50 FEET; THENCE SOUTHERLY ALONG THE ARC OF SAID CURVE TO THE LEFT THROUGH A CENTRAL ANGLE OF 12° 29' 58" AN ARC DISTANCE OF 47.88 FEET TO THE BEGINNING OF A CURVE TO THE RIGHT, HAVING A RADIUS OF 244.50 FEET; THENCE SOUTHERLY, ALONG THE ARC OF SAID CURVE TO THE RIGHT, THROUGH A CENTRAL ANGLE OF 5° 49' 44" AN ARC DISTANCE OF 24.87 FEET TO THE BEGINNING OF A CURVE TO THE LEFT, HAVING A RADIUS OF 24.50 FEET; THENCE SOUTHERLY, ALONG THE ARC OF SAID CURVE TO THE LEFT, THROUGH A CENTRAL ANGLE OF 18° 10' 24", AN ARC DISTANCE OF 7.77 FEET; THENCE NORTH 89° 07' 58" EAST, 5.00 FEET TO THE BEGINNING OF A NON-TANGENT CURVE TO THE LEFT, HAVING A RADIUS POINT WHICH BEARS NORTH 65° 07' 58" EAST, 19.50 FEET; THENCE EASTERLY ALONG THE ARC OF SAID CURVE TO THE LEFT, THROUGH A CENTRAL ANGLE OF 64° 15' 20", AN ARC DISTANCE OF 21.87 FEET; THENCE SOUTH 89° 07' 22" EAST, 127.46 FEET TO THE BEGINNING OF A CURVE TO THE LEFT, HAVING A RADIUS OF 24.50 FEET; THENCE NORTHERLY, ALONG THE ARC OF SAID CURVE TO THE LEFT, THROUGH A CENTRAL ANGLE OF 90° 54' 02", AN ARC DISTANCE OF 38.87 FEET; THENCE NORTH 0° 01' 24" WEST, 12.50 FEET; THENCE NORTH 89° 58' 36" EAST, 5.00 FEET; THENCE NORTH 0° 01' 24" WEST, 97.17 FEET TO A POINT WHICH LIES NORTH 89° 58' 36" EAST, 46.02 FEET FROM THE TRUE POINT OF BEGINNING; THENCE NORTH 89° 58' 36" WEST, 46.02 FEET TO THE TRUE POINT OF BEGINNING.

LEGAL DESCRIPTION FOR: PHASE IV
THAT PORTION OF GOVERNMENT LOT 3 OF SECTION 6, TOWNSHIP 34 NORTH, RANGE 4 EAST, W.M., DESCRIBED AS FOLLOWS:
COMMENCING AT THE SOUTHWEST CORNER OF TRACT 4 AS SHOWN ON SURVEY RECORDED IN BOOK 4 OF SURVEYS AT PAGE 85, RECORDS OF SKAGIT COUNTY, WASHINGTON, UNDER AUDITOR'S FILE NO. 8302250027; THENCE SOUTH 63° 34' 59" WEST, ALONG THE WESTERLY EXTENSION OF THE SOUTH LINE OF SAID TRACT 4, A DISTANCE OF 111.61 FEET; THENCE NORTH 0° 01' 24" WEST, 228.90 FEET TO THE TRUE POINT OF BEGINNING; THENCE SOUTH 89° 41' 40" EAST, 38.98 FEET; THENCE SOUTH 0° 01' 24" WEST, 101.45 FEET TO THE BEGINNING OF A CURVE TO THE LEFT, HAVING A RADIUS OF 208.50 FEET; THENCE NORTHERLY ALONG THE ARC OF SAID CURVE TO THE LEFT, THROUGH A CENTRAL ANGLE OF 34° 30' AN ARC DISTANCE OF 17.77 FEET TO A POINT ON THE EAST LINE OF SAID GOVERNMENT LOT 3, WHICH LIES SOUTH 0° 01' 24" EAST, 194.58 FEET FROM THE NORTHEAST CORNER OF SAID GOVERNMENT LOT; THENCE NORTH 0° 01' 24" WEST, ALONG SAID EAST LINE, 3.58 FEET; THENCE NORTH 89° 41' 40" WEST, 100.00 FEET TO A POINT WHICH LIES NORTH 0° 01' 24" WEST, 435.10 FEET FROM THE TRUE POINT OF BEGINNING; THENCE SOUTH 0° 01' 24" EAST, 435.10 FEET TO THE TRUE POINT OF BEGINNING.

CONDOMINIUM PHASES NOTE

- PHASE I INCLUDES UNITS 22, 23, 24, 25, 26, 27, 28, 29, 30, AND 31.
- PHASE II INCLUDES UNITS 32, 33, 34, 35, AND 36.
- PHASE III INCLUDES UNITS 11, 12, 13, 14, 15, 16, 17, 18, 19, 20, AND 21.
- PHASE IV INCLUDES UNITS 1, 2, 3, 4, 5, 6, 7, 8, 9, AND 10.



SURVEY MAP AND PLANS
(DESCRIPTIONS OF CONDOMINIUM PHASES) 4 OF 4

IN PORTIONS OF GOVERNMENT LOTS 2 AND 3, SECTION 6, TWP. 34 N., RGE. 4 E., W.M.

OWN BY: MAL	DATE: FEB 2000	LEONARD, BOUDINOT and SKODJE, INC.	SCALE:
FIELD BOOK: 572, 594, & 595		CIVIL ENGINEERS AND LAND SURVEYORS	JOB NO: 97232
		603 SOUTH FIRST ST., MOUNT VERNON, WA 98273 (360)336-5751	