世 尺

CONDOMINIUM

I I I **NORTHWEST** ANACORTES, SHEEET 유 SECTION WASHINGTON 1 OF 3 __ 24, 꼬 **≪**.**M**

Z

LEGAL DESCRIPTION

PARCEL **>**

FRACTIONAL LOT 1, LOTS 2 THROUGH 6, INCLUSIVE, BLOCK 187, CITY OF ANACORTES, ACCORDING TO THE PLAT THEREOF, RECORDED IN VOLUME 2 OF PLATS, PAGE 4, RECORDS OF SKAGIT COUNTY, WASHINGTON.

PARCEL B:

LOTS 1 THROUGH 10, INCLUSIVE, BLOCK 188, CITY OF ANACORTES, ACCORDING TO THE PLAT THEREOF, RECORDED IN VOLUME 2 OF PLATS, PAGE 4, RECORDS OF SKAGIT COUNTY, WASHINGTON.

ALL SITUATED IN SKAGIT COUNTY, WASHINGTON.

NOTES

- INSTRUMENTATION LEICA TCA 1105 THEODOLITE DISTANCE METER SURVEY PROCEDURE: STANDARD FIELD TRAVERSE MERIDIAN: ASSUMED BASIS OF BEARING: MONUMENTS FOUND ALONG THE CENTERLINE

- 4. BASIS OF BEARING: MONUMENTS FOUND ALONG THE CENTERLINE
 OF "D" AVENUE AT 21ST STREET AND AT 17TH STREET.
 BEARING = NORTH 00"34"45" EAST.
 5. FOR ADDITIONAL MERIDIAN AND SURVEY INFORMATION SEE SURVEY RECORDED AUDITOR'S FILE NO. 200411230172, RECORDS OF SKAGIT COUNTY, WASHINGTON. UNDER
- DATUM: NGVD' 29.

 ALL UNITS INCLUDE THE EXISTING BUILDING, OR BUILDING TO BE BUILT, AS REFERENCED IN ALL UNITS INCLUDE THE EXISTING BUILDING, OR BUILDING TO BE BUILT, AS REFERENCED IN ALL UNITS INCLUDE THE WITH THE SURROUNDINGS LAND SHOWN HEREON. THE VERTICAL INTO AN ELEVATION, TOGETHER WITH THE SURVEY OF 60 FEET, NGVD'29 (MEAN SEA LEVEL), TO AN ELEVATION OF 160 FEET, NGVD'29.

 UTILITY LOCATIONS ARE SHOWN ON SHEET 3 OF 3.

 THE DESCRIPTION FOR THIS SURVEY IS FROM CHICAGO TITLE COMPANY POLICY NO. C28484, TED SEPTEMBER 3, 2003.

 THIS SURVEY HAS SHOWN OCCUPATIONAL INDICATORS AS PER W.A.C. CHAPTER 332.130.

 VIES OF OCCUPATION MAY INDICATE AREAS FOR POTENTIAL CLAIMS OF UNWRITTEN OWNERSHIP. THIS WIERSHIP. THIS BOUNDARY SURVEY HAS POTENTIAL CLAIMS OF UNWRITTEN OWNERSHIP. THIS
- 3, 2003.
 3, 2003.
 3, 2003.
 3,
- BJECT TO EASEMENTS, RESERVATIONS, OTHER INSTRUMENTS OF RECORD.

EASEMENTS

AN EASEMENT IS HEREBY RESERVED FOR AND SOUND ENERGY, G.T.E., CASCADE NATURAL GA SUCCESSORS AND ASSIGNS UNDER AND UPON ALONG THE ROUTES OF THE AS BUILT OR YET TO INSTALL, LAY, CONSTRUCT, RENEW OPERATION INSTALL, LAY, CONSTRUCT, RENEW OPERATION ES FIXTURES, AND APPURTENANCES ATTACHUTILITY SERVICES TO THE CONDOMINIUM AND CASSOCIATION WITH EXPANSIONS TO THIS CONDUPON THE UNITS (LOTS) AT ALL TIMES FOR THURDERSTANDING THAT ANY GRANTEE SHALL BILL CAUSES TO ANY REAL PROPERTY OWNER IN AND GRANTED TO CITY (
GAS CORP., COMCAST
ON THE UTILITIES EASE
YET TO BE BUILT UTILIT
RATE, MAINTAIN AND RE
TACHED THERETO, FOR JRPOSES STATED, PONSIBLE FOR AL CONDOMINIUM BY ANACORTES, PUGET
ND THEIR RESPECTIVE
ENTS SHOWN HEREON, AND
ALIGNMENTS, IN WHICH
IOVE UTILITY SYSTEMS,
IE PURPOSE OF PROVIDING
MAY BE DEVELOPED IN
NTH THE RIGHT TO ENTER NECESSARY DAMAGE EXERCISE OF

TREASURER'S

I, KATIE JUNGQUIST, II DEPOSITS REQUIRED TO HAVE BEEN PAID, UP TREASURER OF SKAGIT COUNTY, HEREBY CERTIFY THAT ALL TAXES DUE AND/OR TO COVER ANTICIPATED TAXES ON THE PROPERTY EMBRACED IN THIS PLAT TO AND INCLUDING THE YEAR 20 _____.

SKAGIT

JOHN B. SEMRAU, P.E., P.L.S., CERTIFICATE NO. 28626 SEMRAU ENGINEERING & SURVEYING, P.L.L.C. 2118 RIVERSIDE DRIVE SUITE 208 MOUNT VERNON, WA 98273 PHONE 360-424-9566

ous d

DATE:

COPYRIGHT 2005

SEMRAU ENGINEERING & SU.

SURVEYING • ENGINEERING • PLANN


2118 RIVERSIDE DRIVE — SUITE 20


MOUNT VERNON, WA 98273

360-424-9566

SURVEYING

208

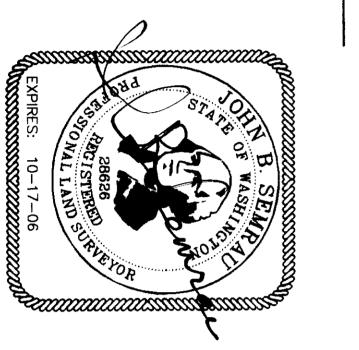

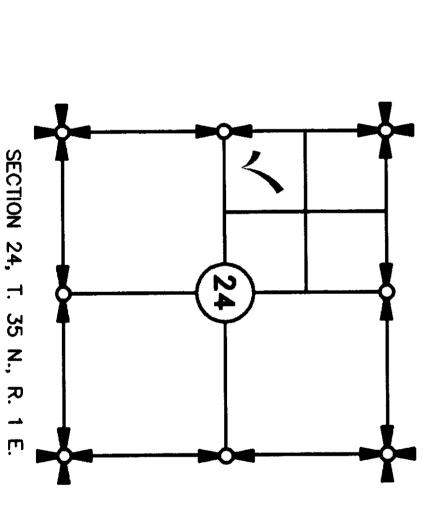

CERTIFICATE

COUNTY

PROJECT BENCH MARK IS TOP OF RAILROAD SPIKE IN UTILITY POLE ON EAST SIDE UP 1 FOOT FROM GROUND. ELEVATION = 83.6 NVGD '29. SEE SHEET 2 OF 3 FOLLOCATION.

= 83.61, 3 FOR

PROJECT

BENCH

MARK

LAND

SURVEYOR'S

CERTIFICATE

I HEREBY DECLARE THAT THIS SURVEY MAP AND PLANS ARE BASED UPON AN ACTUAL SURVEY OF THE DESCRIBED PROPERTY THAT THE COURSES AND DISTANCES SHOWN ARE CORRECT, AND THAT ALL INFORMATION REQUIRED BY RCW 64.34.232 AND IN CONFORMANCE WITH THE REQUIREMENTS OF THE SURVEY RECORDING ACT IS SHOWN, STATED OR IS SUPPLIED HEREIN. I FURTHER CERTIFY THAT THE HORIZONTAL AND VERTICAL BOUNDARIES OF THE UNITS IN THIS CONDOMINIUM ARE SUBSTANTIALLY COMPLETED IN ACCORDANCE WITH THE PLANS CONTAINED HEREIN.

AUDITOR'S CERTIFICATE

5/13/2005 Page 200505130120 Skagit County Auditor 310:38AM

REQUEST OF SEMRAU ENGINEERING & SURVEYING

P []

NAME STATE OF THE SKAGIT COUNTY AUDITOR

DECLA RATION REFERENCE

CONDOMINIUM DECLARATION PREPARED UNDER THE WASHINGTON CONDOMINIUM ACT FOR CONDOMINIUM TO WHICH THIS SURVEY AND SET OF PLANS REFER, WAS RECORDED WITH AUDITOR OF SKAGIT COUNTY, WASHINGTON, ON AUDITOR'S FILE NO. 2005 05 130121 RECORDS OF SKAGIT COUNTY, WASHINGTON.

THE S HAS

II.S

DEDICATION

WE THE UNDERSIGNED OWNER (S) IN FEE SIMPLE, ("DECLARANT"), HEREBY DECLARE THIS SURVEY MAP AND PLANS AND DEDICATE THE SAME FOR CONDOMINIUM PURPOSES. THIS SURVEY MAP AND PLANS AND ANY PORTION THEREOF SHALL BE RESTRICTED BY THE TERMS OF THE CONDOMINIUM DECLARATION FILED CONTEMPORANEOUSLY HEREMTH. THIS DEDICATION IS NOT FOR ANY OTHER USE THAN TO MEET THE REQUIREMENTS OF THE WASHINGTON CONDOMINIUM ACT FOR A SURVEY AND PLANS AND TO SUBMIT THE PROPERTY HEREIN DESCRIBED TO THE PROVISIONS OF THE ACT AS PROVIDED IN THE DECLARATION. WE FURTHER CERTIFY ALL STRUCTURAL COMPONENTS AND MECHANICAL SYSTEMS OF ALL BUILDINGS CONTAINING OR COMPRISING ANY UNITS HEREBY CREATED AF SUBSTANTIALLY COMPLETED. ARE

DECLARANT: HOMESTEAD NW DEV. CO., > WASHINGTON CORPORATION

WINSTRA AS PRESIDENT

ACKNOWLEDGMENT FOR **DECLARANT**

유

STATE WASHINGTON WHATCOM

COUNTY

욲

I CERTIFY THAT JAMES A. WYNSTRA APPEARED BEFORE ME AND SAID PERSON ACKNOWLEDGED THAT HE SIGNED THIS INSTRUMENT, ON OATH STATED THAT HE WAS AUTHORIZED TO EXECUTE THE INSTRUMENT AND ACKNOWLEDGED IT AS PRESIDENT OF HOMESTEAD NW DEV. CO. A WASHINGTON CORPORATION, TO BE THE FREE AND VOLUNTARY ACT OF SUCH PARTY FOR THE USES AND PURPOSES MENTIONED IN THE INSTRUMENT.

_DAY OF Mou 20**05**

	NOTARY	X
	PUBLIC IN AND I	helle
	Ž	/
	AND	こ
	FOR	U
•	H	20
•	FOR THE STATE OF	am
	웃	

WASHINGTON RESIDING Ą 9

APPOINTMENT EXPIRES

×

State of Washington WICHELLE A. THOMPSON MY COMMISSION EXPIRES July 22, 2008 Notary Public

TO SEED SO

HILLS CONDOMINIUM

ALDER

