SKAGIT COUNTY APPLICABLE BY: MAG

1:40PM

AUDITOR'S

Q

200804170066 Skagit County Auditor

INDICATORS

EXISTING

FENCELINE

NOTE

EXCEPT THAT PORTION DESCRIBED FOLLOWS:

COMMENCING AT A POINT 660 FEET SOUTH AND 346.5 FEET EAST OF THE NORTHWEST CORNER OF SAID GOVERNMENT LOT, SAID POINT BEING THE NORTHEAST CORNER OF PARCEL B AS CONVEYED TO HARRY HAUGLAND AND RUTH J. HAUGLAND, HUSBAND AND WIFE, IN DEED RECORDED MAY 23, 1968, UNDER AUDITOR'S FILE NO. 713954, RECORDS OF SKAGIT COUNTY, WASHINGTON;

THENCE SOUTH PARALLEL TO THE WEST LINE OF SAID GOVERNMENT LOT TO THE SOUTHERLY RIGHT—OF—WAY OF SAID CAMPBELL LAKE ROAD AND THE TRUE POINT OF BEGINNING;

THENCE EAST ALONG THE SOUTHERLY RIGHT—OF—WAY OF SAID CAMPBELL LAKE ROAD A DISTANCE OF 21.8 FEET TO AN EXISTING FENCELINE;

THENCE SOUTHERLY ALONG SAID EXISTING FENCELINE;

THENCE WESTERLY ALONG SAID EXISTING FENCE AND FENCELINE EXTENDED, A DISTANCE OF 1035 FEET, MORE OR LESS, TO THE SHORELINE OF LAKE CAMPBELL;

THENCE WESTERLY ALONG SAID SHORELINE 31.7 FEET MORE OR LESS, TO A POINT 346.5 FEET EAST OF THE WEST LINE OF SAID GOVERNMENT LOT 4; THENCE NORTH TO THE POINT OF BEGINNING;

TOGETHER WITH THE TIDE AND SHORE LANDS OF THE SECOND CLASS SITUATED IN FROM ADJACENT TO OR ABUTTING THAT PORTION OF THE ABOVE DESCRIBED PROPERTY. 9

LEGAL DESCRIPTION FROM CHICAGO TITLE COMPANY, ORDER NO. IC44149, EFFECTIVE DATE: NOV. 5, 2007 COMMITMENT FOR AT 8:30 A.M. TITLE

EXHIBIT "A", ORDER NO. IC44150

PARCEL À

LOT 1 OF SKAGIT COUNTY SHORT PLAT NO. SPT AND RECORDED JANUARY 18, 1994, IN VOLUME 1 AUDITOR'S FILE NO. 9401180147, RECORDS OF SHPORTION OF GOVERNMENT LOT 4 IN SECTION 12, THE WILLAMETTE MERIDIAN; SPT 93-060, AS APPROVED JANUARY 18, IE 11 OF SHORT PLATS, PAGE 54, UNDER SKAGIT COUNTY, WASHINGTON, BEING A 12, TOWNSHIP 34 NORTH, RANGE 1 EAST

EXCEPT THAT PORTION DESCRIBED AS FOLLOWS:

BEGINNING AT A POINT 660 FEET SOUTH AND 346.5 FEET EAST OF THE NORTHWEST CORNER OF SAID GOVERNMENT LOT, SAID POINT BEING THE NORTHEAST CORNER OF PARCEL B AS CONVEYED TO HARRY HAUGLAND AND RUTH J. HAUGLAND, HUSBAND AND WIFE, IN DEED RECORDED MAY 23, 1968, UNDER AUDITOR'S FILE NO. 713954, RECORDS OF SKAGIT COUNTY, WASHINGTON;
THENCE EAST 15.3 FEET, MORE OR LESS, TO AN EXISTING NORTH—SOUTH FENCELINE;
THENCE SOUTHERLY ALONG SAID EXISTING FENCE LINE, A DISTANCE OF 312.7 FEET MORE OR LESS, TO THE NORTHERLY RIGHT—OF—WAY OF CAMPBELL LAKE ROAD;
THENCE WESTERLY ALONG SAID NORTHERLY RIGHT—OF—WAY, A DISTANCE OF 21.2 FEET, MORE OR LESS, TO A POINT 346.5 FEET EAST OF THE WEST LINE OF SAID GOVERNMENT LOT 4: THENCE NORTH TO THE POINT OF BEGINNING.

THAT PORTION DESCRIBED AS FOLLOWS:

BEGINNING AT A POINT 660 FEET SOUTH AND 346.5 FEET EAST OF THE NORTHWEST CORNER OF SAID GOVERNMENT LOT, SAID POINT BEING THE NORTHEAST CORNER OF PARCEL B AS CONVEYED TO HARRY HAUGLAND AND RUTH J. HAUGLAND, HUSBAND AND WIFE, IN DEED RECORDED MAY 23, 1968, UNDER AUDITOR'S FILE NO. 713954, RECORDS OF SKAGIT COUNTY, WASHINGTON;
THENCE EAST A DISTANCE OF 15.3 FEET, MORE OR LESS, TO AN EXISTING NORTH—SOUTH FENCELINE;
THENCE NORTHERLY ALONG SAID FENCELINE, AND SAID FENCELINE EXTENDED, A DISTANCE OF 658.9 FEET, MORE LOT LESS, TO THE NORTH LINE OF SAID GOVERNMENT LOT 4;
THENCE WEST ALONG THE NORTH LINE OF SAID GOVERNMENT LOT 4, A DISTANCE OF 26.9 FEET, MORE OR LESS, TO A POINT 321.50 FEET, FROM THE NORTHWEST CORNER OF SAID GOVERNMENT LOT 4;
THENCE SOUTH PARALLEL TO THE WEST LINE OF SAID GOVERNMENT LOT 4, A DISTANCE OF 660.00 FEET; THENCE EAST, A DISTANCE OF 25.35 FEET, MORE OR LESS, TO THE POINT OF BEGINNING;

TOGETHER WITH THAT PORTION OF GOVERNMENT LOT 4 AND NORTHEAST QUARTER ALL IN IN SECTION 12, TOWNSHIP 34 WILLAMETTE MERIDIAN, DESCRIBED AS FOLLOWS: THAT PORTION OF NORTH, RANGE 1

(SP 43-89= NO<u>0'3'16"E)</u>

S 00°56'01" E

553.59

955'±

LOT 4
APPROX
67 ACRES

BEGINNING AT THE SOUTHEAST CORNER OF THE WEST HALF OF THE SOUTHWEST QUARTER OF THE NORTHEAST QUARTER OF SAID SECTION 12;
THENCE NORTH 86:55:50" WEST, ALONG THE SOUTH LINE OF SAID NORTHEAST QUARTER A DISTANCE OF 317.0 FEET TO AN EXTENSION NORTH OF AN EXISTING FENCE LINE LYING TO THE SOUTH ON GOVERNMENT LOT 4;
THENCE NORTH 0:45:31" WEST, A DISTANCE OF 176.06 FEET;
THENCE SOUTH 89:41:52" EAST 319.87 FEET TO THE EAST LINE OF SAID WEST HALF OF THE SOUTHWEST QUARTER OF THE NORTHEAST QUARTER; THENCE SOUTH 0:18:02" WEST ALONG THE EAST LINE THEREOF, 191.34 FEET TO THE POINT OF BEGINNING: ALONG THE

1037'±

S 00°02'41" W

399.21'

BEGINNING AT THE SOUTHEAST CORNER OF THE NORTHEAST QUARTER OF SAID ALSO TOGETHER WITH THAT PORTION OF GOVERNMENT LOT 4, DESCRIBED AS FOLLOWS: OF THE WEST HALF SECTION 12: 웃 THE SOUTHWEST QUARTER

THENCE SOUTH ALONG THE EAST LINE OF SAID WEST HALF EXTENDED 5.3 FEET LESS, TO AN EXISTING EAST—WEST FENCELINE, THENCE WESTERLY ALONG THE EXISTING FENCELINE, A DISTANCE OF 317 FEET, LESS, TO AN EXISTING FENCE CORNER; THENCE NORTH ON AN EXTENSION OF THE FENCELINE HEADING SOUTH, A DISTAFEET, MORE OR LESS, TO THE SOUTH LINE OF SAID WEST HALF; THENCE SOUTH 86.55.50 EAST, ALONG THE SOUTH LINE THEREOF, A DISTANCE FEET, MORE OR LESS, TO THE POINT OF BEGINNING. EXTENDED 5.3 FEET, MORE SOUTH, A DISTANCE MORE OR 유 15.5

S 0'24'26" W

S 0'24'26"

250.'±

SITUATED IN SKAGIT COUNTY, WASHINGTON

PARCEL

LOTS 2 AND 3 OF SKAGIT COUNTY SHORT PLAT NO. SPT 93-060 AS AF 18, 1994 AND RECORDED JANUARY 18, 1994 IN VOLUME 11 OF SHORT PLUNDER AUDITOR'S FILE NO. 94011180147, RECORDS OF SKAGIT COUNTY, 1 A PORTION OF GOVERNMENT LOT 4 IN SECTION 12, TOWNSHIP 34 NORTH, THE WILLAMETTE MERIDIAN. APPROVED JANUARY
I PLATS, PAGE 54,
IY, WASHINGTON; BEING
RTH, RANGE 1 EAST OF

SITUATED IN SKAGIT COUNTY WASHINGTON.

LEGAL ORDER DESCRIPTION FROM CHICAGO TITLE INSURANCE, COMMITMENT NUMBER IC44150, EFFECTIVE DATE: NOV. 6, 2007 AT 8:30

DUANE

JEFFRE

CERTIFICATE

<u>N</u>O.

19645

DATE

417-

Q

THIS ME OR REQUER

LY REPRESENTS A SURVEY MADE DIRECTION IN CONFORMANCE WITH THE SURVEY RECORDING ACT, AT

표 문 목

VEYOR'S

CERTIFICATE

0

 \leq

9

 \mathcal{B}

不

Ш


2nd

Class

Shore

Lands

NORTH

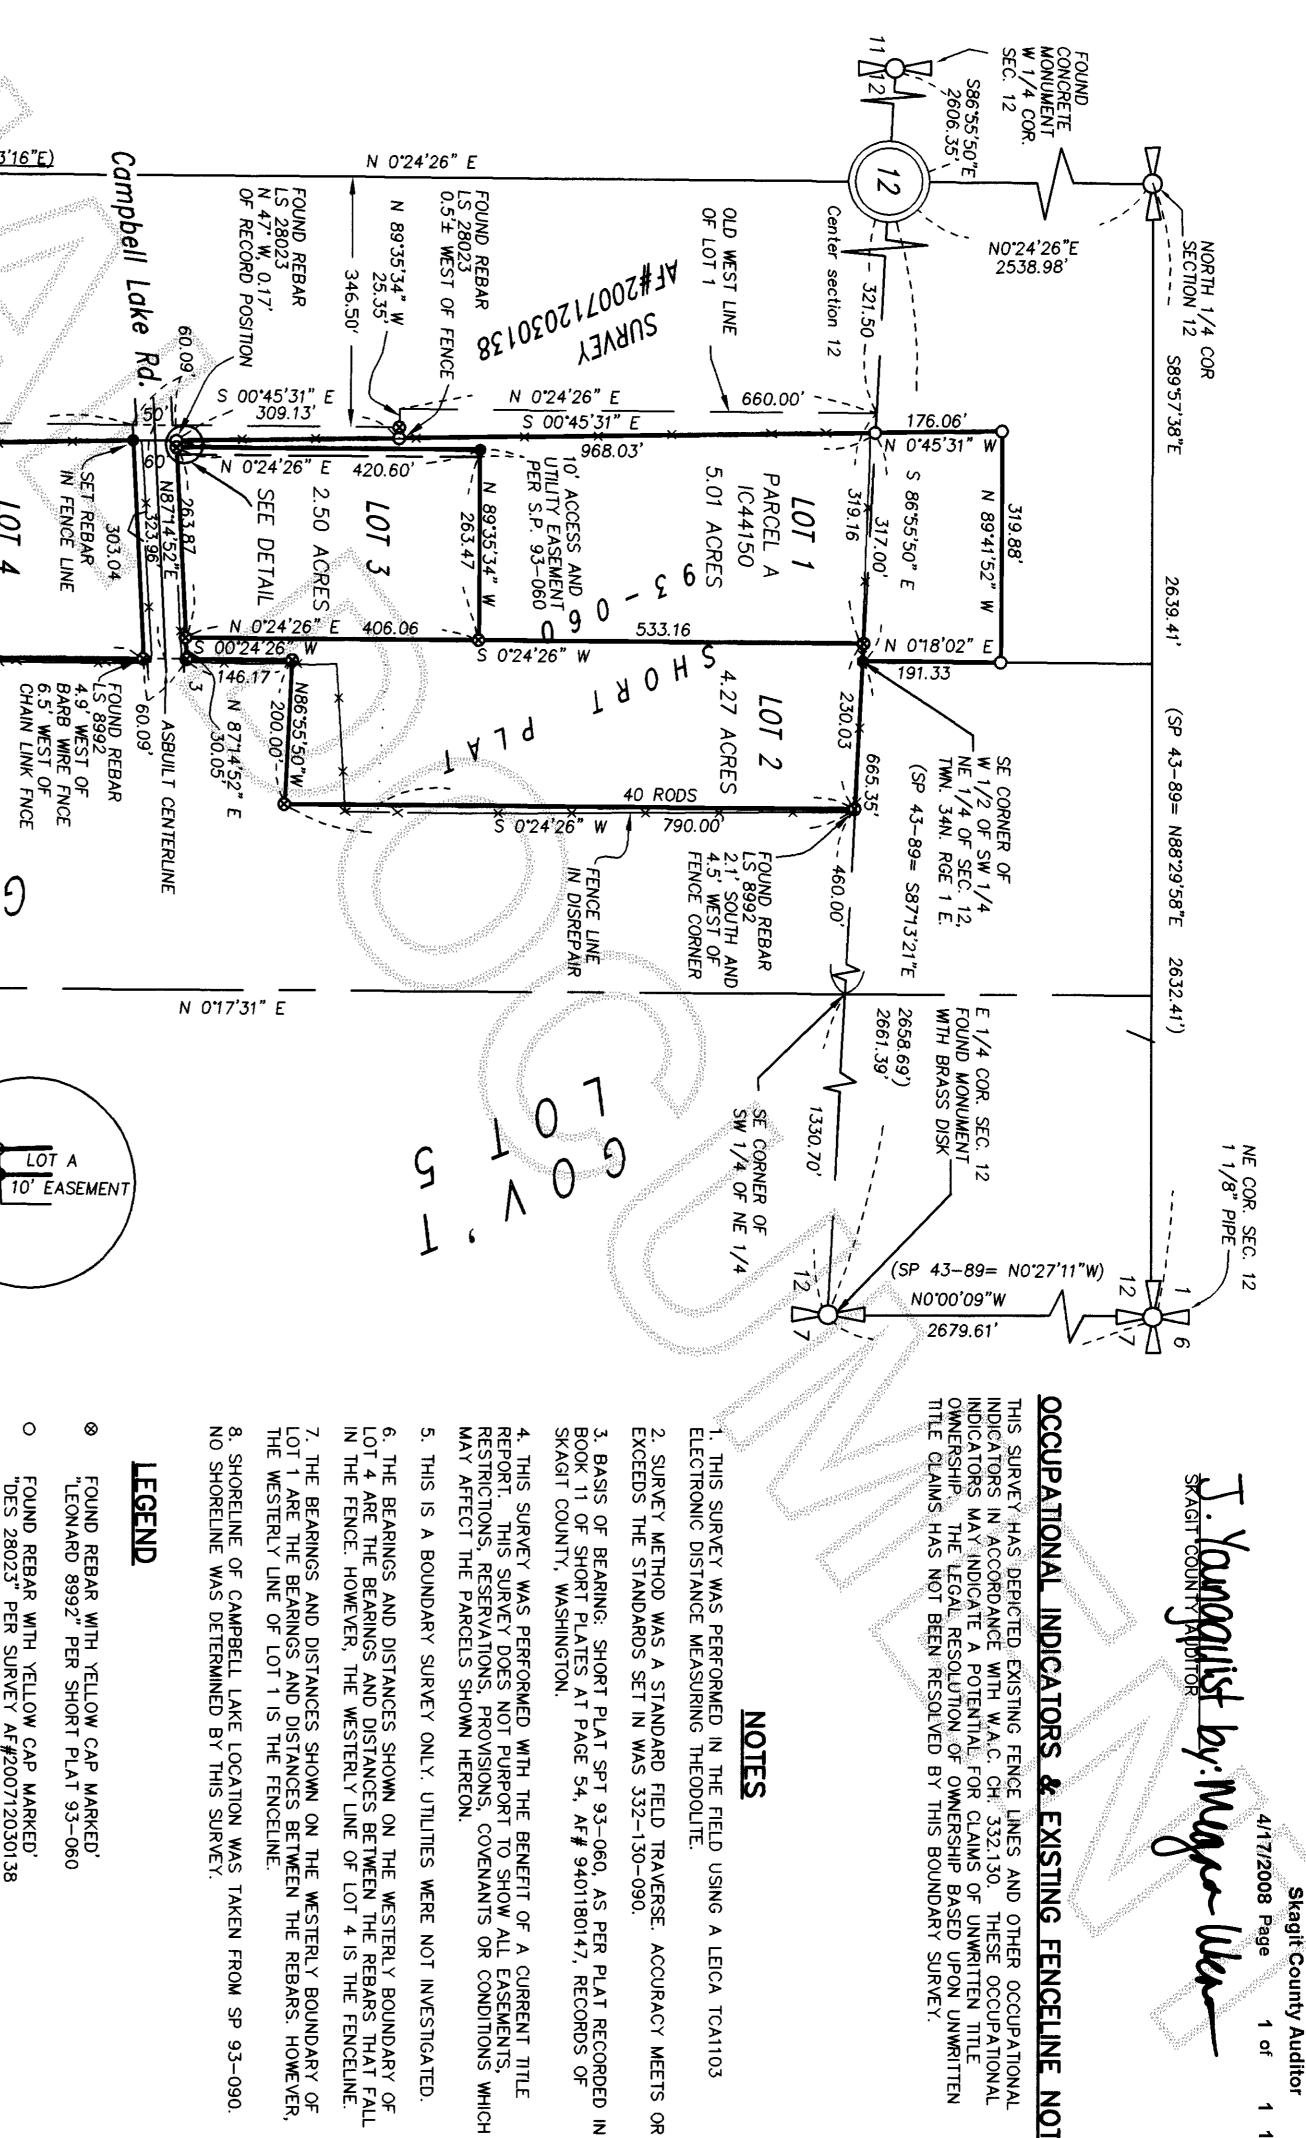

NOTES

LEGEND

SHORELINE OF CAMPBELL LAKE LOCATION WAS TAKEN FROM SP 93-090 SHORELINE WAS DETERMINED BY THIS SURVEY.

IS A BOUNDARY SURVEY ONLY. UTILITIES WERE NOT INVESTIGATED

FOUND REBAR WITH YELLOW CAP MARKED' "LEONARD 8992" PER SHORT PLAT 93-060

 \otimes

FOUND REBAR WITH YELLOW CAP MARKED'
"DES 28023" PER SURVEY AF#200712030138


0

LOT

SET REBAR WITH YELLOW CAP MARKED' "SKODJE 19645"

EXISTING FENCE LINES

DETAIL (NTS)

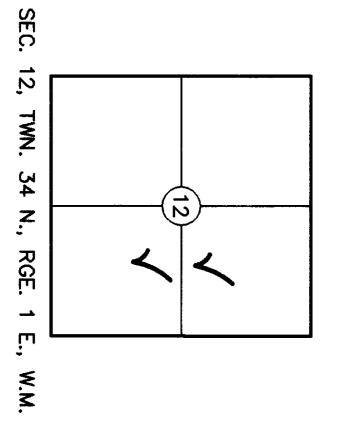

RECORD SURVEY

DUANE ₩ Pgg P XZAPP

PORTION GOVRNMEN LOT AND THE NE 1/4 SKAGIT COUNTY, 4 OF SECTION 12, WASHINGTON TWP. 34 ; RGE. **≪ ™**

LEONARD, BOUDINOT and SKODJE, INC.
CIVIL ENGINEERS AND LAND SURVEYORS
JTH FIRST ST., MOUNT VERNON, WA 98273 (360)336-

SOUTH

SCALE: 08019

200