




P34644

After

BLA PLO8-0667

P34646

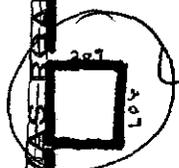


LIC PLO8-0541

P34667

P127928

P7260

LIC PLO8-0540

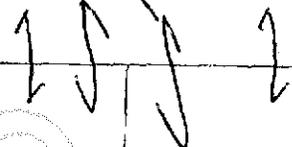

P34670

P34672

P34671

SURVEY  
AF20050216007  
P34668

BENSON ROAD


THOMAS ROAD



200901080049

Skagit County Auditor

UNMOUNTED

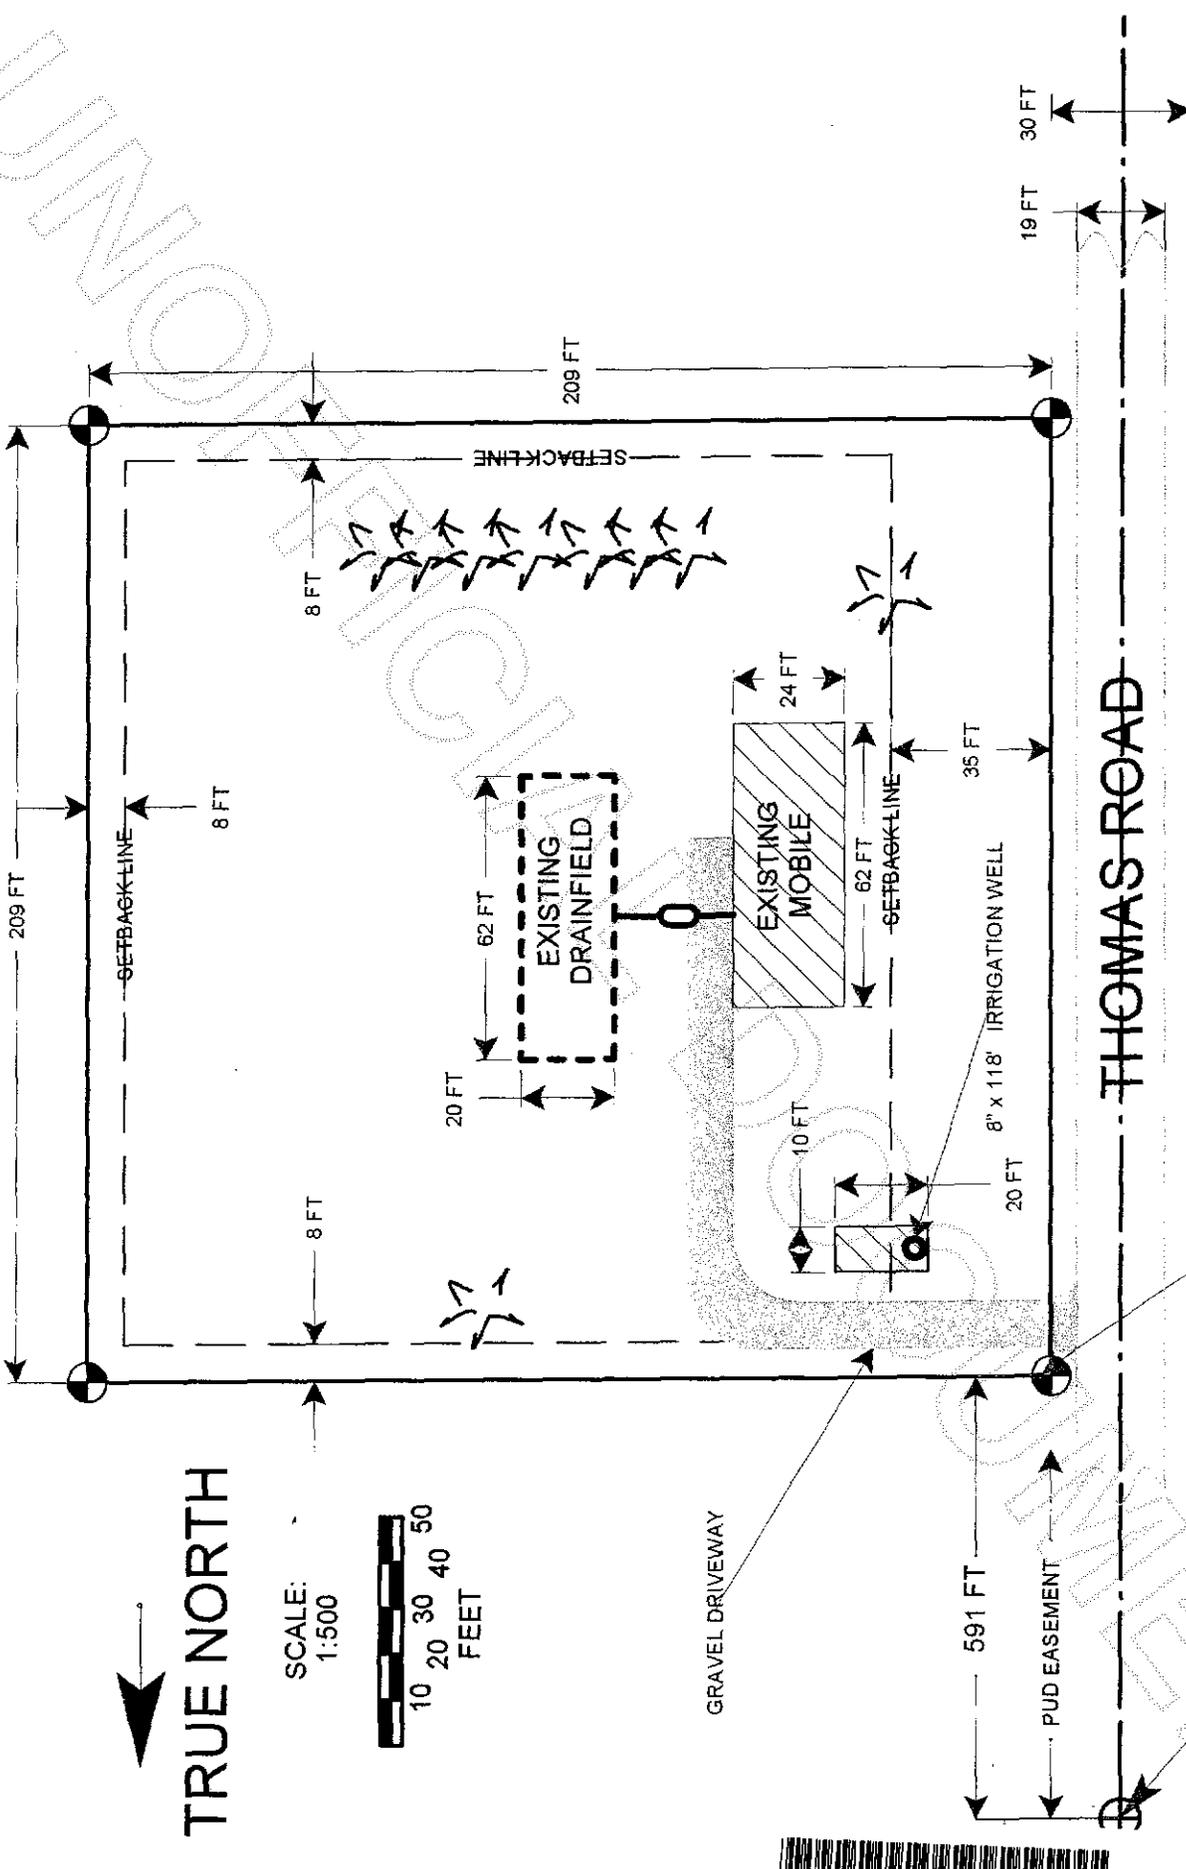

TRUE NORTH

SCALE: 1:500



GRAVEL DRIVEWAY



200901080049 Skagit County Auditor

IAN & KATE MINTZ  
 SITE ADDRESS:  
 9619 THOMAS RD,  
 BOW, WA 98232  
 (Old Situs 963 Thomas)

PARCEL # 34667  
 N1/2 SE1/4 S22 T35 R3E

"AS BUILT" SITE PLAN  
 DATE MEASURED:  
 31 AUG 2008  
 DATE DRAWN:  
 1 SEP 2008

PUD VAULT

1/4 SECTION MONUMENT--C.L. OF ROAD