THE SOUTH 1,122.50 FEET OF THE EAST HALF OF THE SOUTHEAST QUARTER OF THE NORTHEAST QUARTER OF SECTION 17, TOWNSHIP 34 NORTH, RANGE 4 EAST OF THE WILLAMETTE MERIDIAN;

EXCEPT THE SOUTH 550.00 FEET THEREOF;

EXCEPT THE EAST 214.00 FEET THEREOF;

AND EXCEPT THE NORTH 15.33 FEET OF THE SOUTH 565.33 FEET OF THE WEST 333.00 FEET OF THE EAST HALF OF THE SOUTHEAST QUARTER OF THE NORTHEAST QUARTER OF SAID SECTION 17;

AND ALSO EXCEPT TRACT A OF SURVEY RECORDED AUGUST 4, 1997 UNDER AUDITOR'S FILE NO. 9708040071 IN VOLUME 19 OF SURVEYS, PAGE 153, RECORDS OF SKAGIT COUNTY, WASHINGTON.

SITUATED IN SKAGIT COUNTY, WASHINGTON.

PARCEL B

THE SOUTH 1,122.50 FEET OF THE EAST 15.00 FEET OF QUARTER OF THE NORTHEAST QUARTER OF SECTION 17, OF THE WILLAMETTE MERIDIAN; THE WEST HALF OF THE SOUTHEA TOWNSHIP 34 NORTH, RANGE 4 E

EXCEPT THE SOUTH 565.33 FEET THEREOF.

SITUATED IN SKAGIT COUNTY, WASHINGTON.

THE NORTH 285.33 FEET OF THE SOUTH 565.33 FEET OF THE WEST 333.00 FEET OF THE EAST HALF OF THE SOUTHEAST QUARTER OF THE NORTHEAST QUARTER OF SECTION 17, TOWNSHIP 34 NORTH, RANGE 4 EAST OF THE WILLAMETTE MERIDIAN; A NON-EXCLUSIVE EASEMENT FOR INGRESS, EGRESS, DRAINAGE AND UTILITIES OVER AND ACROSS THE WEST 30.00 FEET OF THE FOLLOWING DESCRIBED TRACT:

TOGETHER WITH THE NORTH 285.33 FEET OF THE SOUTH 565.33 FEET OF THE EAST 15.00 FEET OF THE WEST HALF OF THE SOUTHEAST QUARTER OF THE NORTHEAST QUARTER OF SECTION 17, TOWNSHIP 34 NORTH, RANGE 4 EAST OF THE WILLAMETTE MERIDIAN.

SITUATED IN SKAGIT COUNTY, WASHINGTON.

"O

A NON-EXCLUSIVE EASEMENT OF INGRESS, EGRESS, DRAINAGE AND UTILITIES OVER AND ACROSS THE WEST 30.00 FEET OF THE FOLLOWING DESCRIBED TRACT:

THE EAST 98.50 FEET OF THE WEST 143.50 FEET OF THE NORTH 250.00 FEET OF THE 280.00 FEET OF THE EAST HALF OF THE SOUTHEAST QUARTER OF THE NORTHEAST OF SECTION 17, TOWNSHIP 34 NORTH, RANGE 4 EAST OF THE WILLAMETTE MERIDIAN; THE SOUTH

TOGETHER WITH THE WEST 45.00 FEET OF THE NORTH 250.00 FEET OF THE SOUTH 280.00 FEET OF THE EAST HALF OF THE SOUTHEAST QUARTER OF THE NORTHEAST QUARTER OF SECTION 17, TOWNSHIP 34 NORTH, RANGE 4 EAST OF THE WILLAMETTE MERIDIAN;

TOGETHER WITH THE EAST 15.00 FEET OF THE NORTH 250.00 FEET OF THE SOUTH 280.00 FEET OF THE WEST HALF OF THE SOUTHEAST QUARTER OF THE NORTHEAST QUARTER OF SECTION 17, TOWNSHIP 34 NORTH, RANGE 4 EAST OF THE WILLAMETTE MERIDIAN.

SITUATED IN SKAGIT COUNTY, WASHINGTON.

PARCEL

A NON-EXCLUSIVE EASEMENT FOR INGRESS, EGRESS AND UTILITIES OVER AND ACROSS THE WEST 354.56 FEET OF THE EAST 568.56 FEET OF THE NORTH 25.00 FEET OF THE SOUTH 1,147.50 FEET OF THE EAST HALF OF THE SOUTHEAST QUARTER OF THE NORTHEAST QUARTOF SAID SECTION 17. ARTER

SITUATED IN SKAGIT COUNTY, WASHINGTON

**PARCEL** ญ

A NON-EXCLUSIVE EASEMENT FOR INGRESS, FOLLOWING DESCRIBED TRACT: EGRESS AND UTILITIES OVER AND ACROSS TI

BECINNING AT THE SOUTHWEST CORNER OF THE WEST 184.00 FEET OF THE EAST 214.00 OF THE NORTH 60.00 FEET OF THE SOUTH 1,182.50 FEET OF THE SOUTHEAST QUARTER OF THE NORTHEAST QUARTER OF SAID SECTION 17;

THENCE SOUTH 87.55.03" EAST, 184.03 FEET TO THE SOUTHEAST CORNER OF SAID WEST 184.00 FEET OF THE EAST 214.00 FEET OF THE NORTH 60.00 FEET OF THE SOUTH 1,182. 50


SAID EAST 214.00 FEET TO THE N THENCE SOUTH 01'01'55" WEST, 40 BEGINNING THENCE NORTH 01'01'55" EAST, 60.01 FEET ALONG THE EAST LINE THEREOF TO THE NORTHEAST CORNER THEREOF;
THENCE NORTH 87'55'03" WEST 90.14 FEET ALONG THE NORTH LINE OF SAID SOUTH 1,18. FEET TO A POINT OF CURVATURE;
THENCE ALONG THE ARC OF SAID CURVE CONCAVE TO THE SOUTHEAST HAVING A RADIUS 130.00 FEET, THROUGH A CENTRAL ANGLE OF 32'03'12, AN ARC DISTANCE OF 72.73 FEET A POINT OF TANGENCY;
A POINT OF TANGENCY;
THENCE SOUTH 60'01'45" WEST, 0.34 FEET TO THE NORTH LINE OF THE SOUTH 1,162.50 IOF SAID SUBDIVISION;
THENCE NORTH 87'55'03" WEST, 24.24 FEET ALONG SAID NORTH LINE TO THE WEST LINE SAID EAST 214.00 FEET TO THE NORTH 1,182.50 FEET OF SAID SUBDIVISION;
THENCE SOUTH 01'01'55" WEST, 24.24 FEET ALONG SAID NORTH LINE TO THE WEST LINE THENCE SOUTH 01'01'55" WEST. 24.24 FEET ALONG SAID NORTH LINE TO THE WEST LINE NORTH 1,182.50 FEET OF SAID SUBDIVISION; 40.01 FEET ALONG SAID WEST LINE TO THE POINT OF S OF 70 FEET

SITUATED IN SKAGIT COUNTY, WASHINGTON.

## SURVEYOR'S CERTIFICATE

THIS MAP CORDINECTION IN RECORDING AC CORRECTLY REPRESENTS
IN CONFORMANCE WITH
G ACT AT THE REQUEST THE REQUIREMENTS OF THE SURVE OF THE MOLNICK GROUP IN JULY, 2008

RICHARD A. HEALEY, P.L.S. CERTIFICATE NO. 20719

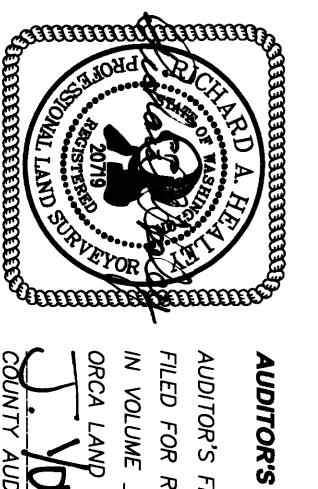

FILED AUDITOR'S 5 FOR FILE RECORD NUMBER SIHT 26th DAY

10

PAGE 2009, AT 9, A THE 13

OF M

Ž

THE

SE

9

R. 4E.,

¥.X

REQUES 8

DESCRIPTIONS (CONTINUED)

200902250119 Skagit County Auditor

AND AND

E ALONG THE ARC OF A CURVE CONTROL AND AN INITIAL TANGENT BE ALONG THE ARC OF A CURVE CONTROL ANGLEST LINE OF SAID EAST 214.00 FE ENORTH 01'01'55" EAST 39.90 FE THE NORTHWEST 87.55'03" EAST, 92.79 FEET ALONG ARC L CONCAVE TO BEARING OF NO R OF SAID WEST 184.00 SOUTHEAST QUARTER OF THE SOUTHEAST HAVING A RAIORTH 87.55°03" WEST, THROUGH F 39.16 FEET TO A POINT OF THE NORTH LINE OF CURVATURE; FEET OF THE EAST 214.00 FEET THE NORTHEAST QUARTER OF THE POINT OF NING A RADIUS SAID 70 SOUTH 1,122.5 RADIUS

WASHINGTON.

PARCEL

A NON-EXCLUSIVE EASEMENT FOR FOLLOWING DESCRIBED TRACT: INGRESS, **EGRESS** AND UTILITIES OVER

COMMENCING AT THE SOUTHEAST CORNER OF THE NORTHEAST QUARTER OF SECTION 17, TOWNSHIP 34 NORTH, RANGE 4 EAST OF THE WILLAMETTE MERIDIAN; THENCE NORTH 01°01'55" EAST ALONG THE EAST LINE OF SAID SUBDIVISION A DISTANCE

NORTH OF OF 1 87°55°04" WEST PARALLEL TO THE SOUTH LINE INE PARALLEL WITH AND 214.00 FEET DISTANCE, RLY FROM SAID EAST LINE OF SAID SUBDIVISION, OF SAID SUBDIVISION TO AS MEASURED SAID POINT BEING THE T THE TRUE

4" WEST, A DISTANCE OF 30.01 FEET;

WEST, A DISTANCE OF 71.60 FEET TO THE PRADIUS CONCAVE NORTHEASTERLY;

Y THROUGH A CENTRAL ANGLE OF 46.49.30

ON THE WEST LINE OF LOT 2 OF MOUNT NORTHE WEST PLATS, PAGE 8, UNDER AUDIT OUNTY, WASHINGTON; PLATS, PAGE 8, UNDER AUDITOR'S FILE NO. 8712210075
HINGTON;
NG THE WEST LINE OF SAID LOT 2 AND THE NORTHERLY
OF 140.33 FEET TO THE TRUE POINT OF BEGINNING. E OF 46.49'35" FOR A DISTANCE OF 77.64
OF MOUNT VERNON SHORT PLAT 4-87, AS
UNDER AUDITOR'S FILE NO. 8712210075, THE BEGINNING , A

1325.66

SITUATED IN SKAGIT WASHINGTON.

PARCEL

NON-EXCLL
O. 95101000
ITLITIES OVE
THAT NO. MVLAT NO. MVOUNTY, BEIN
OONTHEAST G 1987, AS OF SKAGIT

MITH A NON-BOTH THE SOU THE SOUTH 4 Ž SKAGIT FEET OF LOT OF LOT 2 OF

> GRAPHIC SCALE 200 400

CALCULATED PI A.F. NO. 97080 ER R.O. 663.49 1326.98' 663.49' EX. CASED CONC. M. W/IRON ROD. (VISITED: 6/12/08)

CONC. MON. BRASS DISK /12/08) 87.54.52 COLLEGE  $B_{-}$ N 01°07'34" E 1325.93' WAY 1331.36 ARCEL ARCEL PARCEL PARCEL PARCEL PARCEL $\hat{\mathcal{Q}}_{*}$ Ö " A" PARCEL Q Q EX. CASED CONC. MON. BRASS DISK STAMPED "X (VISITED: 6/12/08) G''(BASIS OF BEARINGS) N 01°01'55" E 1326.20 LA VENTURE ROAD

N 0173'14" E

SECTION SUBDIVISION SE 1/4, NE 1/4, SEC. 17


RECORD SURVEY GROUP FOR

THE NE SKAGIT ( COUNTY, SECTION 17, WASHINGTON T. 34N.,



2008035

JOB NO. .
DATE:
DWG BY:
F.B. 802,
SHEET 1

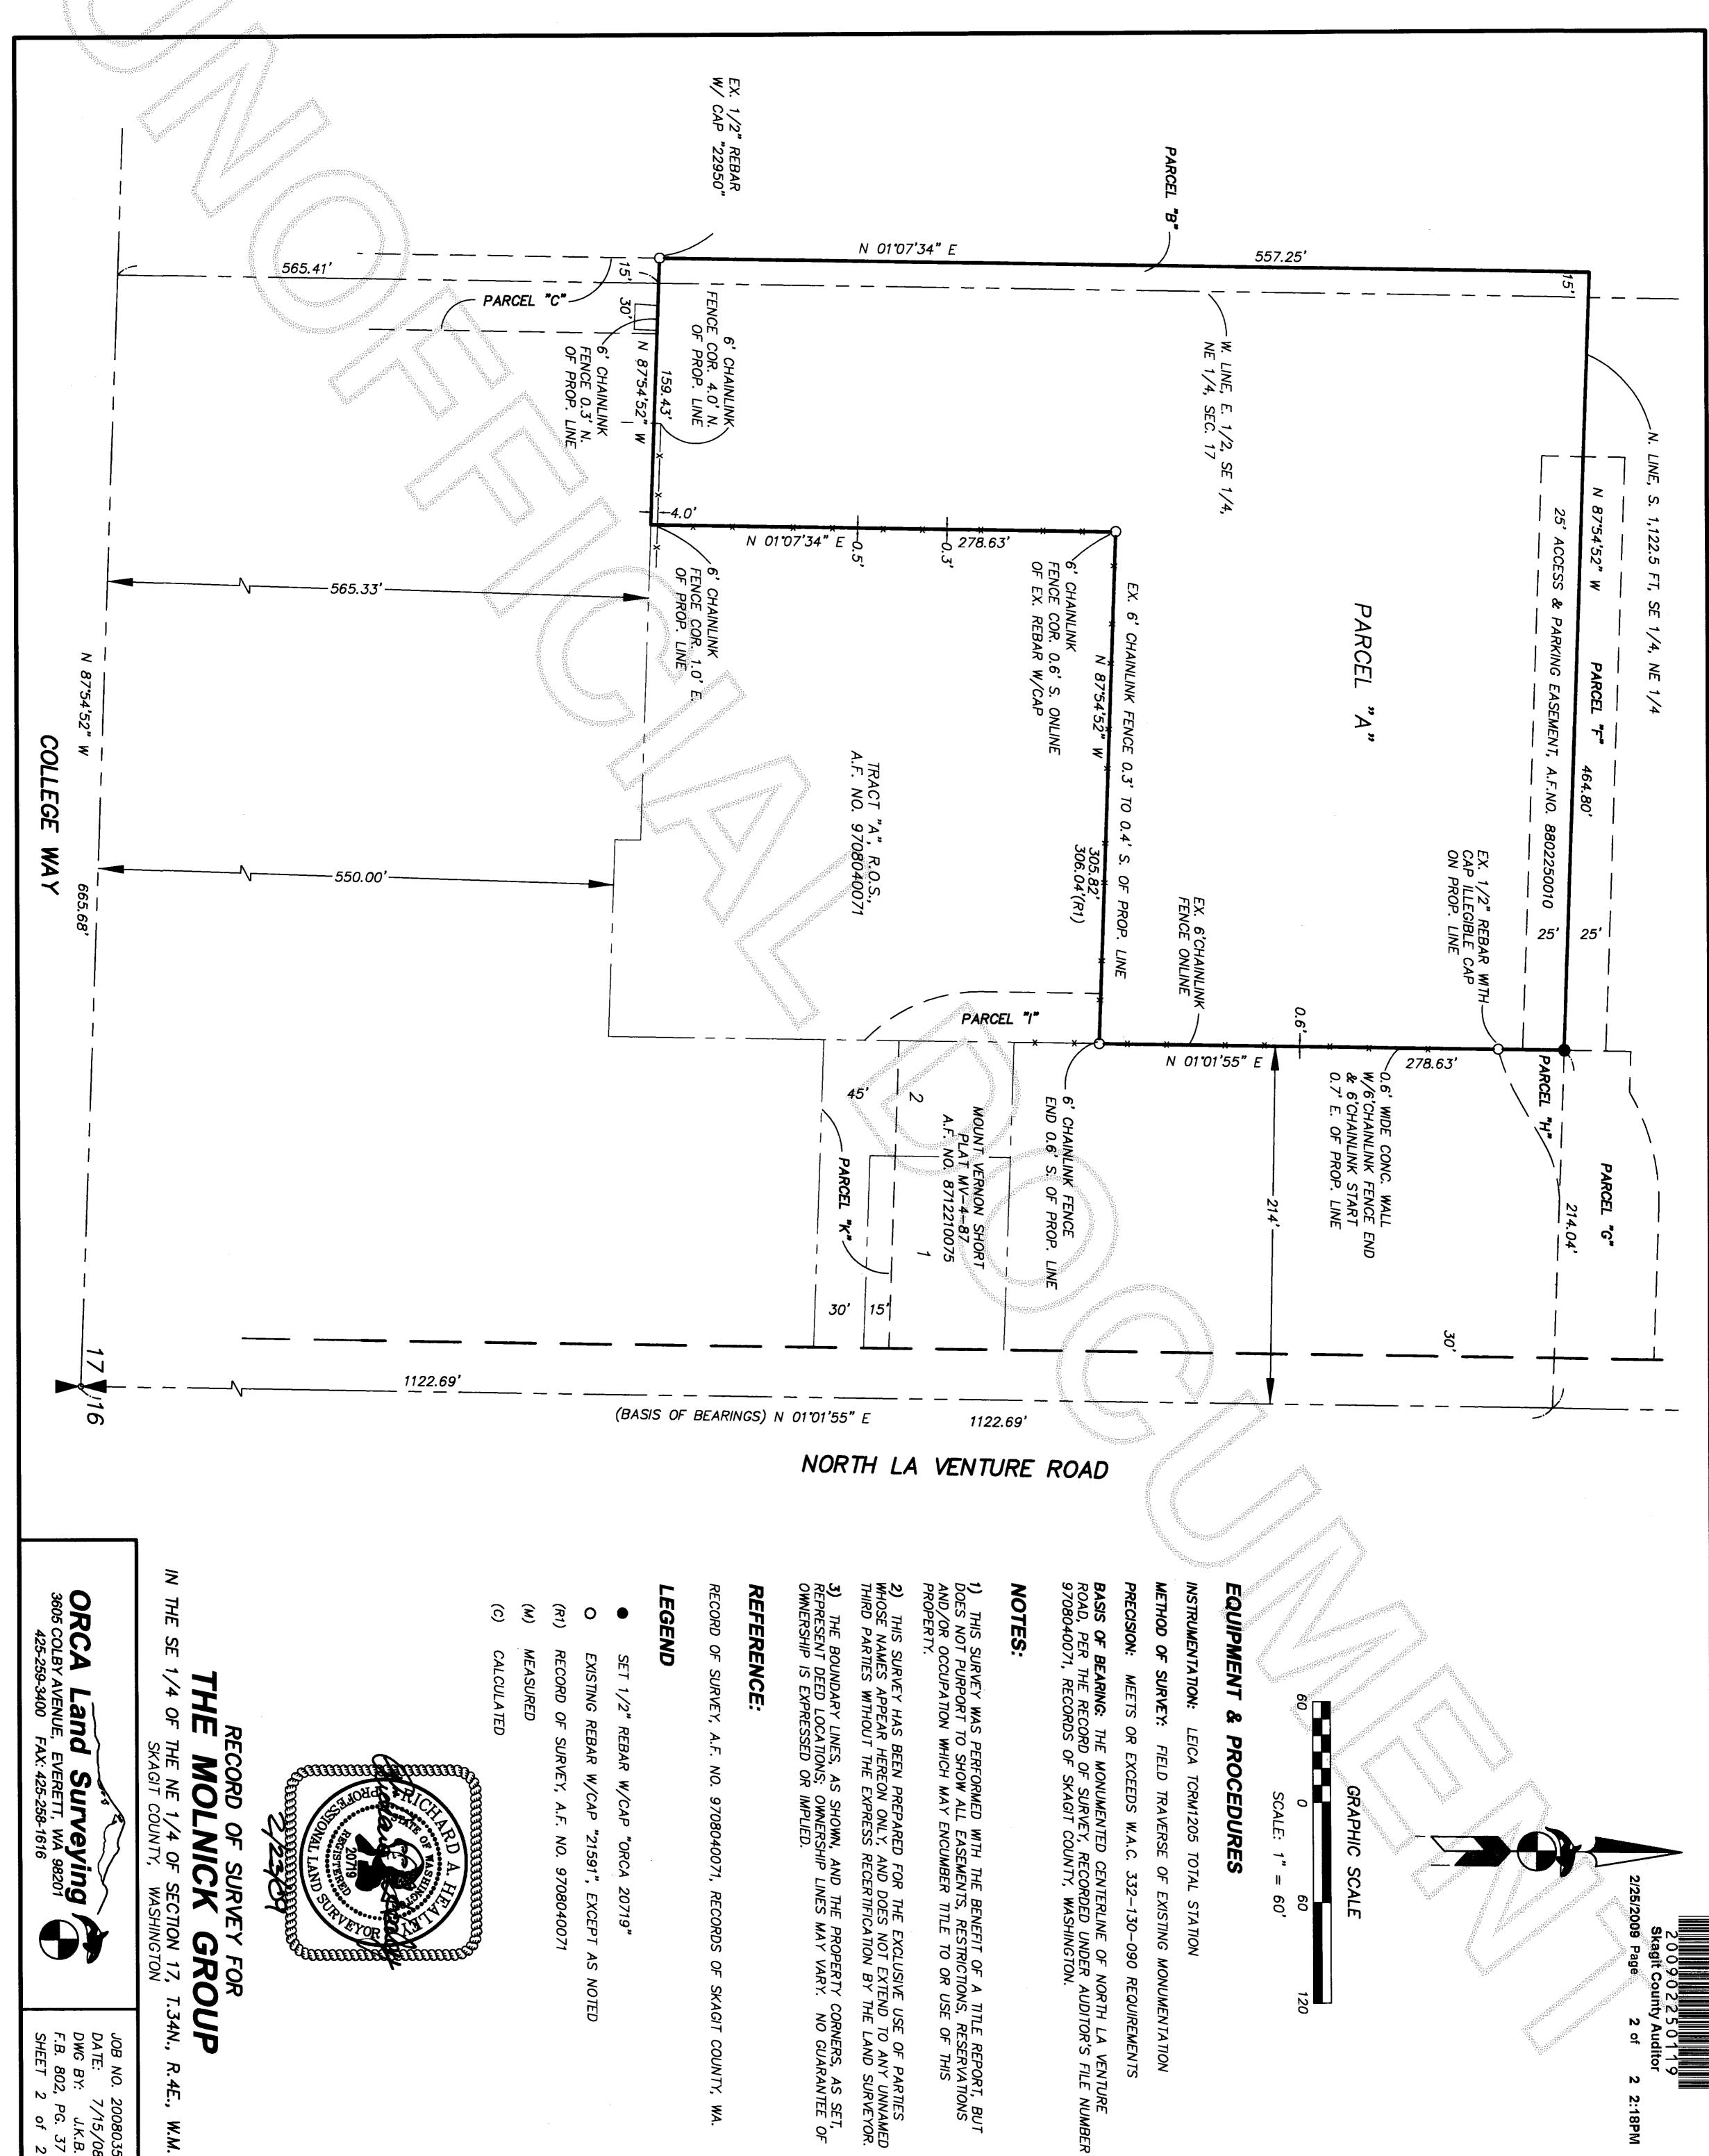

MEETS OR EXCEEDS W.A.C. 332-130-090 REQUIREMENTS

FIELD TRAVERSE OF EXISTING MONUMENTATION

0

SCALE:

60,

GRAPHIC

SCALE

80

**PROCEDURES** 

LEICA TCRM1205 TOTAL STATION

## ORCA Land Surveying / 3605 COLBY AVENUE, EVERETT, WA 98201 425-259-3400 FAX: 425-258-1616

2008035

9 RECORD MOLNICK 9 SURVEY FOR GROUP T.34N., R.4E.,

¥.X.

CALCULATED

COMMINGENIES OF THE PARTY OF TH

MEASURED

RECORD OF SURVEY, A.F. NO. 9708040071

EXISTING REBAR W/CAP "21591", EXCEPT AS NOTED

REBAR W/CAP

"ORCA

SE

1/4

THE NE 1/4 OF SECTION 17, SKAGIT COUNTY, WASHINGTON

JOB NO. 2 DATE: 7 DWG BY: F.B. 802, 1 SHEET 2