

SURVEY MAP AND PLANS FOR
QUANTUM BUSINESS PARK CONDOMINIUM

DEDICATION

THE UNDERSIGNED OWNER IN FEE SIMPLE, "DECLARANT", HEREBY DECLARES THIS SURVEY MAP AND DEDICATE THE SAME FOR CONDOMINIUM PURPOSES. THIS SURVEY MAP AND PLANS AND ANY PORTION THEREOF SHALL BE RESTRICTED BY THE TERMS OF THE CONDOMINIUM DECLARATION FILED CONTEMPORANEOUSLY HERewith, THIS DEDICATION IS NOT FOR ANY OTHER USE THAN TO MEET THE REQUIREMENTS OF THE WASHINGTON CONDOMINIUM ACT FOR A SURVEY AND PLANS TO SUBMIT THE PROPERTY TO THE ACT AS PROVIDED IN THE DECLARATION.

QUANTUM BUSINESS PARK, LLC,
A WASHINGTON LIMITED LIABILITY COMPANY

BY: *[Signature]*
DANIEL H. FOLKERS, ITS MANAGER

BY: *[Signature]*
BETH FOLKERS, ITS MANAGER

WHIDBEY ISLAND BANK


BY: *[Signature]*
PRINT NAME: Jim McIntosh
TITLE: Vice President

ACKNOWLEDGEMENTS

STATE OF WASHINGTON
COUNTY OF SKAGIT

I CERTIFY THAT I KNOW OR HAVE SATISFACTORY EVIDENCE THAT DANIEL H. FOLKERS AND BETH FOLKERS, SIGNED THIS INSTRUMENT, ON OATH STATED THAT THEY ARE AUTHORIZED TO EXECUTE THE INSTRUMENT AND ACKNOWLEDGED IT AS THE MANAGERS OF QUANTUM BUSINESS PARK, LLC, A WASHINGTON LIMITED LIABILITY COMPANY, TO BE THE FREE AND VOLUNTARY ACT OF SUCH PARTY FOR THE USES AND PURPOSES MENTIONED IN THE INSTRUMENT.

DATED June 27, 2009

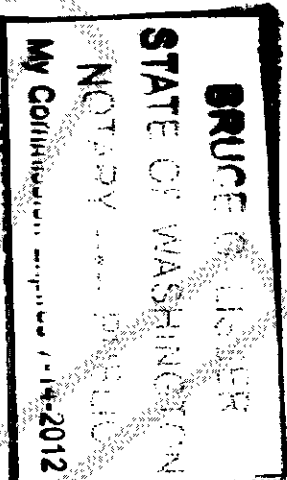


SIGNATURE *[Signature]*
NOTARY PUBLIC
MY APPOINTMENT EXPIRES 7-1-12
RESIDING AT Mount Vernon

STATE OF WASHINGTON
COUNTY OF SKAGIT

I CERTIFY THAT I KNOW OR HAVE SATISFACTORY EVIDENCE THAT Jim McIntosh SIGNED THIS INSTRUMENT, ON OATH STATED THAT HE ~~SIGNED~~ ACKNOWLEDGED IT AS THE VICE PRESIDENT OF WHIDBEY ISLAND BANK, TO BE THE FREE AND VOLUNTARY ACT OF SUCH PARTY FOR THE USES AND PURPOSES MENTIONED IN THE INSTRUMENT.

DATED June 17, 2009

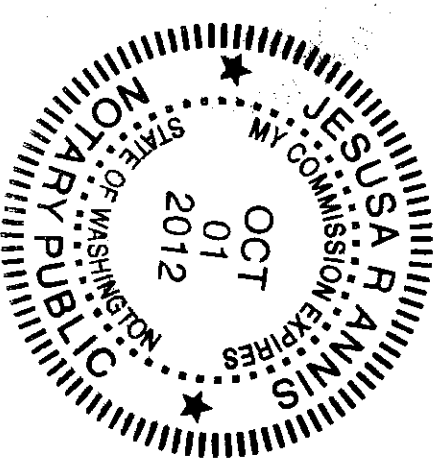

SIGNATURE *[Signature]*
NOTARY PUBLIC
MY APPOINTMENT EXPIRES 10-1-12
RESIDING AT Burlington

LEGAL DESCRIPTION OF LAND WITHIN THE CONDOMINIUM

PARCEL "A"

LOTS 1, 2 AND 3, SHORT PLAT NO. 94-002, APPROVED JUNE 7, 1994, RECORDED JUNE 23, 1994, IN VOLUME II OF SHORT PLATS, PAGE 87, UNDER AUDITOR'S FILE NO. 9406230071, AND BEING A PORTION OF THE EAST 1/2 OF THE SOUTHEAST 1/4 OF SECTION 3, TOWNSHIP 34 NORTH, RANGE 2 EAST, N.M.

EXCEPT THAT PORTION OF LOTS 1 AND 2 DESCRIBED AS FOLLOWS:

BEGINNING AT THE SOUTHEAST CORNER OF SAID LOT 2;
THENCE NORTH 89°31'02" WEST ALONG THE SOUTH LINE OF LOTS 2 AND 1, A DISTANCE OF 177.98 FEET;
THENCE NORTH 01°51'34" EAST A DISTANCE OF 293.00 FEET;
THENCE SOUTH 60°20'18" EAST A DISTANCE OF 119.82 FEET;
THENCE SOUTH 01°51'34" WEST A DISTANCE OF 43.28 FEET;
THENCE SOUTH 87°31'02" EAST A DISTANCE OF 12.00 FEET TO THE EAST LINE OF SAID LOT 2;
THENCE SOUTH 01°51'34" WEST ALONG SAID EAST LINE A DISTANCE OF 15.00 FEET TO THE POINT OF BEGINNING.

ALSO, EXCEPT THE SOUTH 160.00 FEET OF LOT 3, AS MEASURED PERPENDICULAR TO THE SOUTH LINE OF SAID LOT 3.

PARCEL "B"

THAT PORTION OF LOTS 1 AND 2, SHORT PLAT NO. 94-002, APPROVED JUNE 7, 1994, RECORDED JUNE 23, 1994, IN VOLUME II OF SHORT PLATS, PAGE 87, UNDER AUDITOR'S FILE NO. 9406230071, AND BEING A PORTION OF THE EAST 1/2 OF THE SOUTHEAST 1/4 OF SECTION 3, TOWNSHIP 34 NORTH, RANGE 2 EAST, N.M. DESCRIBED AS FOLLOWS:

BEGINNING AT THE SOUTHEAST CORNER OF SAID LOT 2;
THENCE NORTH 89°31'02" WEST ALONG THE SOUTH LINE OF LOTS 2 AND 1, A DISTANCE OF 177.98 FEET;
THENCE NORTH 01°51'34" EAST A DISTANCE OF 293.00 FEET;
THENCE SOUTH 60°20'18" EAST A DISTANCE OF 119.82 FEET;
THENCE SOUTH 01°51'34" WEST A DISTANCE OF 43.28 FEET;
THENCE SOUTH 87°31'02" EAST A DISTANCE OF 12.00 FEET TO THE EAST LINE OF SAID LOT 2;
THENCE SOUTH 01°51'34" WEST ALONG SAID EAST LINE A DISTANCE OF 15.00 FEET TO THE POINT OF BEGINNING.

PARCEL "C"

THE SOUTH 160.00 FEET, AS MEASURED PERPENDICULAR TO THE SOUTH LINE OF LOT 3, SHORT PLAT NO. 94-002, APPROVED JUNE 7, 1994, RECORDED JUNE 23, 1994, IN VOLUME II OF SHORT PLATS, PAGE 87, UNDER AUDITOR'S FILE NO. 9406230071, AND BEING A PORTION OF THE EAST 1/2 OF THE SOUTHEAST 1/4 OF SECTION 3, TOWNSHIP 34 NORTH, RANGE 2 EAST, N.M.


ALL THE ABOVE BEING SUBJECT TO AND TOGETHER WITH EASEMENTS, RESERVATIONS, RESTRICTIONS, COVENANTS, LIENS, LEASES, COURT CAUSES AND OTHER INSTRUMENTS OF RECORD.

SITUATE IN THE COUNTY OF SKAGIT, STATE OF WASHINGTON.

SURVEYORS CERTIFICATE


I HEREBY DECLARE THAT THIS SURVEY MAP AND PLANS FOR QUANTUM BUSINESS PARK CONDOMINIUM ARE BASED UPON AN ACTUAL SURVEY OF THE PROPERTY HEREIN DESCRIBED; THAT THE BEARINGS AND DISTANCES OF PROPERTY LINES AND HORIZONTAL AND VERTICAL UNIT BOUNDARIES ARE CORRECTLY SHOWN; AND THAT INFORMATION REQUIRED BY RCW 64.34.232 IS SUPPLIED HEREIN.

DATE: June 11, 2009
BRUCE G. LISGER, PLS, CERTIFICATE NO. 22960
LISGER & ASSOCIATES, PLLC
320 MILWAUKEE ST/PO BOX 1104
MOUNT VERNON, WA 98273
PHONE: (360) 419-1442 FAX: (360) 419-0581
E-MAIL: BRUCE@LISGER.COM

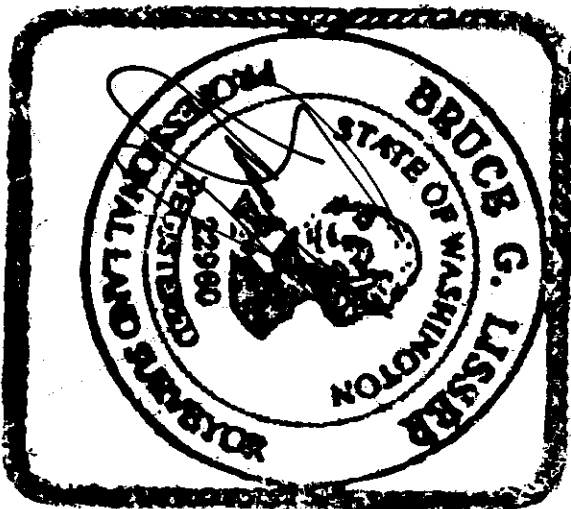

AUDITOR'S CERTIFICATE

FILED FOR RECORD AT THE REQUEST OF LISGER & ASSOCIATES, PLLC.

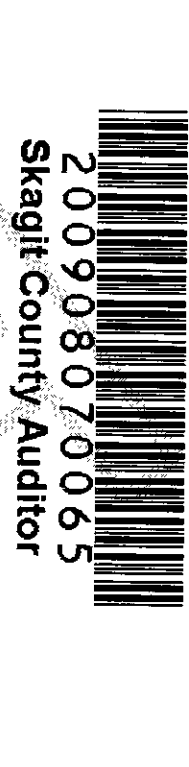

8/7/2009 Page 1 of 12 11:47AM

200908070065


Skagit County Auditor

J. Youngquist
SKAGIT COUNTY AUDITOR

[Signature]
DEPUTY

DECLARATION REFERENCE

THE CONDOMINIUM DECLARATION PREPARED PURSUANT TO THE WASHINGTON CONDOMINIUM ACT FOR THE CONDOMINIUM TO WHICH THIS SURVEY AND SET OF PLANS REFER, WAS RECORDED WITH THE AUDITOR OF SKAGIT COUNTY, WASHINGTON, ON August 7, 2009 UNDER AUDITOR'S FILE NO. 200908070065 RECORDS OF SKAGIT COUNTY, WASHINGTON.

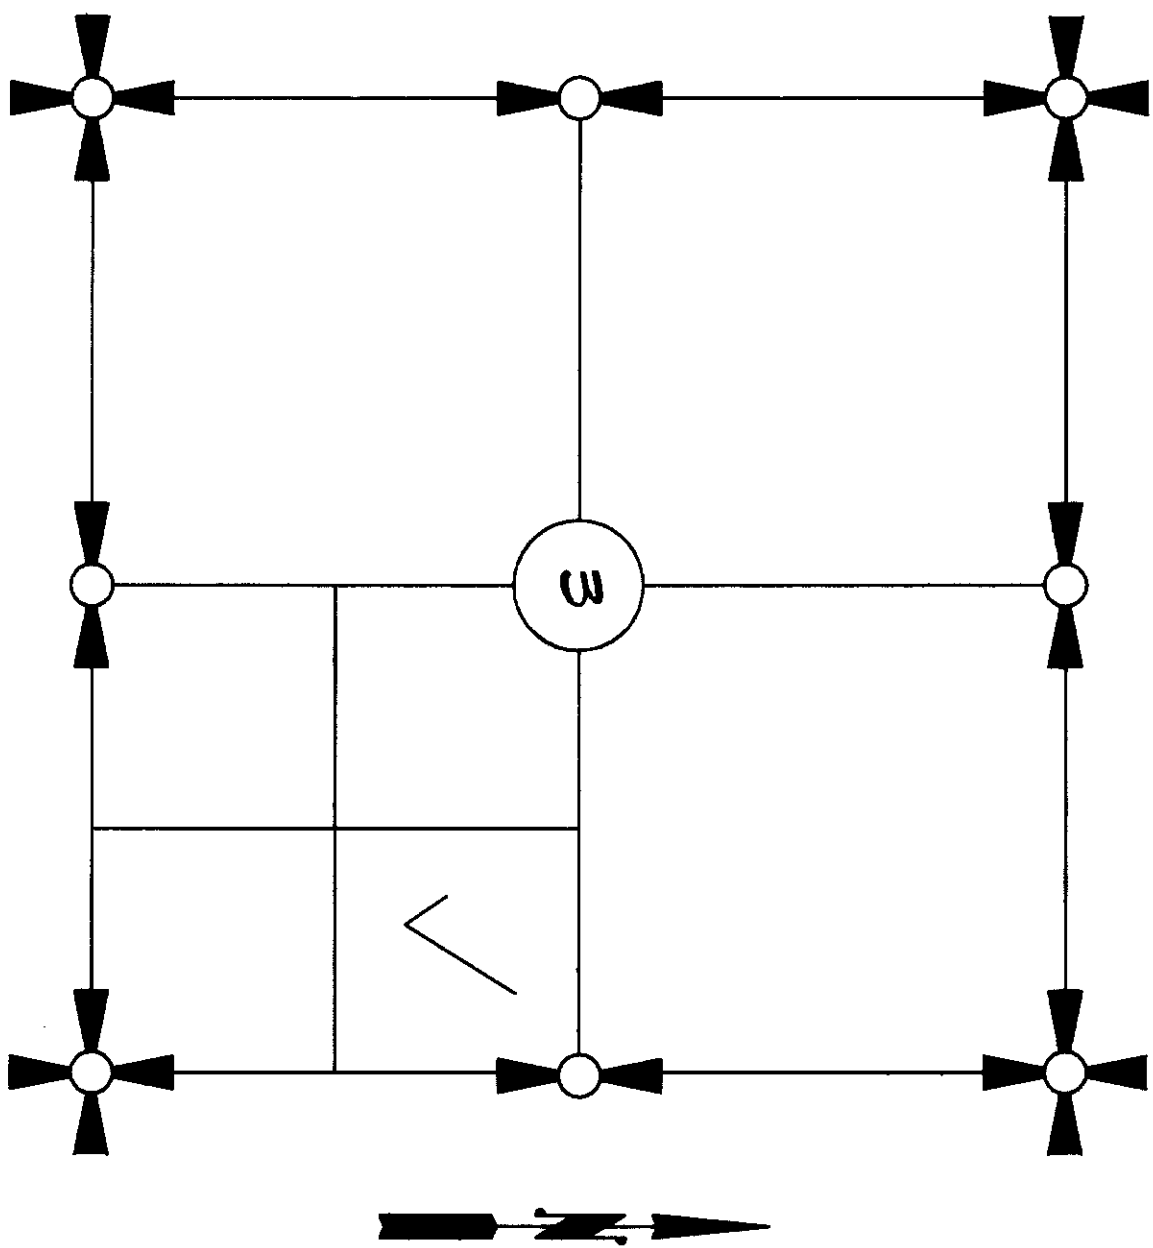

SECTION 3, TOWNSHIP 34 NORTH, RANGE 2 EAST, N.M.

VICINITY MAP

SHEET 1 OF 12

DATE: 6/5/09

QUANTUM BUSINESS PARK CONDOMINIUM

SURVEY IN A PORTION OF THE SOUTHEAST 1/4 OF
SECTION 3, TOWNSHIP 34 NORTH, RANGE 2 EAST, N.M.
SKAGIT COUNTY, WASHINGTON

FOR: QUANTUM BUSINESS PARK, LLC

FB 305 Pg 63 LISGER & ASSOCIATES, PLLC SCALE: 1" = 40'
SURVEYING & LAND-USE CONSULTATION 360-419-1442 DRAWING: 04-016505
MOUNT VERNON, WA 98273

SURVEY MAP AND PLANS FOR
QUANTUM BUSINESS PARK CONDOMINIUM




200908070065
Skagit County Auditor
8/7/2009 Page 2 of 12 12:11:47AM

NOTES

- INDICATES REBAR SET WITH YELLOW CAP INSCRIBED L15GER 22460
 - INDICATES MONUMENT IN CASE
 - INDICATES EXISTING REBAR OR IRON PIPE FOUND
- DESCRIPTION FOR THIS SURVEY IS FROM LAND TITLE COMPANY, MISCELLANEOUS GUARANTEE ORDER NO. 133133-PA, DATED APRIL 3, 2004.
- INSTRUMENTATION: LEICA TCR 705A THEODOLITE DISTANCE METER, PENTAX AFL-240 LEVEL
- SURVEY PROCEDURE: STANDARD FIELD TRAVERSE
- MERIDIAN: ASSUMED
- BASIS OF BEARING: MONUMENTED EAST LINE OF LOT 3, SHORT PLAT NO. 94-002
BEARING = NORTH 2°04'51" EAST
- FOR ADDITIONAL MERIDIAN AND SURVEY INFORMATION SEE SHORT PLAT NO. 94-002 RECORDED UNDER AUDITOR'S FILE NO. 9406230071, RECORDS OF SKAGIT COUNTY, WASHINGTON.
- DATUM: NGVD 29
- BENCH MARK: SOUTHEAST CORNER BASE OF POWER VAULT BETWEEN BUILDINGS 4 AND 5
ELEVATION = 101.64 NGVD29
- BUILDING LOCATIONS AND DIMENSIONS REFER TO EXTERIOR WALLS AND ARE SHOWN IN FEET AND TENTHS OF FEET.
- FLOOR AND CEILING ELEVATIONS ARE SHOWN IN FEET AND TENTHS OF FEET TO TOP OF EXISTING FLOOR AND BOTTOM OF EXISTING CEILING.
- INTERIOR DIMENSIONS ARE SHOWN IN FEET AND TENTHS OF FEET AND REPRESENT INTERIOR MEASUREMENTS TO FACE OF EXISTING INTERIOR WALL.
- BOUNDARY OF INTERIOR UNITS EXTEND TO BACK OF SHEET ROCK (IF APPLICABLE) AND TOP OF FLOOR.
- THIS PROPERTY IS SUBJECT TO AND TOGETHER WITH EASEMENTS, RESERVATIONS, RESTRICTIONS, COVENANTS, LIENS, LEASES, COURT CAUSES AND OTHER INSTRUMENTS OF RECORD INCLUDING BUT NOT LIMITED TO THOSE MENTIONED ON THAT CERTAIN TITLE REPORT DESCRIBED IN NOTE 2 ABOVE. SAID REPORT INCLUDES DOCUMENTS RECORDED UNDER SKAGIT COUNTY AUDITOR'S FILE NUMBERS 9306080065, 9406250105, 737854, 9406230071, 9412060006, 8406160031, 9506050067, 9506050068, 9506050069, 9609200033, AND 9506140052.
- UTILITY LOCATIONS ARE PER VISUAL FIELD LOCATIONS AND/OR ENGINEERING PLANS PROVIDED BY OWNER. LOCATIONS ARE REPRESENTATIONAL ONLY. UTILITY COMPANIES SHOULD BE CONTACTED TO VERIFY SPECIFIC LOCATIONS.
- THIS SURVEY WAS PREPARED AT THE REQUEST OF QUANTUM BUSINESS PARK LLC, A WASHINGTON LIMITED LIABILITY COMPANY FOR THE PURPOSES OF PREPARING A CONDOMINIUM SURVEY IN APRIL, 2004.
- THIS SURVEY HAS SHOWN OCCUPATIONAL INDICATORS (FENCE LINES) PER W.A.C. CHAPTER 332.130. LINES OF OCCUPATIONS MAY INDICATE AREAS FOR POTENTIAL CLAIMS OF UNWRITTEN OWNERSHIP. THIS SURVEY HAS ONLY SHOWN THE RELATIONSHIP OF LINES OF OCCUPATION TO THE DEEDED LINES OF RECORD. NO RESOLUTION OF OWNERSHIP BASED ON UNWRITTEN RIGHTS HAS BEEN MADE OR IMPLIED BY THIS SURVEY.
- UNIT ADDRESS INFORMATION
 - BUILDING 112746 QUANTUM LANE
 - BUILDING 24895 PADILLA HEIGHTS ROAD
 - BUILDING 34889 PADILLA HEIGHTS ROAD
 - BUILDING 412107 QUANTUM LANE
 - BUILDING 512729 QUANTUM LANE
 - BUILDING 612743 QUANTUM LANE
 - BUILDING 712761 QUANTUM LANE
 - BUILDING 812756 QUANTUM LANE
- SOME BUILDINGS ARE SHOWN WITH A DASHED LINE BETWEEN INTERIOR UNITS. THESE DASHED LINES REPRESENT PLANE BOUNDARY LINES AND EXIST INDEPENDENTLY FROM CONSTRUCTED WALLS AS PROVIDED IN SECTION 4.2.2 OF THE DECLARATION.
- EACH PARKING AREA DEPICTED HEREON IS A LIMITED COMMON ELEMENT WHICH IS OR MAY BE ALLOCATED AS SET FORTH ON EXHIBIT C TO THE DECLARATION.

NOTES CONTINUED

- SOME BUILDINGS ARE SHOWN WITH A DASHED LINE BETWEEN INTERIOR UNITS. THESE DASHED LINES REPRESENT PLANE BOUNDARY LINES AND EXIST INDEPENDENTLY FROM CONSTRUCTED WALLS AS PROVIDED IN SECTION 4.2.2 OF THE DECLARATION.
- EACH PARKING AREA P-1 THROUGH P-16 DEPICTED HEREON IS A LIMITED COMMON ELEMENT WHICH IS OR MAY BE ALLOCATED AS SET FORTH ON EXHIBIT C TO THE DECLARATION.
- DUMPSTER FACILITIES D-1 THROUGH D-10 DEPICTED HEREON ARE LIMITED COMMON ELEMENTS ALLOCATED AS SET FORTH IN EXHIBIT B TO THE DECLARATION.


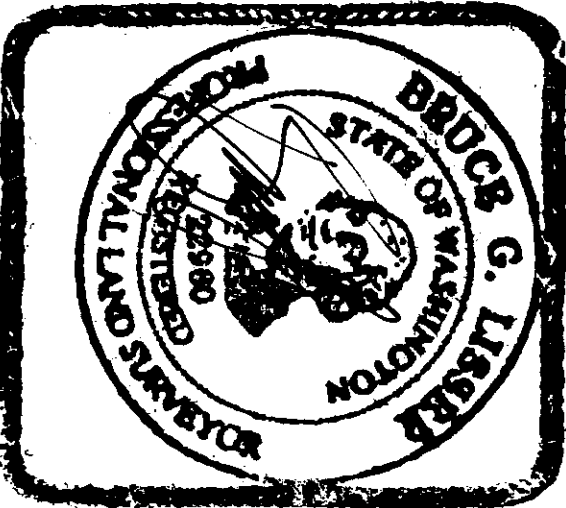


G-11-09

SHEET 2 OF 12		DATE: 6/8/04	
QUANTUM BUSINESS PARK CONDOMINIUM			
SURVEY IN A PORTION OF THE SOUTHEAST 1/4 OF SECTION 3, TOWNSHIP 34 NORTH, RANGE 2 EAST, W.M. SKAGIT COUNTY, WASHINGTON			
FOR: QUANTUM BUSINESS PARK, LLC			
FB 305	PG 63	LIGSER & ASSOCIATES, PLLC	SCALE: 1" = 40'
MERIDIAN: ASSUMED		SURVEYING & LAND-USE CONSULTATION MOUNT VERNON, WA 98275 360-419-1442	DRAWING: 04-016605


SURVEY MAP AND PLANS FOR
QUANTUM BUSINESS PARK CONDOMINIUM

200908070065
Skagit County Auditor
8/7/2008 Page 3 of 12 12:11:47AM

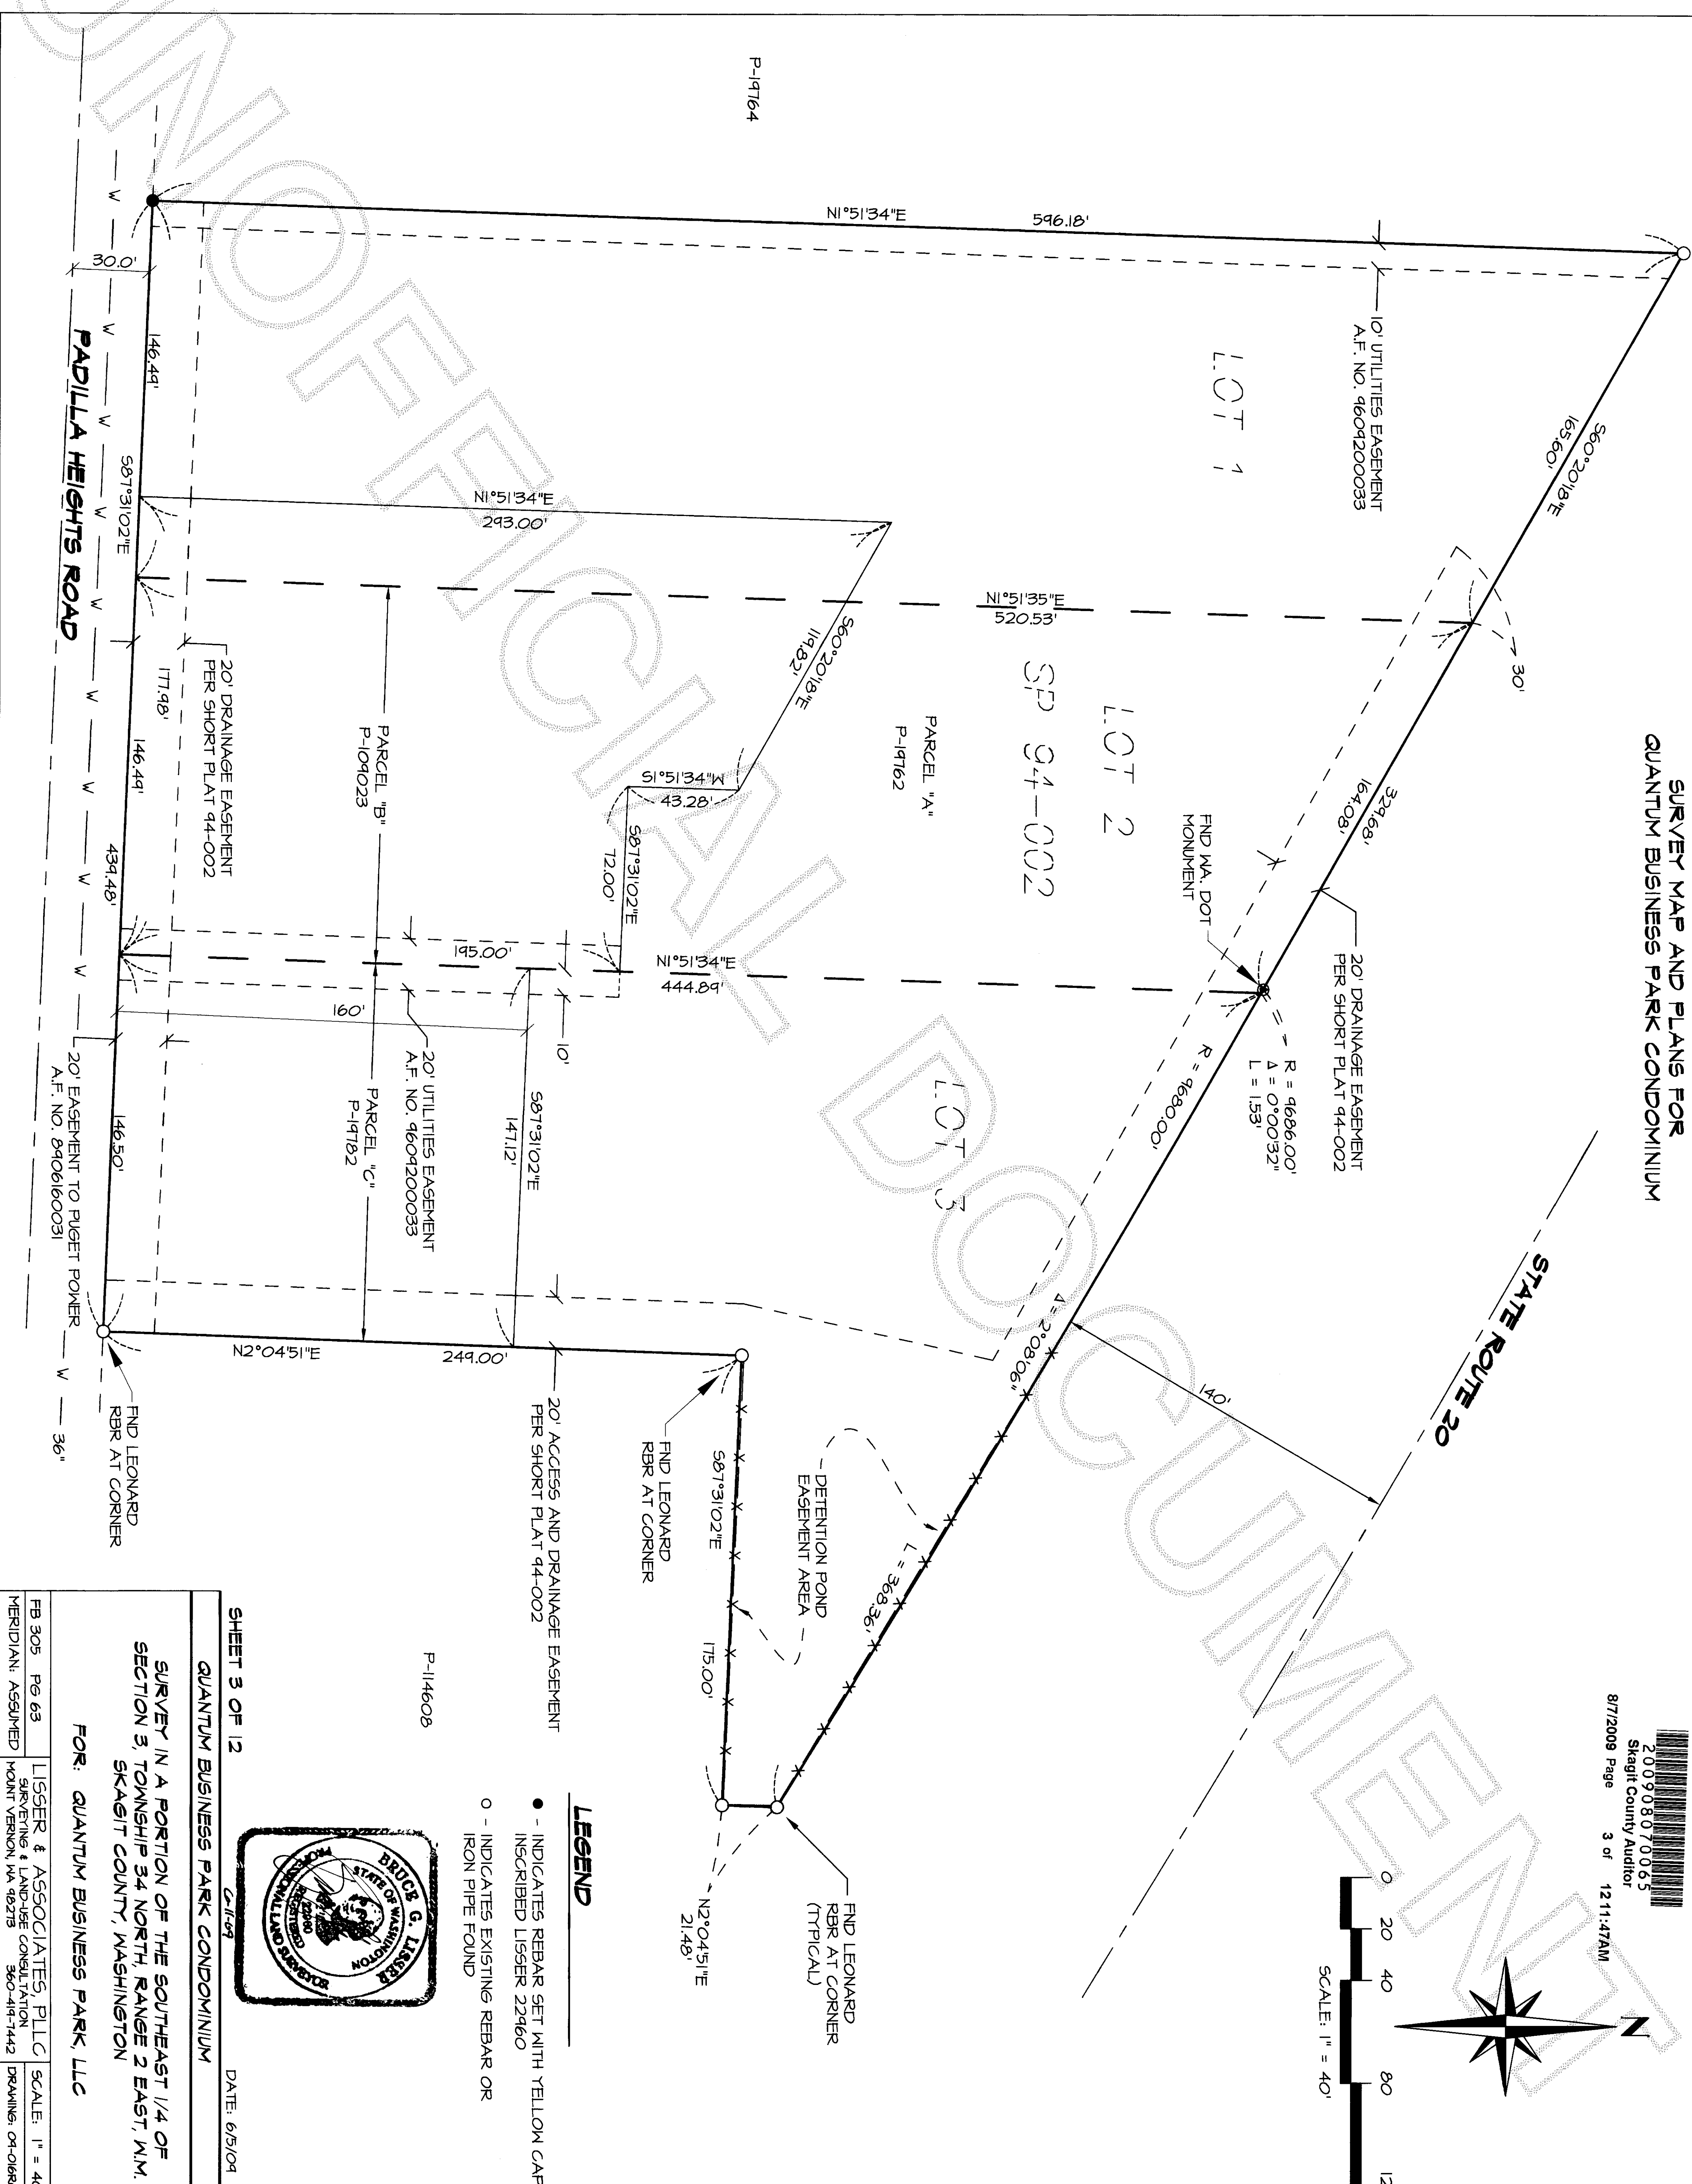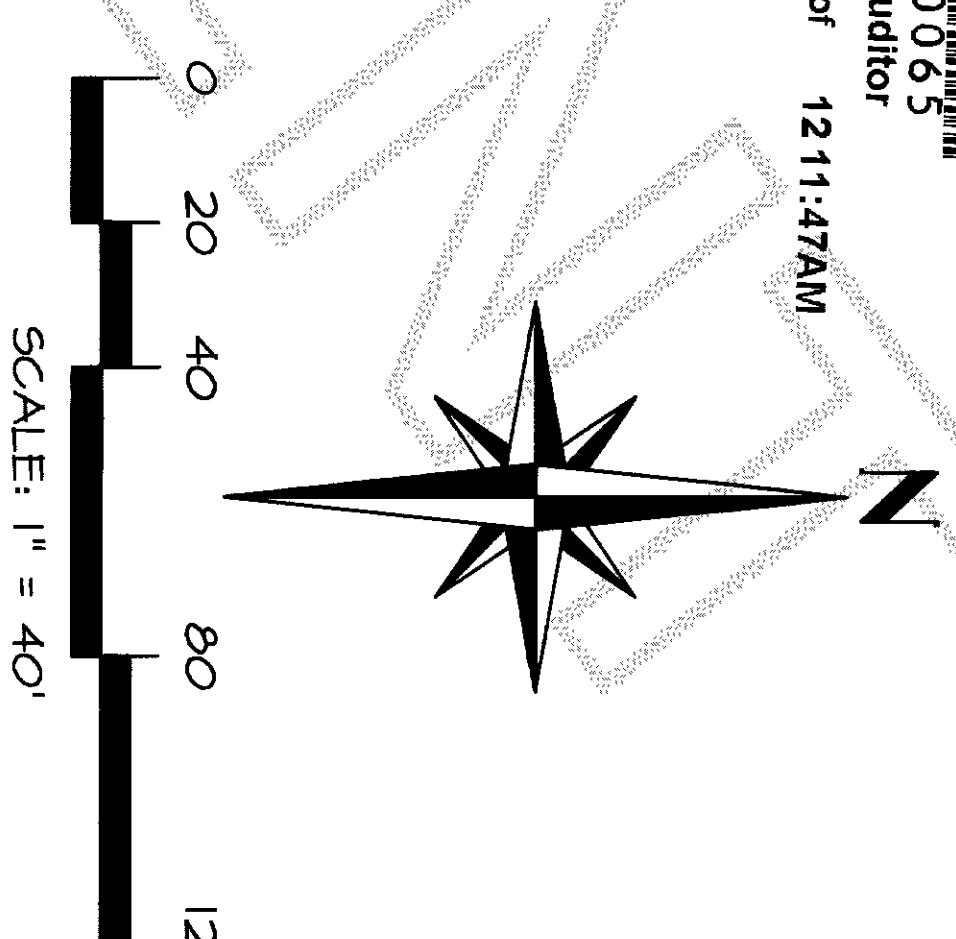

LEGEND

- - INDICATES REBAR SET WITH YELLOW CAP INSCRIBED L155ER 22460
- - INDICATES EXISTING REBAR OR IRON PIPE FOUND

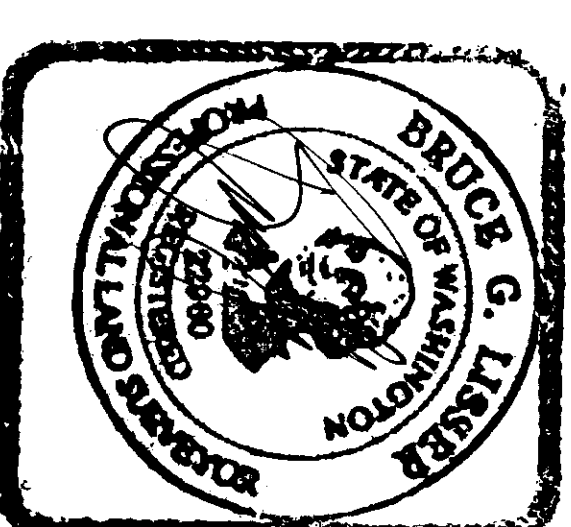

SHEET 3 OF 12 DATE: 6/5/04


QUANTUM BUSINESS PARK CONDOMINIUM

SURVEY IN A PORTION OF THE SOUTHEAST 1/4 OF
SECTION 3, TOWNSHIP 34 NORTH, RANGE 2 EAST, W.M.
SKAGIT COUNTY, WASHINGTON

FOR: QUANTUM BUSINESS PARK, LLC

FB 305	PG 63	L155ER & ASSOCIATES, PLLC	SCALE: 1" = 40'
MERIDIAN: ASSUMED		SURVEYING & LAND USE CONSULTATION MOUNT VERNON, WA 98275 360-417-1442	DRAWING: 04-016605

SURVEY MAP AND PLANS FOR
QUANTUM BUSINESS PARK CONDOMINIUM

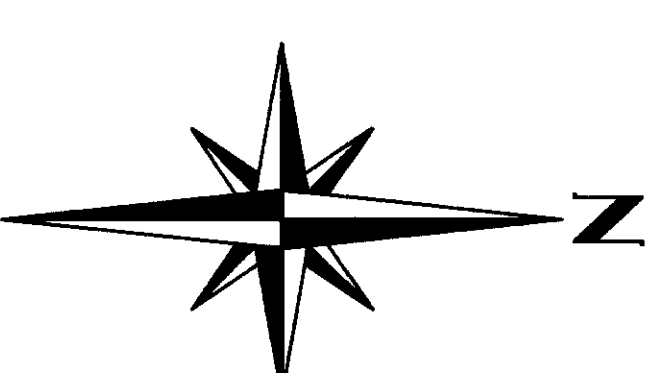


LEGEND

- INDICATES REBAR SET WITH YELLOW CAP INSCRIBED L1568R 22460
- INDICATES EXISTING REBAR OR IRON PIPE FOUND
- WATER METER (WM)
- POWER VAULT
- HYDRANT
- UTILITY POLE (PP)
- CLEAN OUT (C.O.)
- SAN. SEWER MANHOLE (SSMH)
- STORM DRAIN CATCH BASIN (CB)
- STORM DRAIN MANHOLE (SDMH)
- MAIL BOX
- SIGN
- ROCKERY
- WATER VALVE (WV)
- SANITARY SEWER LINE
- STORM DRAIN LINE
- FENCE
- INTERIOR WALL/JUNT DIVISION
- FUTURE INTERIOR WALL/JUNT DIVISION (SEE NOTE 19 ON SHEET 2 OF 12)
- LANDSCAPE
- LIMITED COMMON ELEMENTS (SEE NOTE 20 ON SHEET 2 OF 12)
- LIMITED COMMON ELEMENTS (SEE NOTE 21 ON SHEET 2 OF 12)
- UNDERGROUND POWER LINE
- CONCRETE PUMP COVER



SANITARY SEWER LINE
(NOT FIELD LOCATED)
TO BE UTILIZED AT SUCH TIME
AS CITY OF ANACORTES SEWER
IS EXTENDED TO THE SITE
(INACTIVE AT THIS TIME)

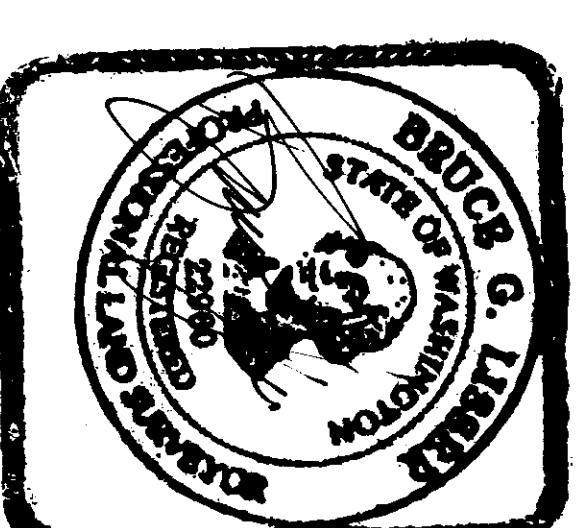

SHEET 4 OF 12

QUANTUM BUSINESS PARK CONDOMINIUM


DATE: 6/8/04

SURVEY IN A PORTION OF THE SOUTHEAST 1/4 OF
SECTION 3, TOWNSHIP 34 NORTH, RANGE 2 EAST, N.M.,
SKAGIT COUNTY, WASHINGTON

FOR: QUANTUM BUSINESS PARK, LLC


FB 305	PG 63	LISSENER & ASSOCIATES, PLLC	SCALE: 1" = 40'
MERIDIAN: ASSURED		SURVEYING & LAND USE CONSULTATION MOUNT VERNON, WA 98275 360-415-1142	DRAWING: 04-016605

200908070065
Skagit County Auditor
8/7/2009 Page 5 of 12 11:47AM

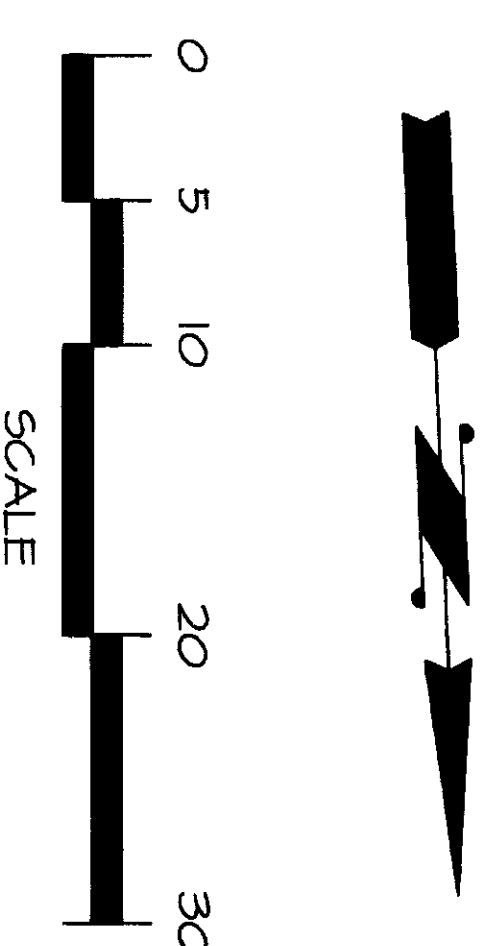


SURVEY MAP AND PLANS FOR
QUANTUM BUSINESS PARK CONDOMINIUM

200908070065
Skagit County Auditor
8/7/2008 Page 6 of 12 11:47AM

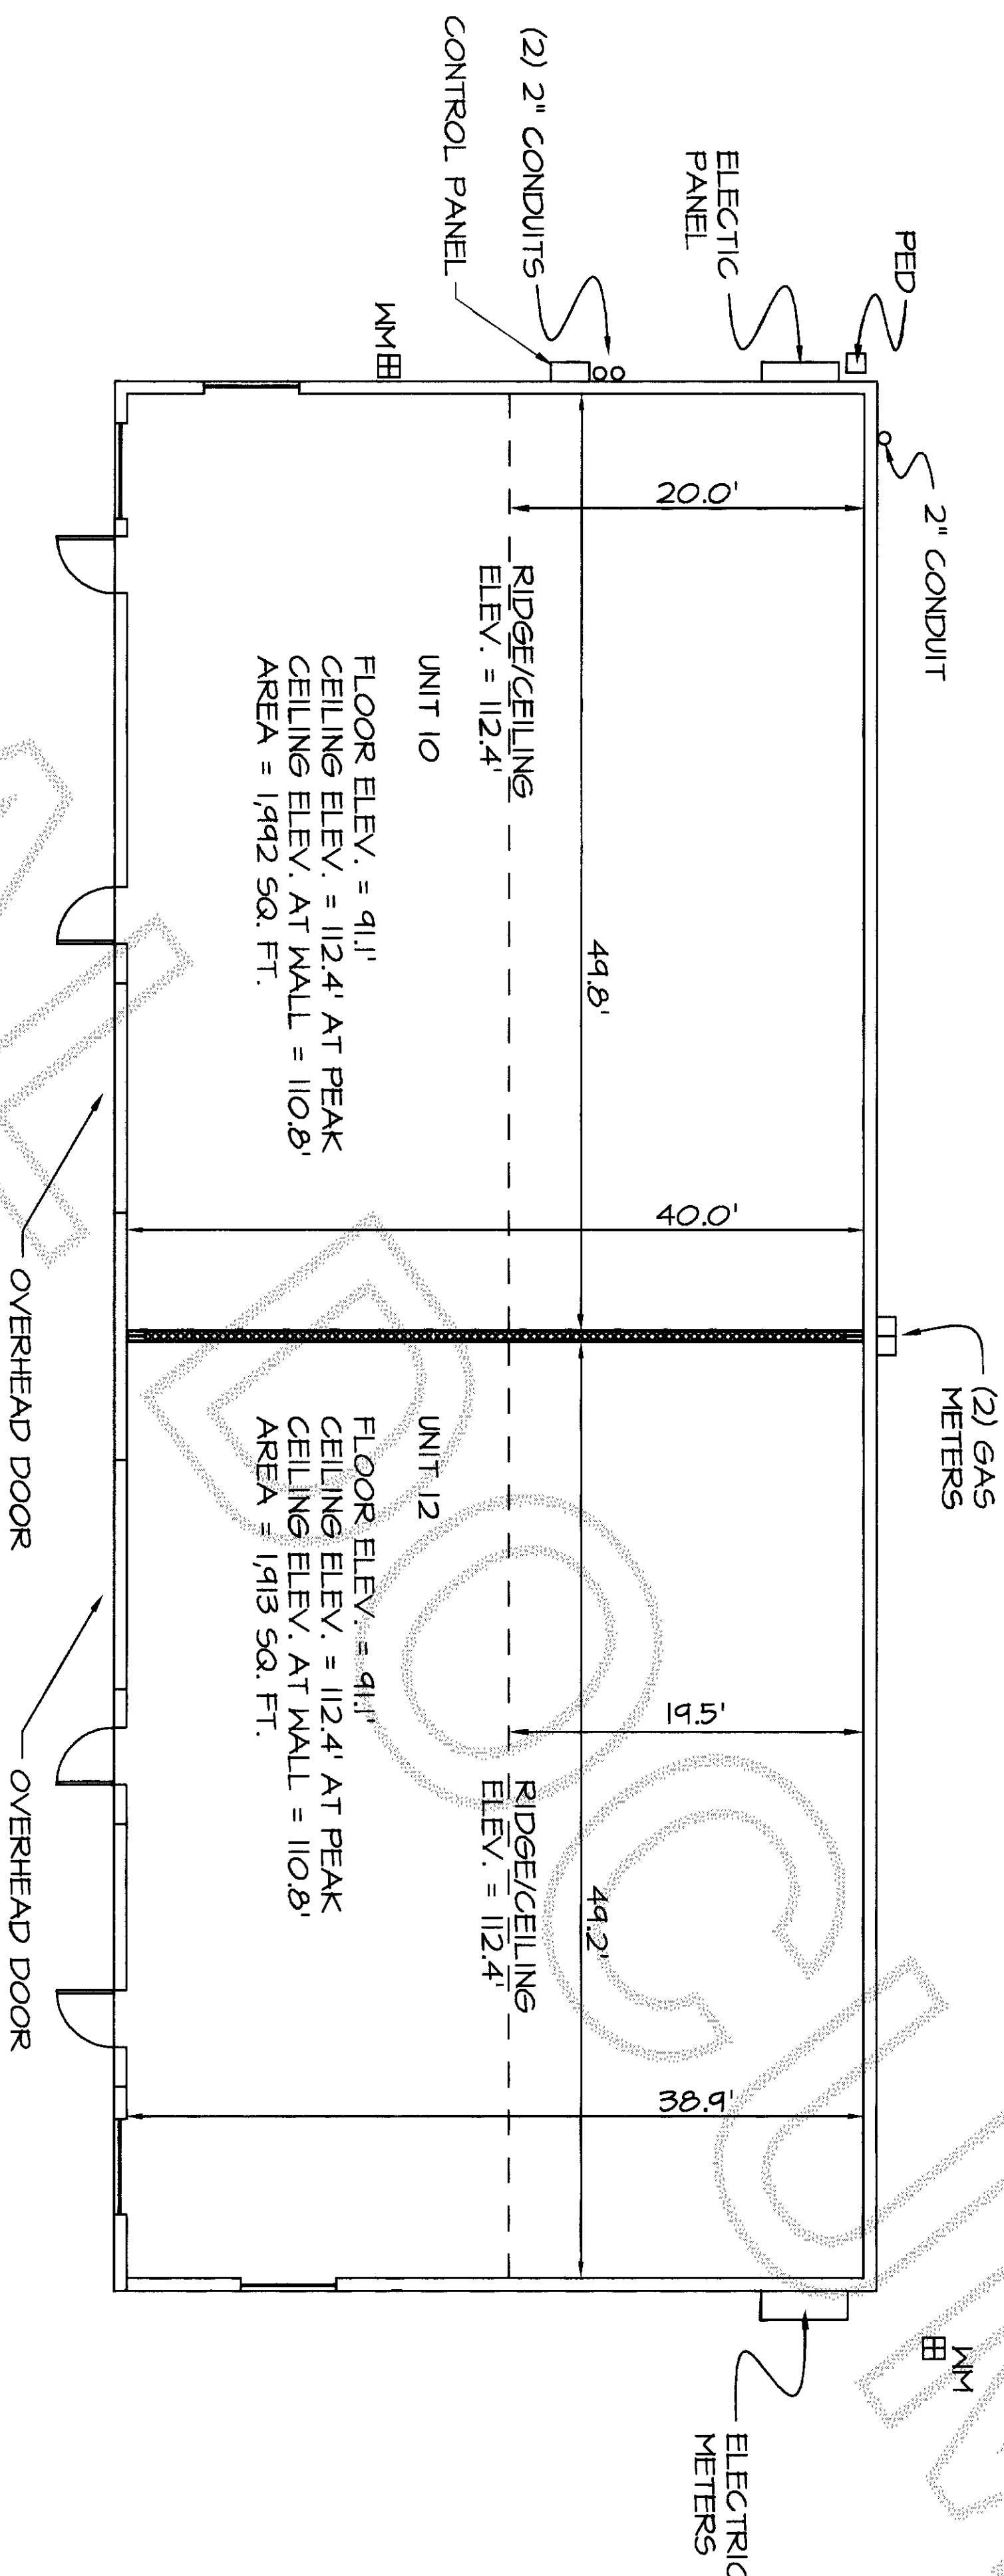

BUILDING 2, UNITS 10 AND 12
(AS-CONSTRUCTED MEASUREMENTS)

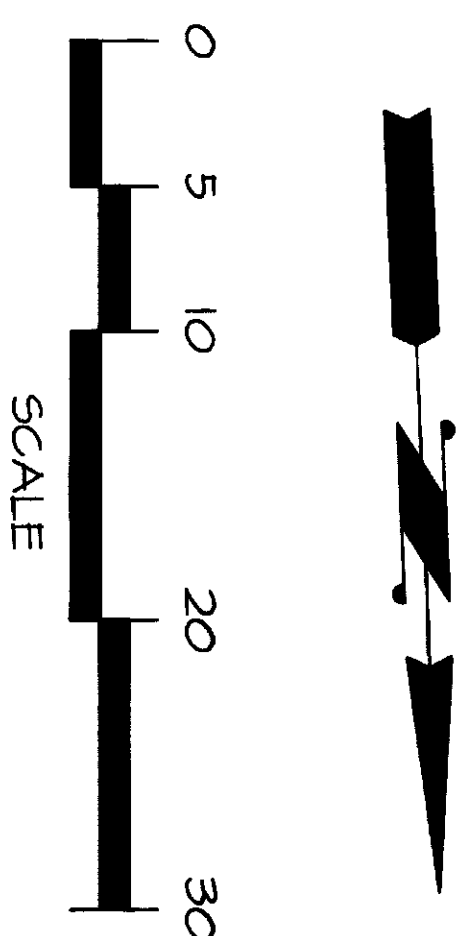

SHEET 6 OF 12

6-11-09

DATE: 6/5/04

QUANTUM BUSINESS PARK CONDOMINIUM


SURVEY IN A PORTION OF THE SOUTHEAST 1/4 OF
SECTION 3, TOWNSHIP 34 NORTH, RANGE 2 EAST, N.M.
SKAGIT COUNTY, WASHINGTON

FOR: QUANTUM BUSINESS PARK, LLC



FB 305	PG 63	LISSEY & ASSOCIATES, PLLC	SCALE: 1" = 10'
MERIDIAN: ASSIGNED	SURVEYING & LAND-USE CONSULTATION	360-414-1442	DRAWING: 04-016825
MOUNT VERNON, WA 98275			

SURVEY MAP AND PLANS FOR
QUANTUM BUSINESS PARK CONDOMINIUM

200908070065
Skagit County Auditor
8/7/2009 Page 7 of 12 11:47AM

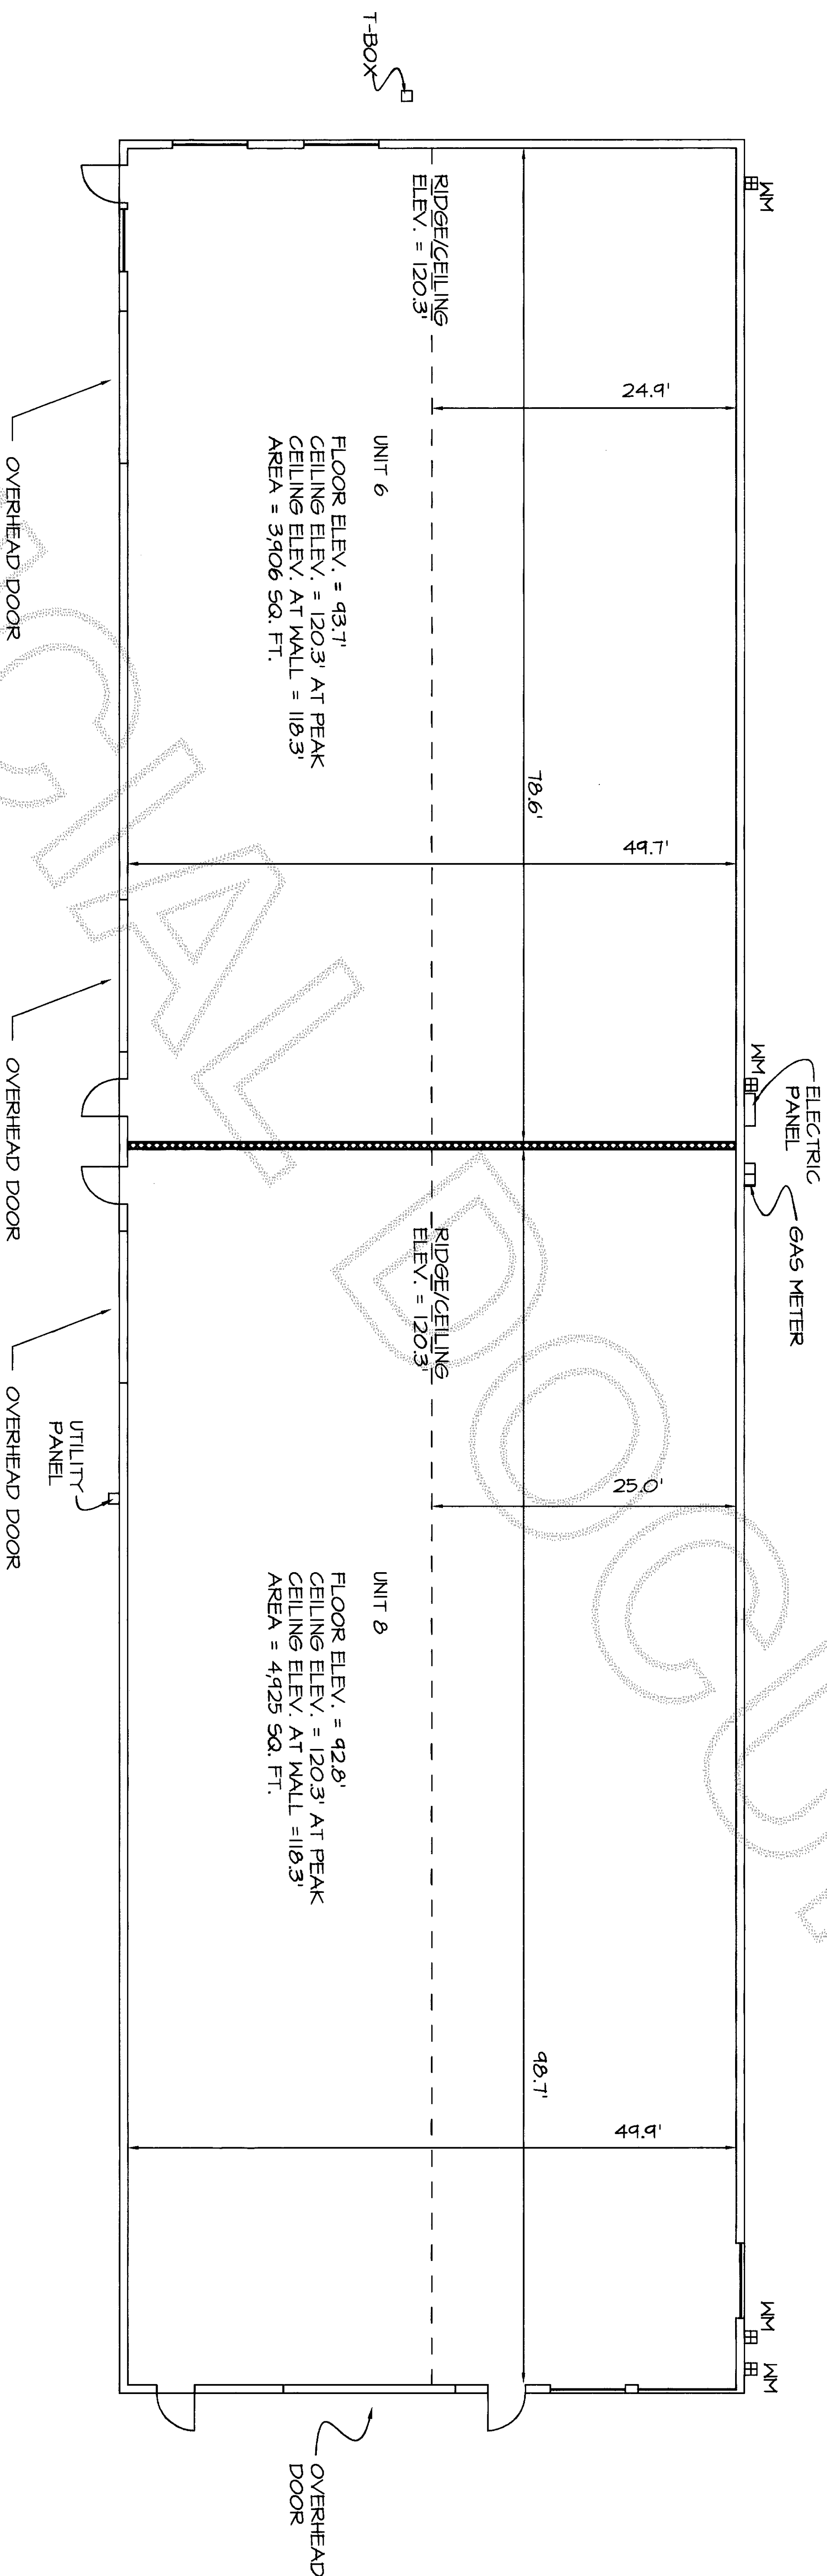

BUILDING 3, UNITS 6 AND 8
(AS-CONSTRUCTED MEASUREMENTS)

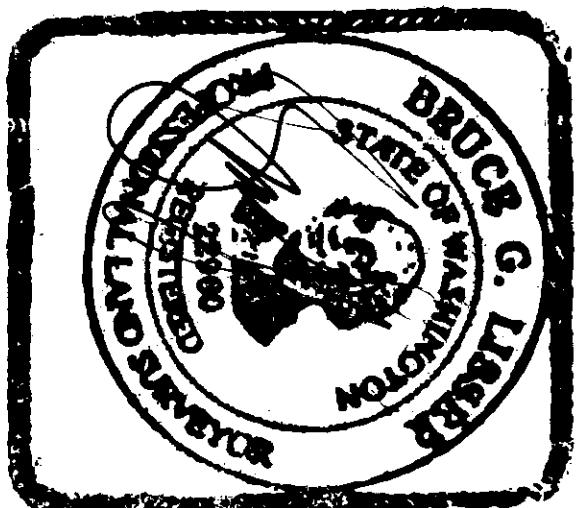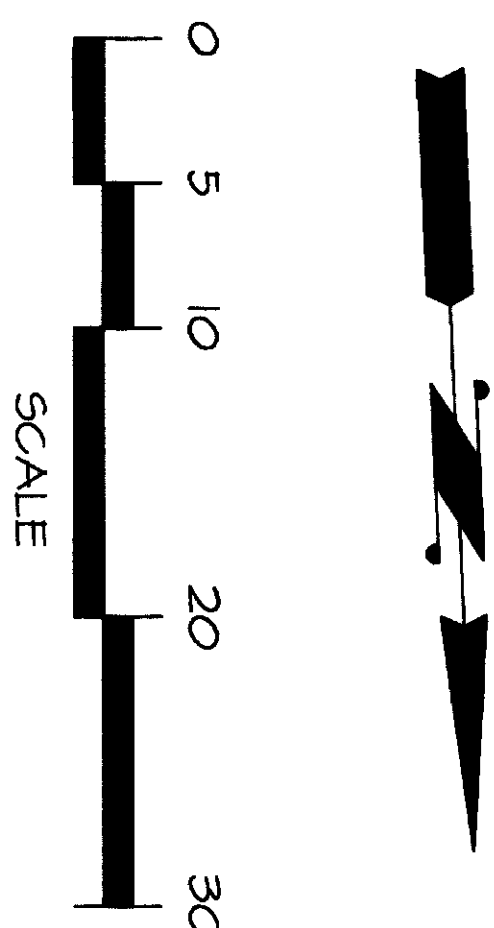

SHEET 7 OF 12

DATE: 6/5/04

QUANTUM BUSINESS PARK CONDOMINIUM


SURVEY IN A PORTION OF THE SOUTHEAST 1/4 OF
SECTION 3, TOWNSHIP 34 NORTH, RANGE 2 EAST, W.M.
SKAGIT COUNTY, WASHINGTON

FOR: QUANTUM BUSINESS PARK, LLC


FB 305 PG 63 LINDER & ASSOCIATES, PLLC SCALE: 1" = 10'
SURVEYING & LAND-USE CONSULTATION
MOUNT VERNON, WA 98275 360-414-1442 DRAWING: 04-016825

SURVEY MAP AND PLANS FOR
QUANTUM BUSINESS PARK CONDOMINIUM

200908070065
Skagit County Auditor
8/7/2009 Page 8 of 12 12:11:47AM

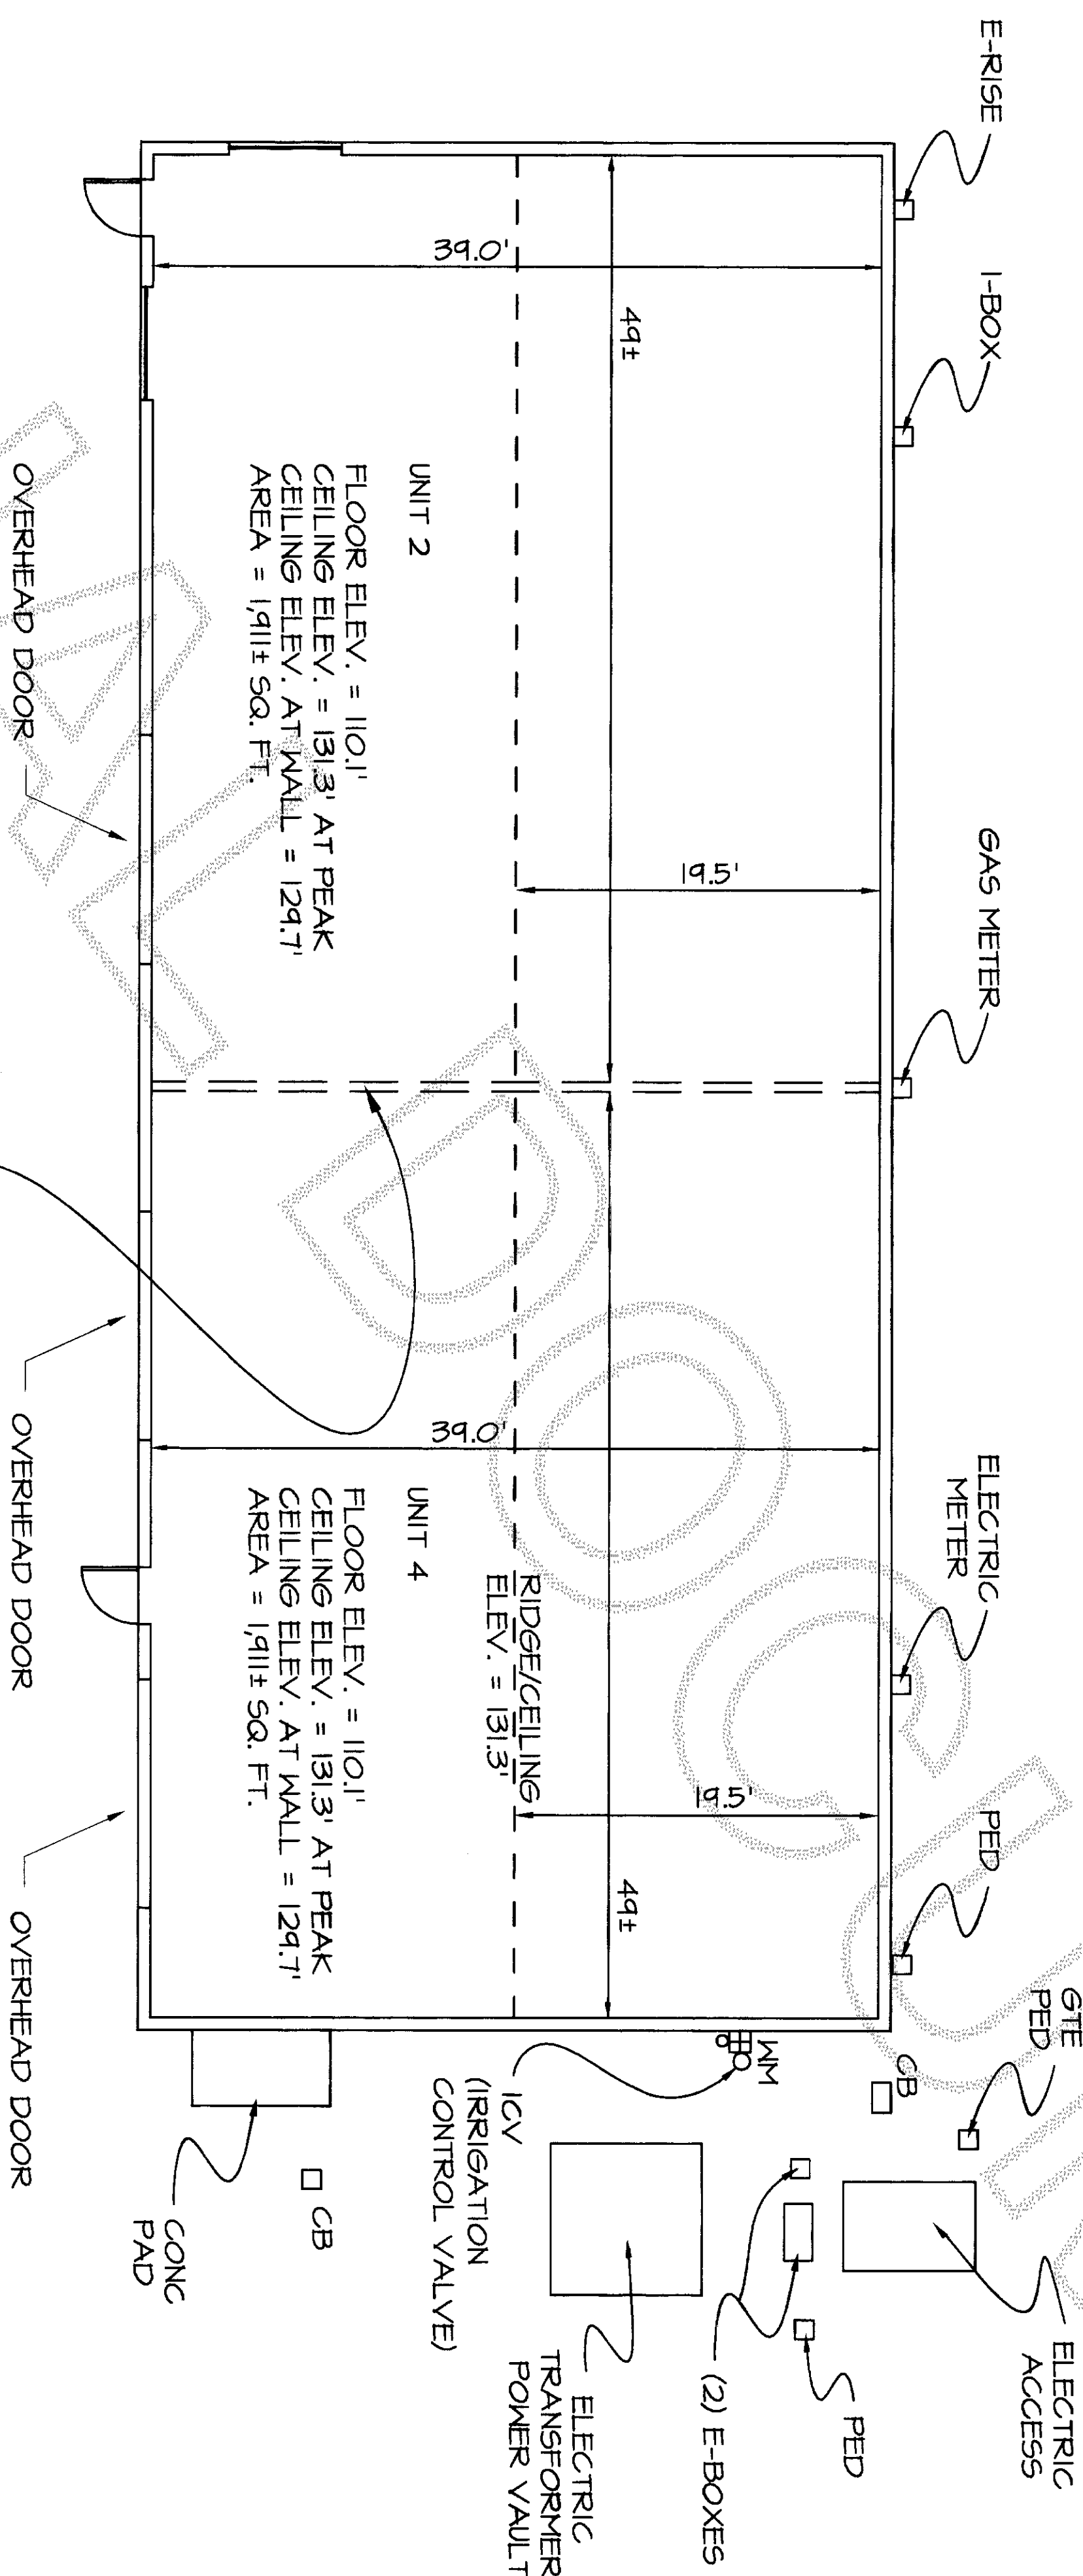

BUILDING 4, UNITS 2 AND 4
(AS-CONSTRUCTED MEASUREMENTS)

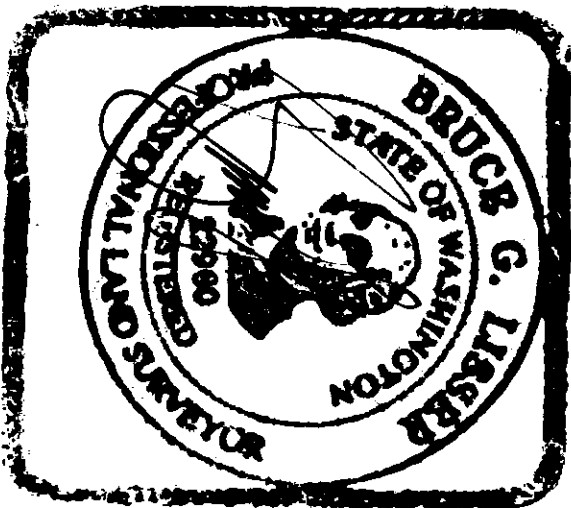

SHEET 8 OF 12

6-11-09

DATE: 6/5/04

QUANTUM BUSINESS PARK CONDOMINIUM


SURVEY IN A PORTION OF THE SOUTHEAST 1/4 OF
SECTION 3, TOWNSHIP 34 NORTH, RANGE 2 EAST, W.M.
SKAGIT COUNTY, WASHINGTON

FOR: QUANTUM BUSINESS PARK, LLC


FB 305 Pg 63	LISSEY & ASSOCIATES, PLLC	SCALE: 1" = 10'
MERIDIAN: ASSUMED	SURVEYING & LAND-USE CONSULTATION	DRAWING: 04-016R05
	MOUNT VERNON, WA 98275	360-419-7442

SURVEY MAP AND PLANS FOR
QUANTUM BUSINESS PARK CONDOMINIUM

200908070065
Skagit County Auditor
8/7/2009 Page 9 of 12 11:47AM

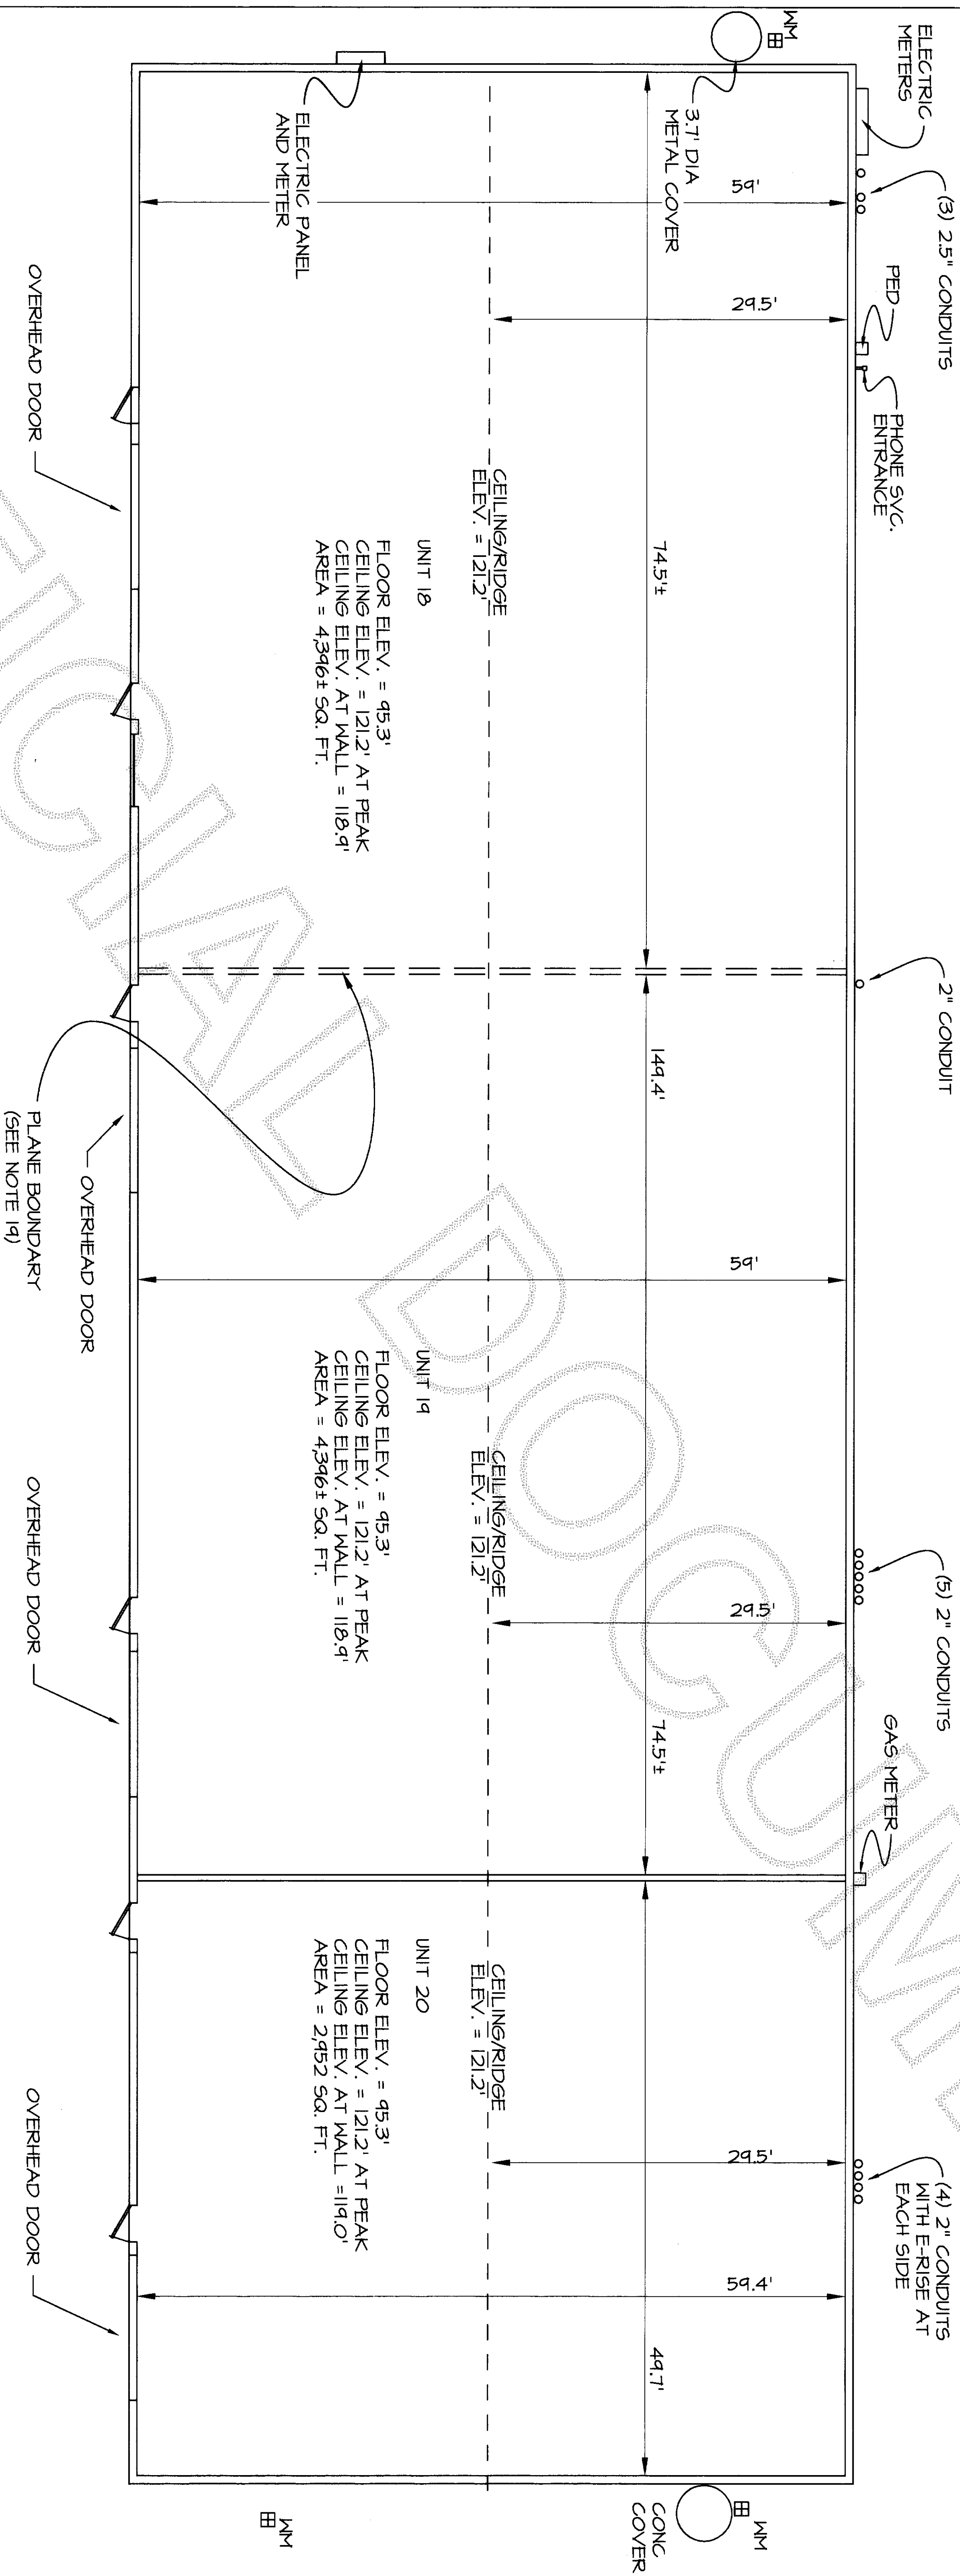

BUILDING 5, UNITS 18, 19 AND 20
(AS-CONSTRUCTED MEASUREMENTS)

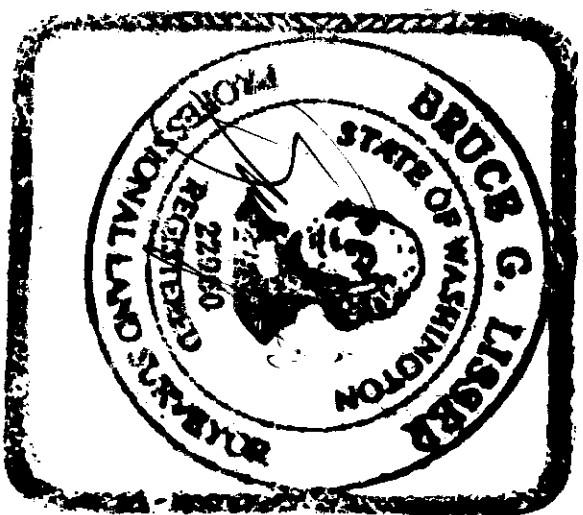

6-11-09

SHEET 9 OF 12

DATE: 6/5/09

QUANTUM BUSINESS PARK CONDOMINIUM


SURVEY IN A PORTION OF THE SOUTHEAST 1/4 OF
SECTION 3, TOWNSHIP 34 NORTH, RANGE 2 EAST, N.M.,
SKAGIT COUNTY, WASHINGTON

FOR: QUANTUM BUSINESS PARK, LLC




FB 305 Pg 63	LISSENER & ASSOCIATES, PLLC	SCALE: 1" = 10'
MERIDIAN: ASSUMED	SURVEYING & LAND-USE CONSULTATION POINT VERSION: WA 92715 360-419-1442	DRAWING: 04-016R05

SURVEY MAP AND PLANS FOR
QUANTUM BUSINESS PARK CONDOMINIUM

200908070065
Skagit County Auditor
8/7/2009 Page 10 of 12 11:47AM

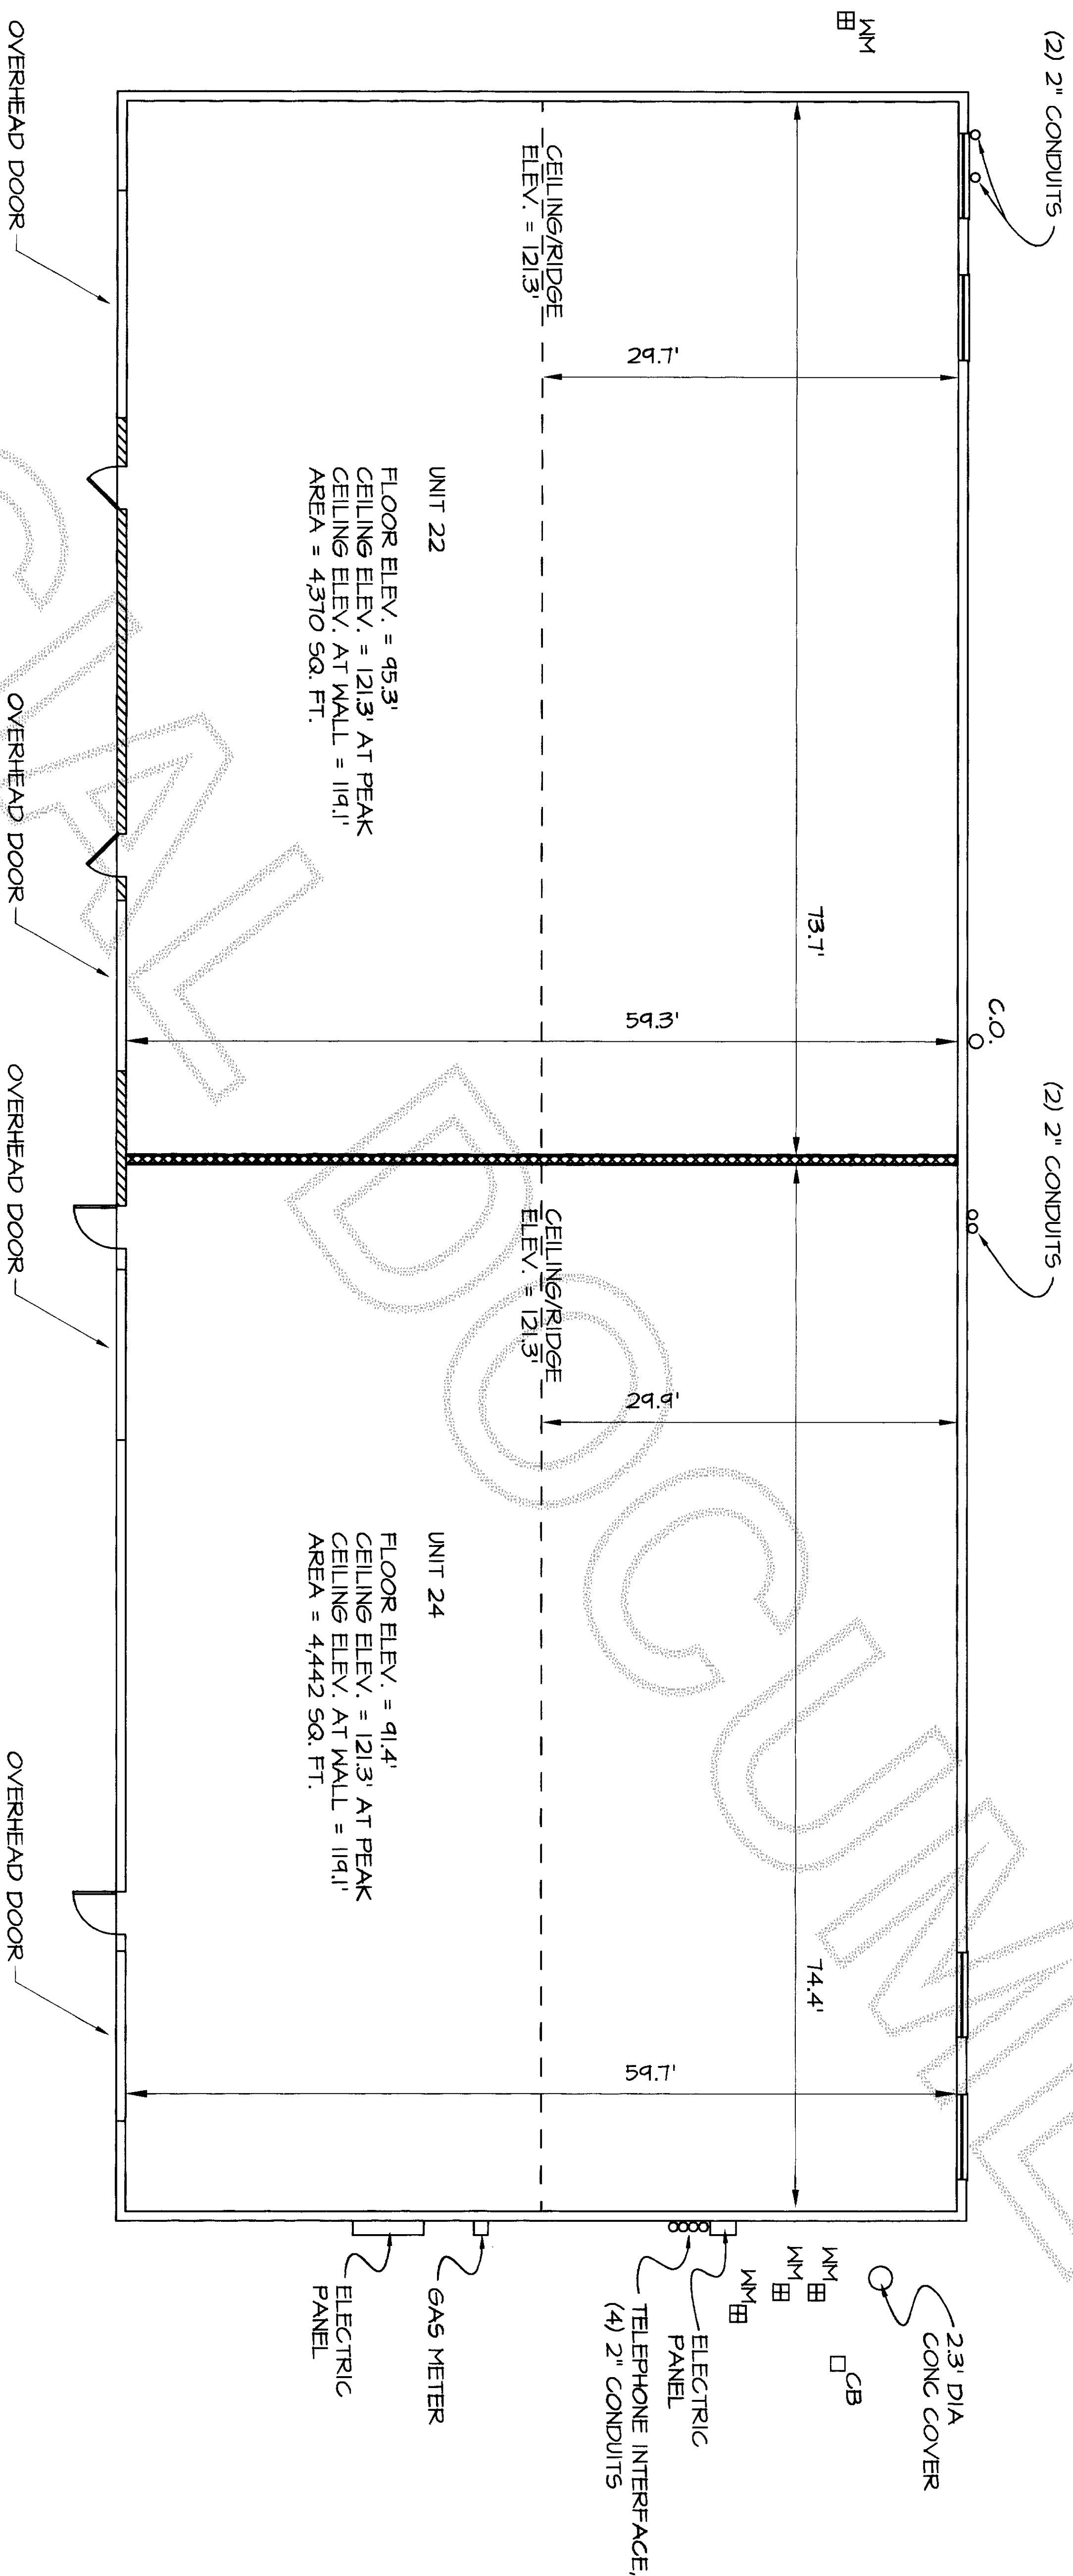

BUILDING 6, UNITS 22 AND 24
(AS-CONSTRUCTED MEASUREMENTS)

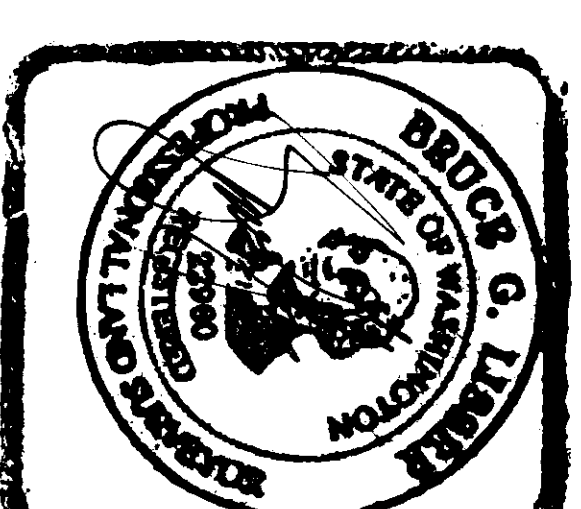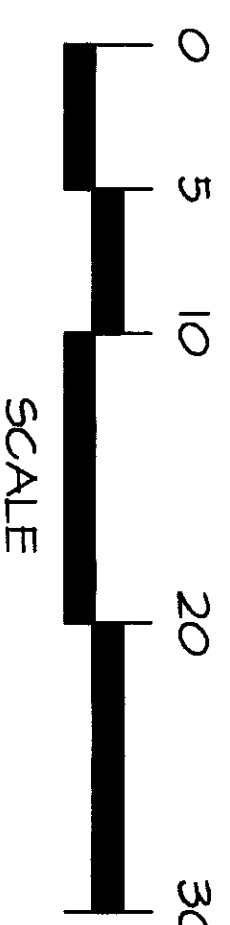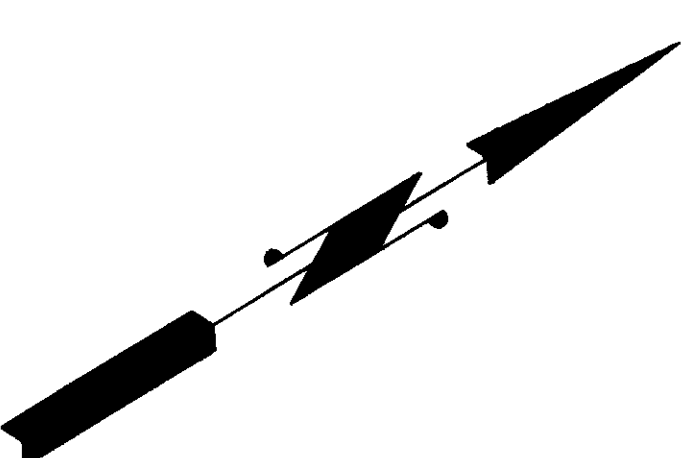

6-11-09

SHEET 10 OF 12

DATE: 6/5/09

QUANTUM BUSINESS PARK CONDOMINIUM


SURVEY IN A PORTION OF THE SOUTHEAST 1/4 OF
SECTION 3, TOWNSHIP 34 NORTH, RANGE 2 EAST, N.M.
SKAGIT COUNTY, WASHINGTON

FOR: QUANTUM BUSINESS PARK, LLC


FB 305	PG 63	LISSE & ASSOCIATES, PLLC	SCALE: 1" = 10'
MERIDIAN: ASSUMED	SURVEYING & LAND-USE CONSULTATION	360-414-1442	DRAWING: 09-016805
HOUT VERNON, WA 98215			

SURVEY MAP AND PLANS FOR
QUANTUM BUSINESS PARK CONDOMINIUM

200903070065
Skagit County Auditor
8/7/2009 Page 11 of 12 12:11:47AM

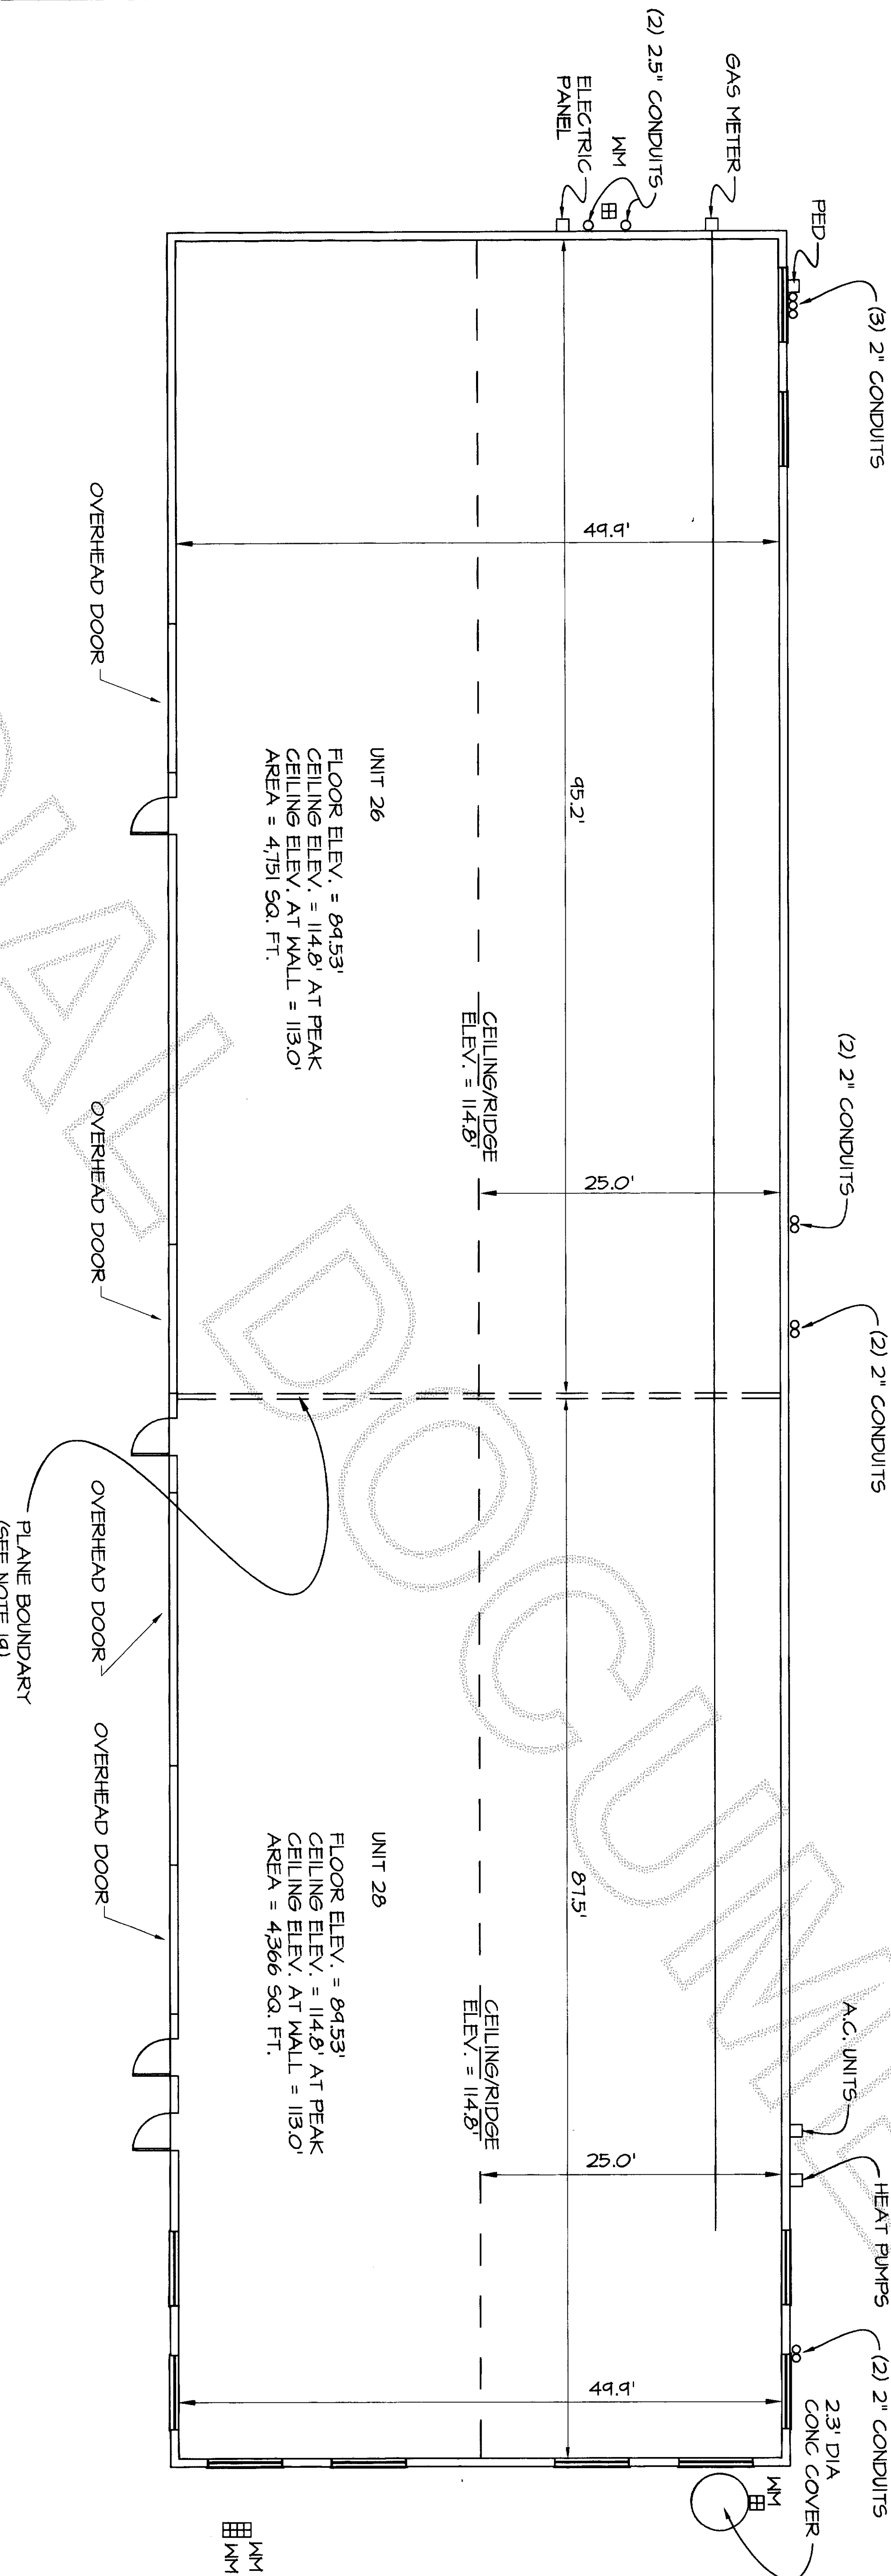

BUILDING 7, UNITS 26 AND 28
(AS-CONSTRUCTED MEASUREMENTS)

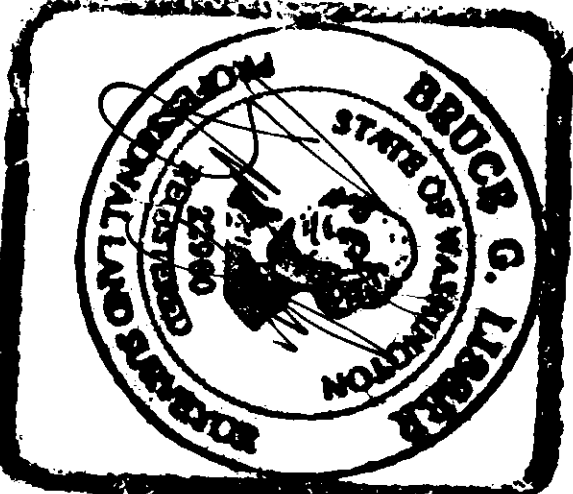

SHEET 11 OF 12 DATE: 6/5/04

QUANTUM BUSINESS PARK CONDOMINIUM


SURVEY IN A PORTION OF THE SOUTHEAST 1/4 OF
SECTION 3, TOWNSHIP 34 NORTH, RANGE 2 EAST, W.M.
SKAGIT COUNTY, WASHINGTON

FOR: QUANTUM BUSINESS PARK, LLC




FB 305 Pg 63	LISSNER & ASSOCIATES, PLLC	SCALE: 1" = 10'
MERIDIAN: ASSUMED	SURVEYING & LAND-USE CONSULTATION MOUNT VERNON, WA 98275 360-414-1442	DRAWING: 04-016805

SURVEY MAP AND PLANS FOR
QUANTUM BUSINESS PARK CONDOMINIUM

200908070065
Skagit County Auditor
8/7/2009 Page 12 of 12 11:47AM

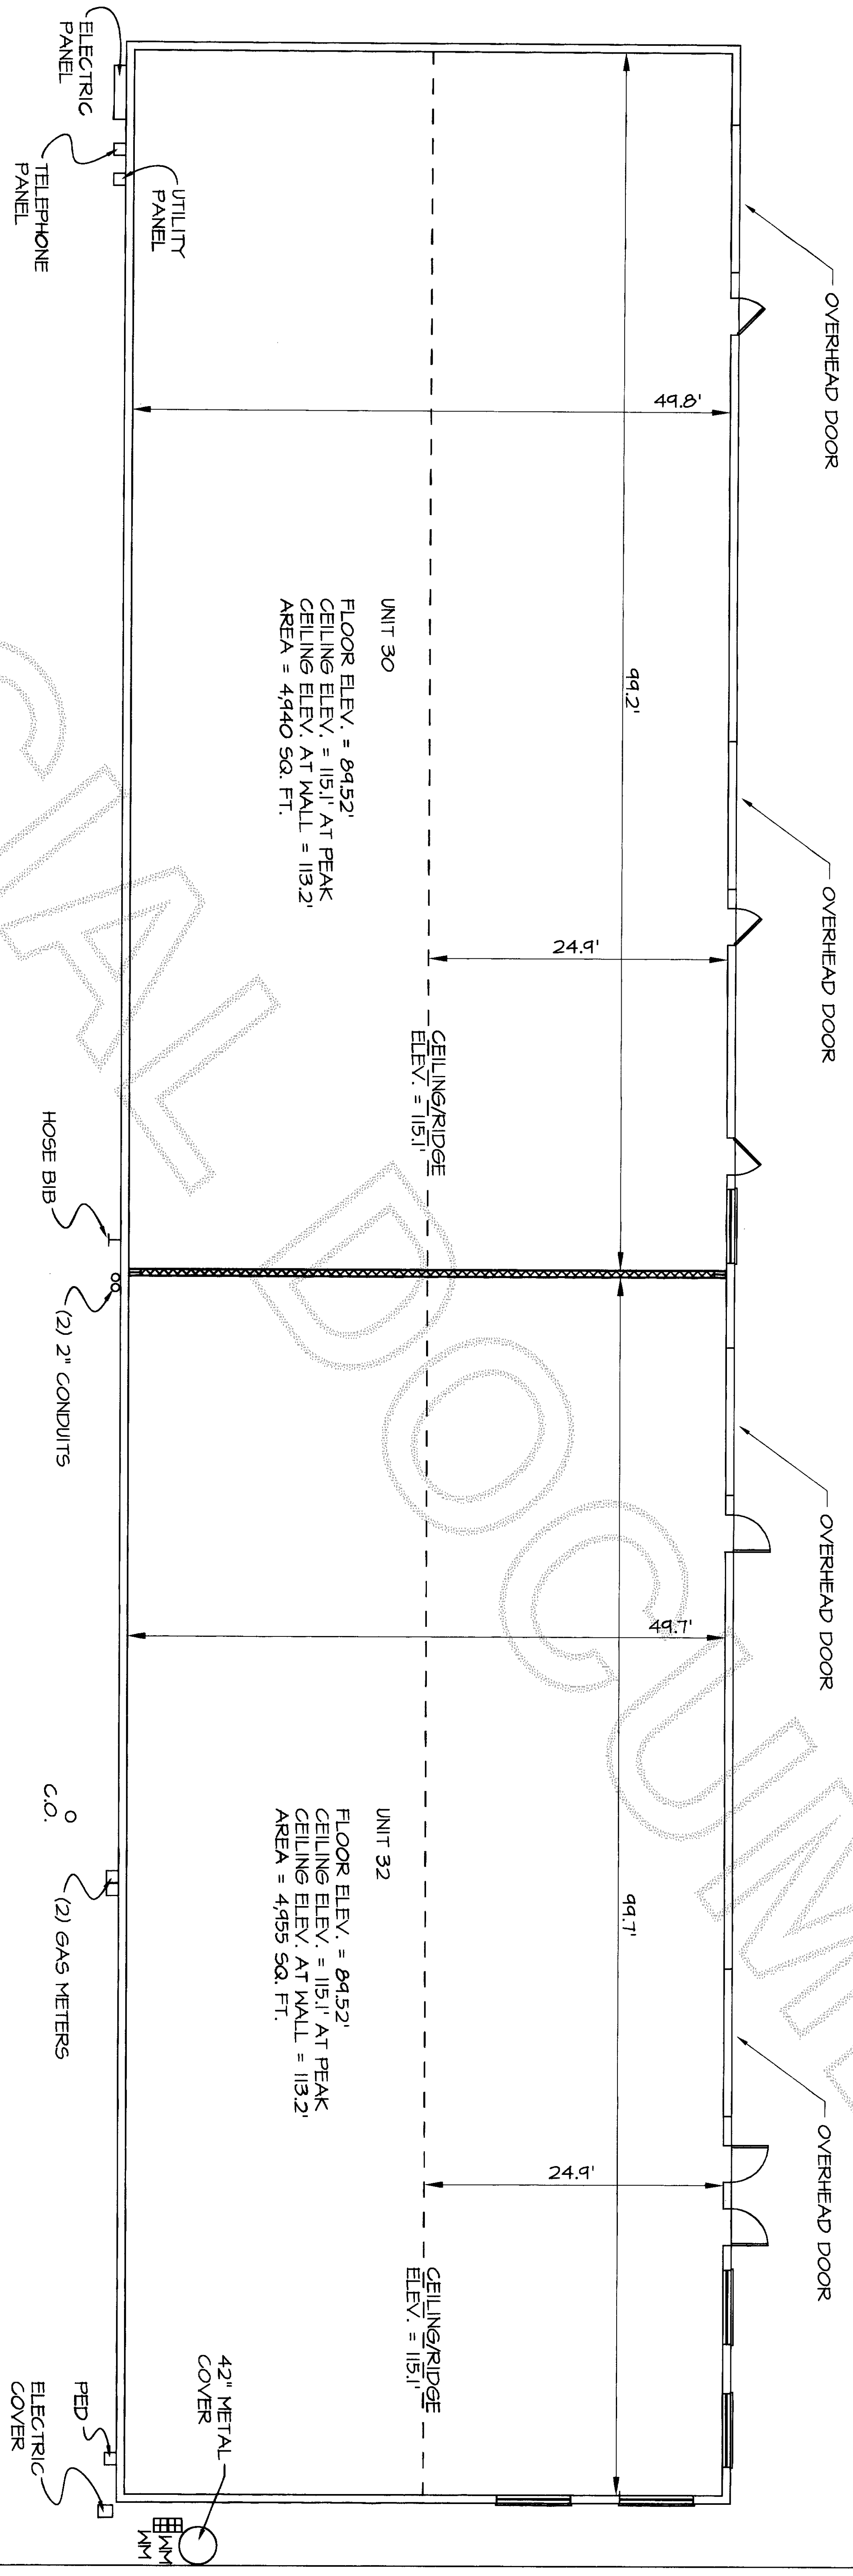

BUILDING 8, UNITS 30 AND 32
(AS-CONSTRUCTED MEASUREMENTS)

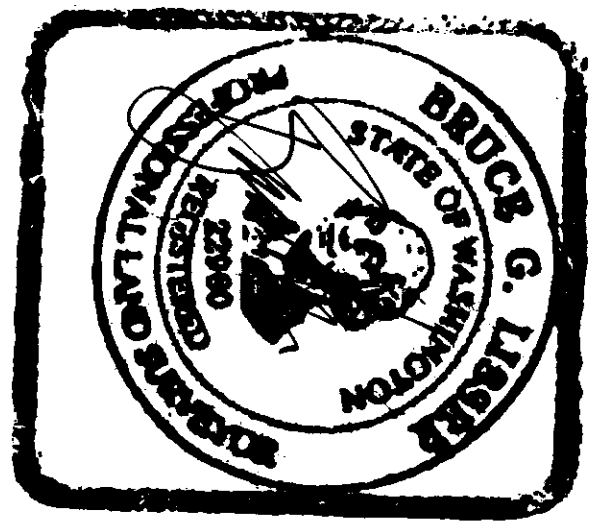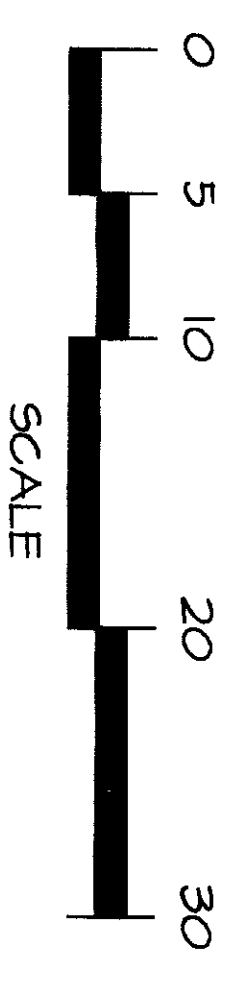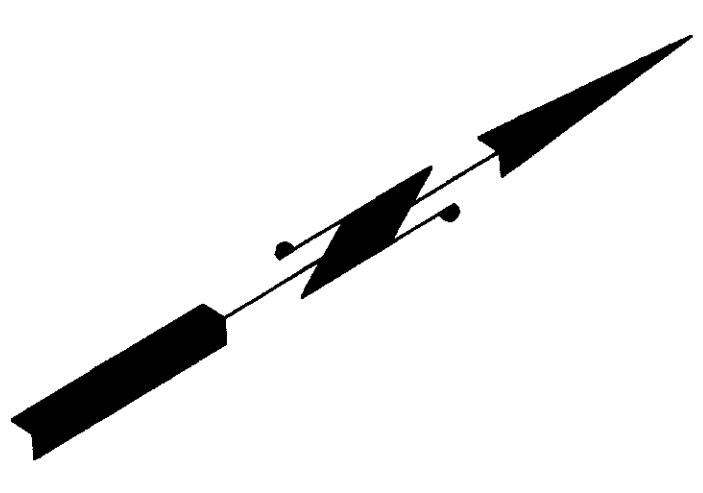

SHEET 12 OF 12 DATE: 6/5/09

QUANTUM BUSINESS PARK CONDOMINIUM

SURVEY IN A PORTION OF THE SOUTHEAST 1/4 OF
SECTION 3, TOWNSHIP 34 NORTH, RANGE 2 EAST, N.M.
SKAGIT COUNTY, WASHINGTON

FOR: QUANTUM BUSINESS PARK, LLC

FB 305 Pg 63	LISSNER & ASSOCIATES, PLLC	SCALE: 1" = 10'
MERIDIAN: ASSUMED	SURVEYING & LAND-USE CONSULTATION	DRAWING: 04-016805
	MOUNT VERNON, WA 98275	
	360-419-1442	