



Portions of the East Half of the Southwest Quarter and Government Lot 4 in Section 18, Township 35 North, Range 8 East, W.M. and the Southwest Quarter and Southeast Quarter of the Southeast Quarter of Section 13, Township 35 North, Range 7 East, W.M. in Skagit County, Washington (Page 1 of 3 Pages)

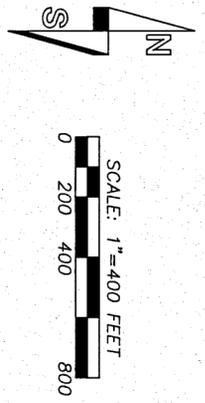

BASIS OF BEARINGS: N26°13'46\" E BETWEEN THE SOUTHWEST CORNER AND NORTH 1/4 CORNER OF SECTION 18, TOWNSHIP 35 NORTH, RANGE 8 EAST, W.M. AS PER RECORD OF SURVEY RECORDED IN BOOK 6 OF SURVEYS AT PAGE 208, RECORDS OF SKAGIT COUNTY, WASHINGTON.

REFERENCE SURVEYS:
 1) D.M. DEMEYER, PLS 21423, BOOK 6, PAGE 208 (1988)
 2) F. POYNER, PLS 12716, VOLUME 14 OF PLATS, PAGES 55-56 (1988)
 3) J.L. ABERNETHY, PLS 17651, VOLUME 10 OF SHORT PLATS, PAGE 132 (1992)
 4) J.L. ABERNETHY, PLS 17651, AFN 20031210107 (2003)
 5) S.B. VAN BUREN, JR., PLS 21591, AFN 200509190141 (2005)

APPROXIMATE LOCATION OF THE ORDINARY HIGH WATER LINES OF FINNEY CREEK AS SCALED AND DIGITIZED FROM A 2013 GOOGLE EARTH AERIAL PHOTO AND DEPICTED HEREON FOR VISUAL PURPOSES ONLY (NOT SURVEYED)

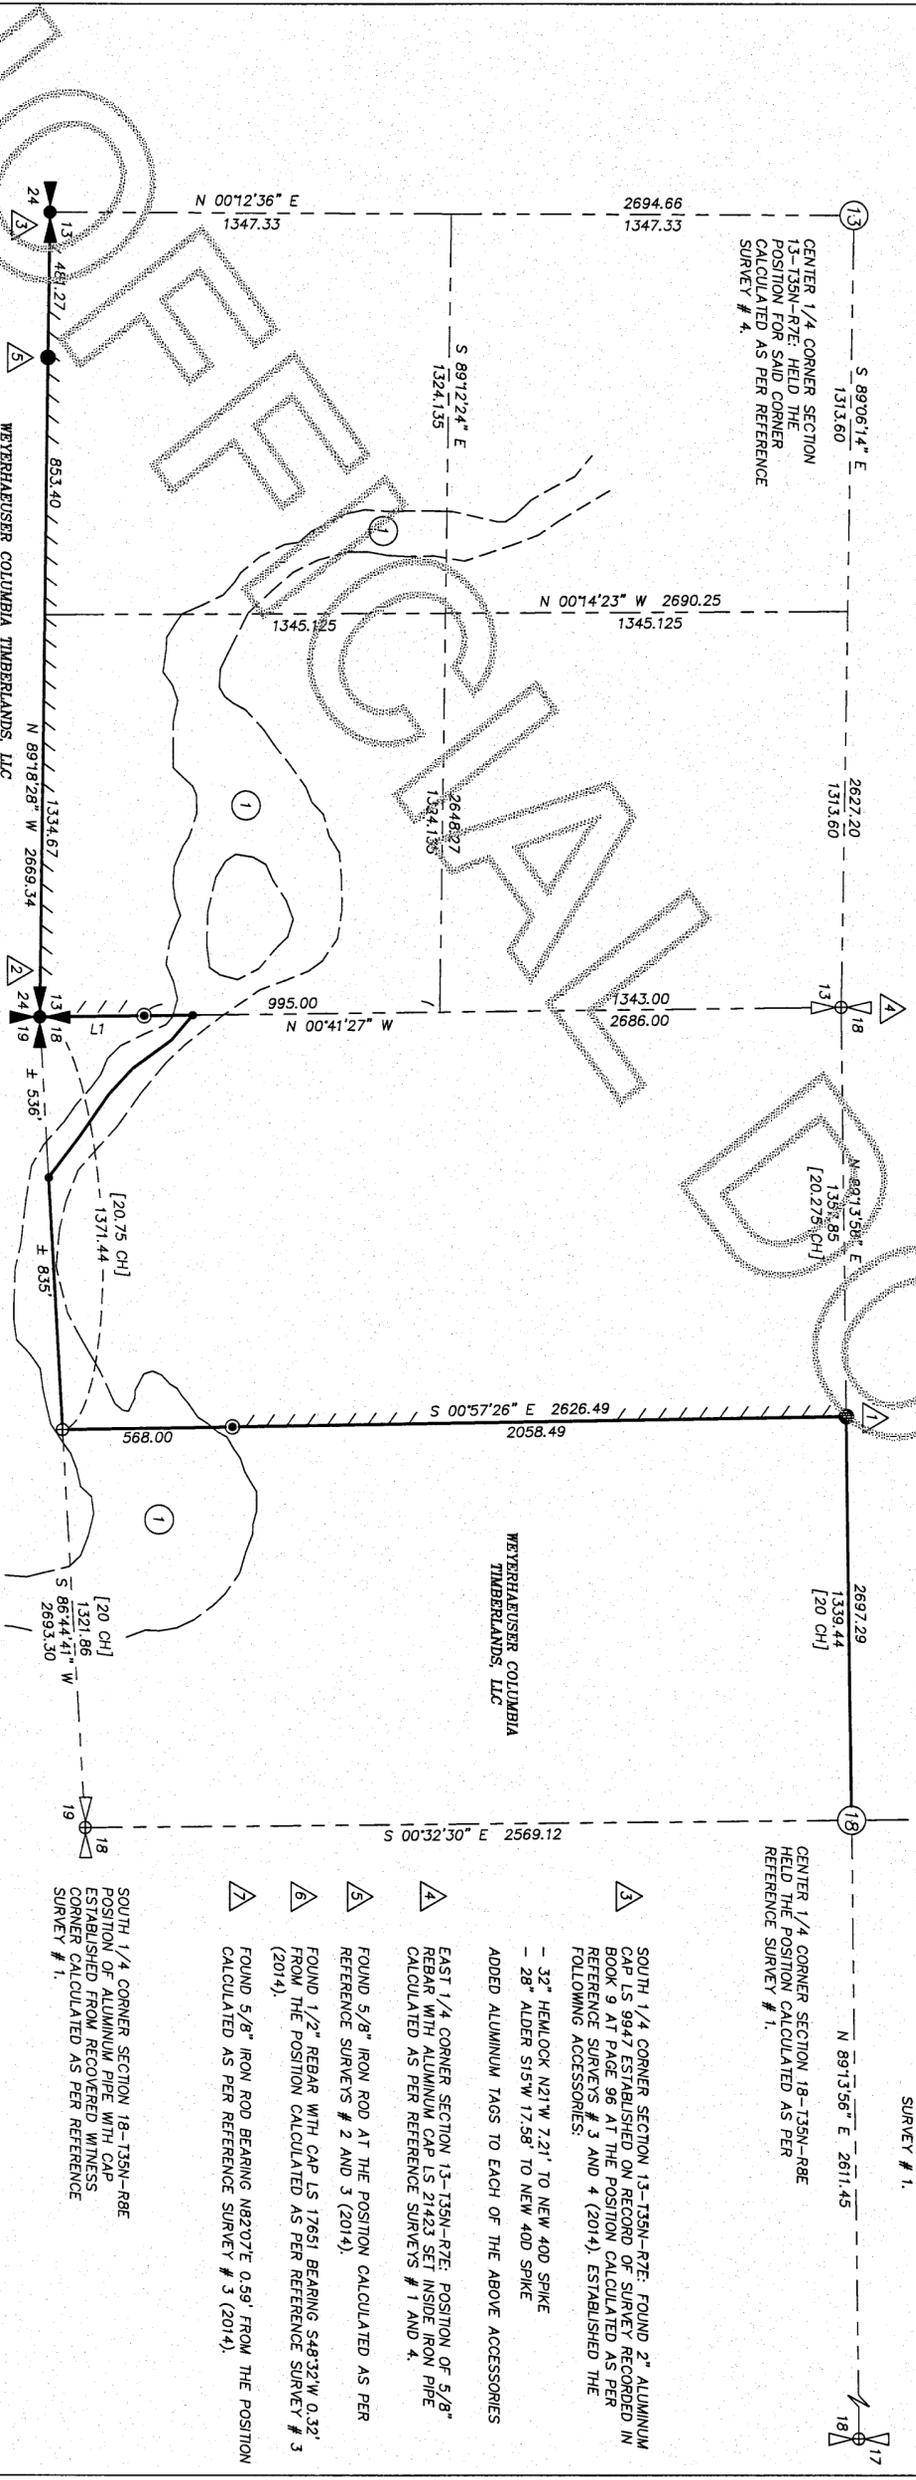

- FOUND CORNER AS NOTED
- SET 1/2\" REBAR WITH CAP LS 36792
- ⊙ SET 1/2\" REBAR WITH CAP LS 36792 \"LINE ONLY\"
- ⊕ CALCULATED POSITION
- PROPERTY LINE BLAZED, PAINTED AND POSTED WITH 1/2\" X 72\" FIBERGLASS RODS
- [] GLO DISTANCE

METHOD OF SURVEY: CLOSED LOOP FIELD TRAVERSES USING A TOPCON GTS-220 (000005) TOTAL STATION. THIS SURVEY MEETS OR EXCEEDS PRECISION REQUIREMENTS AS SET FORTH IN WAC 332-130-090.

RECORD OF SURVEY DESCRIPTIONS:
 WEYERHAEUSER COLUMBIA TIMBERLANDS, LLC:

THE WEST LINE OF THE EAST HALF OF THE SOUTHWEST QUARTER AND THAT PORTION OF THE WEST LINE OF THE SOUTHWEST QUARTER LYING SOUTH OF FINNEY CREEK, ALL IN SECTION 18, TOWNSHIP 35 NORTH, RANGE 8 EAST, W.M. IN SKAGIT COUNTY, WASHINGTON, ALSO, THE EAST HALF OF THE NORTH LINE OF SECTION 24, TOWNSHIP 35 NORTH, RANGE 7 EAST, W.M. IN SKAGIT COUNTY, WASHINGTON, TOGETHER WITH AND SUBJECT TO EASEMENTS, COVENANTS, CONDITIONS, RESTRICTIONS AND RESERVATIONS OF RECORD.

THE LAHR FAMILY LIMITED PARTNERSHIP:

THOSE PORTIONS OF THE SOUTH HALF OF THE SOUTHEAST QUARTER OF SECTION 13, TOWNSHIP 35 NORTH, RANGE 7 EAST, W.M. IN SKAGIT COUNTY, WASHINGTON DESCRIBED IN DEEDS RECORDED UNDER AUDITOR'S FILE NUMBERS 200203140118 AND 200706220068, RECORDS OF SKAGIT COUNTY, WASHINGTON, TOGETHER WITH AND SUBJECT TO EASEMENTS, COVENANTS, CONDITIONS, RESTRICTIONS AND RESERVATIONS OF RECORD.

NORTH 1/4 CORNER SECTION 18-T35N-R8E FOUND CONCRETE MONUMENT AS PER REFERENCE SURVEYS # 1 AND 5 (2014) HELD POSITION FOR ROTATION OF BEARINGS

SOUTH 1/8\" CORNER SECTION 18-T35N-R8E FOUND 5/8\" REBAR WITH UNIDENTIFIED PLASTIC CAP BEARING N31°17'W, 0.20' FROM THE POSITION CALCULATED AS PER REFERENCE SURVEYS # 1 AND 5 (2014). ESTABLISHED THE FOLLOWING ACCESSORIES:
 - 1\" HEMLOCK S&W 1.624' TO NEW 400 SPIKE
 - 7\" HEMLOCK NITE 8.45' TO NEW 400 SPIKE
 ADDED ALUMINUM TAGS TO EACH OF THE ABOVE

SOUTHWEST CORNER SECTION 18-T35N-R8E FOUND THE 5/8\" REBAR WITH 2\" ALUMINUM CAP LS 21423 AS PER REFERENCE SURVEYS # 1 AND 4 AND LOR RECORDED UNDER AFN 8604220026 RECORDS OF SKAGIT COUNTY, WA (2014). ESTABLISHED THE FOLLOWING ACCESSORIES:
 - 28\" MAPLE IN CLUMP N64°E 62.77' TO NEW 400 SPIKE
 - 26\" ALDER S39°W 10.50' TO NEW 400 SPIKE
 - 16\" COTTONWOOD S13°E 37.72' TO NEW 400 SPIKE
 - 15\" COTTONWOOD N12°W 41.85' TO NEW 400 SPIKE
 ADDED ALUMINUM TAGS TO EACH OF THE ABOVE ACCESSORIES

EAST 1/4 CORNER SECTION 18-T35N-R8E POSITION OF ALUMINUM PIPE WITH CAP ESTABLISHED AT A SINGLE PROPORTION POSITION CALCULATED AS PER REFERENCE SURVEY # 1.

CENTER 1/4 CORNER SECTION 18-T35N-R8E HELD THE POSITION CALCULATED AS PER REFERENCE SURVEY # 1.

SOUTH 1/4 CORNER SECTION 13-T35N-R7E FOUND 2\" ALUMINUM CAP LS 9947 ESTABLISHED ON RECORD OF SURVEY RECORDED IN BOOK 9 AT PAGE 96 AT THE POSITION CALCULATED AS PER REFERENCE SURVEYS # 3 AND 4 (2014). ESTABLISHED THE FOLLOWING ACCESSORIES:
 - 32\" HEMLOCK N21°W 7.21' TO NEW 400 SPIKE
 - 28\" ALDER S15°W 17.58' TO NEW 400 SPIKE
 ADDED ALUMINUM TAGS TO EACH OF THE ABOVE ACCESSORIES

EAST 1/4 CORNER SECTION 13-T35N-R7E POSITION OF 5/8\" REBAR WITH ALUMINUM CAP LS 21423 SET INSIDE IRON PIPE CALCULATED AS PER REFERENCE SURVEYS # 1 AND 4.

FOUND 5/8\" IRON ROD AT THE POSITION CALCULATED AS PER REFERENCE SURVEYS # 2 AND 3 (2014).

FOUND 1/2\" REBAR WITH CAP LS 17651 BEARING S48°32'W, 0.32' FROM THE POSITION CALCULATED AS PER REFERENCE SURVEY # 3 (2014).

FOUND 5/8\" IRON ROD BEARING N82°07' 0.59' FROM THE POSITION CALCULATED AS PER REFERENCE SURVEY # 3 (2014).

SOUTH 1/4 CORNER SECTION 18-T35N-R8E POSITION OF ALUMINUM PIPE WITH CAP ESTABLISHED FROM RECOVERED WITNESS CORNER CALCULATED AS PER REFERENCE SURVEY # 1.

LINE TABLE

NO.	BEARING	DISTANCE
L1	N 00°41'27\" W	348.00

Auditor's Certificate
 Filed for record this 12th day of September, 2014
 under Auditor's File Number 201409120065 at Page 1
 of 3 in Book 201409120065 of 2014 of 2014
 under Auditor's File Number 201409120065 at the request
 of Weyerhaeuser Columbia Timberlands, LLC
 County Auditor Wendy J. Butler by Deputy Auditor Wendy J. Butler

Surveyor's Certificate

This map correctly represents a survey made by me or under my direction in conformance with the requirements of the Survey Recording Act at the request of Weyerhaeuser Columbia Timberlands, LLC and The Lahr Family Limited Partnership in August of 2014.



BUTLER SURVEYING INC.
 475 NW CHEHALIS AVENUE
 P.O. BOX 149, CHEHALIS, WA 98502
 360/748-8803

Drawn <u>C. Butler</u>	Date <u>9-9-14</u>
Checked <u>CS</u>	Job No. <u>14-291</u>
Scale <u>1\" = 400'</u>	Sheet <u>1</u> of <u>3</u>

Portions of the East Half of the Southwest Quarter and Government Lot 4 in Section 18, Township 35 North, Range 8 East, W.M. and the Southwest Quarter and Southeast Quarter of the Southwest Quarter of Section 13, Township 35 North, Range 7 East, W.M. in Skagit County, Washington (Page 3 of 3 Pages)


- FOUND CORNER AS NOTED
- SET 1/2" REBAR WITH CAP LS 36792
- ⊙ SET 1/2" REBAR WITH CAP LS 36792 "LINE ONLY"
- ⊕ CALCULATED POSITION
- PROPERTY LINE BLAZED, PAINTED AND POSTED WITH 1/2" X 72" FIBERGLASS RODS
- () DEED BEARING OR DISTANCE

APPROXIMATE LOCATION OF THE ORDINARY HIGH WATER LINES OF FINNEY CREEK AS SCALED AND DIGITIZED FROM A 2013 GOOGLE EARTH AERIAL PHOTO AND DERIVED HEREON FOR VISUAL PURPOSES ONLY (NOT SURVEYED).


DEED OVERLAP BETWEEN PARCELS P42591 AND P42569. THIS SURVEY HOLDS THAT IT IS THE INTENT OF THE DESCRIPTION FOR PARCEL P42569 AS CONTAINED IN QUIT CLAIM DEEDS RECORDED UNDER AFN 200203140118 AND AFN 200706220068, RECORDS OF SKAGIT COUNTY, WASHINGTON TO CLOSE TO THE WEST LINE OF THE SE 1/4 OF THE SE 1/4 OF THE SE 1/4 OF SECTION 13. THIS IS NOT EXPRESSLY STATED IN THE RECORD DESCRIPTIONS, BUT THE EXISTENCE OF FOUND MONUMENTS AND LINES OF OCCUPATION ON THE GROUND SUPPORT THIS CONCLUSION. HOWEVER, THIS SURVEY DOES NOT REMOVE THE POSSIBILITY THAT SOME MANNER OF BOUNDARY LINE AGREEMENT OR DEED TO CLEAR TITLE MAY NEED TO BE RECORDED TO ULTIMATELY RESOLVE THIS OVERLAP.

SKAGIT COUNTY PARCEL NUMBER P42583 (SIERRA PACIFIC HOLDING COMPANY): A 30.00 FOOT WIDE STRIP OF REAL PROPERTY CONVEYED TO SIERRA PACIFIC HOLDING COMPANY IN STATUTORY BARGAIN AND SALE DEED RECORDED UNDER AUDITOR'S FILE NUMBER 200602210020, RECORDS OF SKAGIT COUNTY, WASHINGTON. THE DESCRIPTION CONTAINED IN SAID DEED IS CONSIDERED TO BE THE EXCEPTED DESCRIPTION FOR A 30.00 FOOT STRIP OF LAND CONTAINED IN QUIT CLAIM DEEDS RECORDED UNDER AFN 200203140118 AND AFN 200706220068, RECORDS OF SKAGIT COUNTY, WASHINGTON.

LOCATION OF LOWER FINNEY CREEK ROAD (PRIVATE ACCORDING TO SKAGIT COUNTY RECORDS) AS BUILT IN JUNE OF 2014.

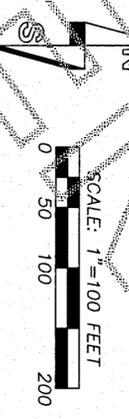

- ① FOUND 5/8" IRON ROD AT THE POSITION CALCULATED AS PER REFERENCE SURVEYS # 2 AND 3 (2014).
- ② FOUND 1/2" REBAR WITH CAP LS 17651 BEARING S48.32°W 0.32' FROM THE POSITION CALCULATED AS PER REFERENCE SURVEY # 3 (2014).
- ③ FOUND 1/2" REBAR WITH CAP LS 17651 BEARING S211.15°W 0.26' FROM THE POSITION CALCULATED AS PER REFERENCE SURVEY # 3 (2014).
- ④ FOUND 5/8" IRON ROD BEARING N82.07°E 0.59' FROM THE POSITION CALCULATED AS PER REFERENCE SURVEY # 3 (2014).
- ⑤ FOUND 2" IRON PIPE BEARING N15.42°W 0.43' FROM CALCULATED POSITION (2014).

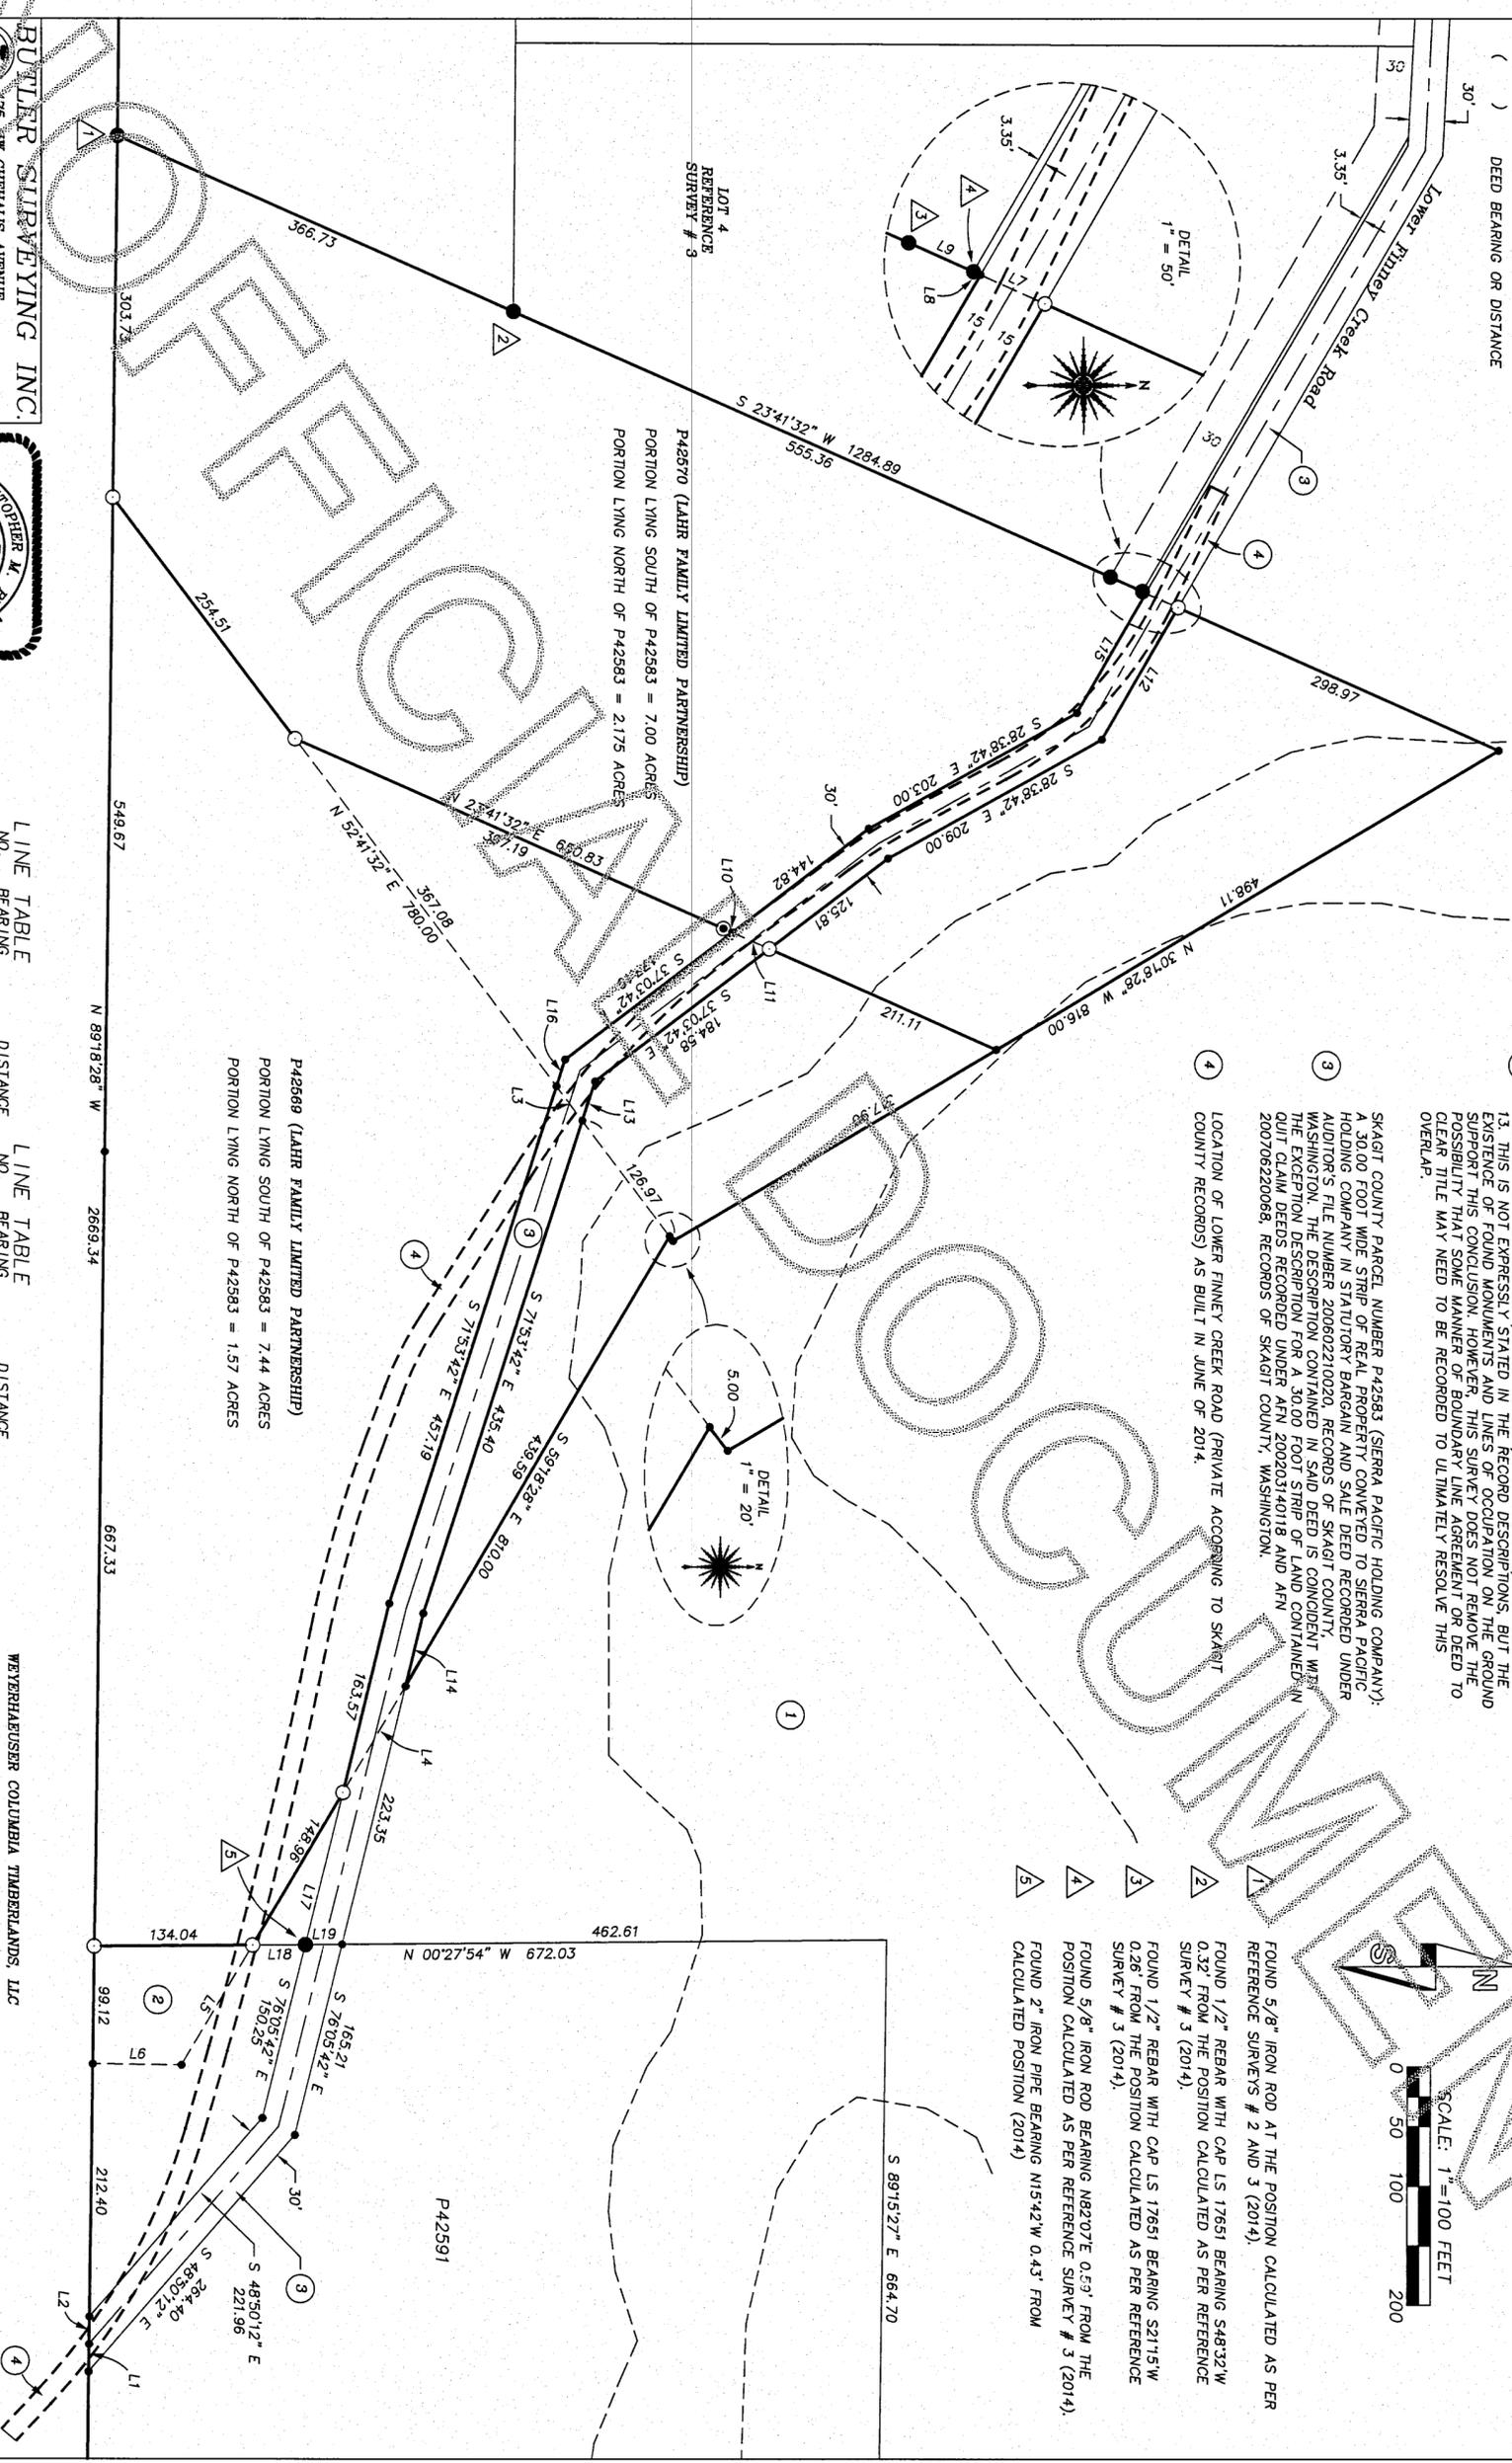

LINE TABLE

NO.	BEARING	DISTANCE
L1	N 89°18'28" W	23.11
L2	N 89°18'28" W	23.11
L3	N 52°41'32" E	36.44
L4	S 59°18'28" E	103.87
L5	S 59°18'28" E	117.58
L6	S 00°41'32" W	75.22
L7	S 23°41'32" W	30.23
L8	S 23°41'32" W	3.38
L9	S 23°41'32" E	30.23
L10	N 23°41'32" E	8.14

LINE TABLE

NO.	BEARING	DISTANCE
L11	N 23°41'32" E	34.38
L12	S 59°16'42" E	128.72
L13	S 71°53'42" E	34.74
L14	S 76°05'42" E	63.02
L15	S 59°16'42" E	116.80
L16	S 71°53'42" E	23.47
L17	S 76°05'42" E	131.59
L18	N 00°27'54" W	44.41
L19	N 00°27'54" W	30.97

BUTLER SURVEYING INC.
 1776 NW CHEHALIS AVENUE
 P.O. BOX 148, CHEHALIS, WA 98532
 360/748-8803

Drawn C. Butler Date 9-5-14
 Checked **CB** Job No. 14-291
 Scale 1" = 200' Sheet 3 of 3

