

Filed for the

record at the request of LeGro

21503040045


Skagit County audi

<u>-</u> 약

AUDITOR'S

CERTIFICATE

Associates.

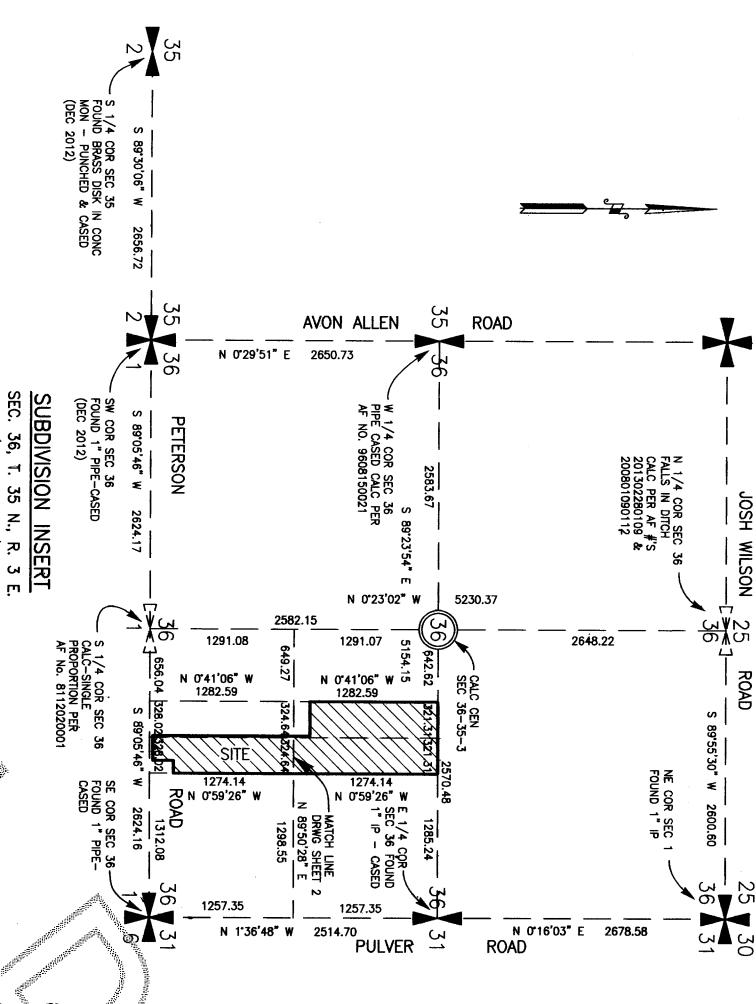

(Not to scale)

yellow plastic cap imprinted: Found Monument — Cased Date Last Visited: December diam. X 18" length LEGEND "LEGRO rebar w/ 37532"

FOUND MON (DEC 2012)

PROP COR SET REBAR

Property Corner Set 5/8" diam.

c/∟ or €

and/or Barb

Wire Fence

December 2012

Found/Set refers to the date of this survey

2. The existing drainage ditch along the North property referred to by Easement recorded u 600804 is not centered within said 20 foot easement. The South top of ditch is approximately approximately property. N_O

NOTES

(CONTINUED)

Legal description prepared by Land Title Company of Skagit County, Agent Order No. 151190—OE, effective date January 29, 2015 at 8:00 A.M.; and Supplemental #1 to 2nd Title Report, Dated February 23, 2015.

Survey Method: Field Traverse Instrumentation: TOPCON PS-103

4. Distances shown are in feet and decimals of a foot.

Gas pipeline ditch crossing "warning" signs were located by survey and mapped accordingly. Subject pipeline warning signs fell within the 60 loot wide pipeline easement as reconstructed from deed A.F. #8210210084 easement as reconstructed from

Parcel A

EXCEPTING Parcels A and B described below:

Short Plat;

Natural Gas Corp. recorded November 25, 1956 under A.F. #544540, exact location of which is not disclosed on the record, may be assumed to fall within the following 69 foot vide pipeline easement based upon comparison to deed calls and dates of instruments describing pipeline certerline in the relative timeline: Refer to that 59 foot wide pipeline easement from Jaakm J. Aarstad and his wife Anna recorded May 13, 1957 under A.F. #551202 crossing their property diagonally from Peterson Road northeasterly and terminating in the proximity of the pipeline centerline as described. described by A.F. #8210210004.

thence North parallel to the West line of said Lot 1 for a distance of 160.00 feet to a point North 89°05'49" West of the Northwest corner of said Lot 1; said point being hereinafter referred to as Point X; thence South 89°05'49" East 15 feet, more or less, to the Northwest corner of said Lot 1; thence South along the West line of said Lot 1 to the

thence West along the South line of said Lot 2 for a distance of 15 feet;

Beginning at the Southwest corner of Lot 1 of said

the following conclusions:
The easement bearing E-W direction is missing from the second leg of the described centerline for the 60 foot wide pipeline easement A.F. #8210210004. By assuming the bearing to have been S 53'59'00" W, the resulting calculated deed closure of 7.83 feet approximates the written deed terminus distance of 5.26 feet.

Assumed

Pas pipeline easement to Cascade Natural Gas Corp. recorded October 21, 1982 under A.F. #8210210004 has been mapped hereon to the best of my ability based upon a flawed legal description cited below by drawing

For additional subdivision information refer to: Short Plat No. 59—81 under A.F. No. 8112020001; Short Plat No. 96—045 under A.F. No. 9608150021; Record of Surveys filed under A.F. No's. 200801090112, 201212280250 and 201302280109, dll records of Skagit County, Washington.

10. The barb The barb and hog wire fence with 4" diameter steel pipe posts as shown along the West and North lines of P127391 (Exceptions A and B of this property survey Legal Description) at #17749 Peterson Road encroaches onto subject property along the North line thereof only from 0.5 feet at the Northwest corner to 2 feet at the

11.Field access across the existing drainage ditch via fill over a culvert as depicted upon the survey map at the Northeast corner of this property (P35435) appears to serve multiple property owners and/or lease holders for farming use only.

Theodolite: Min. Resolution/Accuracy 3" E.D.M.: Accuracy ± (1.55mm + 2ppm)

County Auditor

E N

Youal

LEGAL

DESCRIPTION

5. Basis of Bearing — the East line of the SE 1/4 of Section 36, T. 35 N., R. 3 E., W.M. as being N 1/36'48' W based upon existing monumentation.

Lot 2 Short Plat No. 34-89, approved September 6, 1989, seconded September 13, 1989 in Book 8 of Short Plats, page 155, under Auditor's File No. 8909130027 and being a portion of the Southeast 1/4 of Section 36, Township 35 North, Range 3 East, W.M.

Parcel B


point of beginning.

Beginning at the Northwest corner of said Lot 1; thence North 89.05.49" West for a distance of 15 feet to Point X;

thence North parallel to the West line of Lot 1 extended North for a distance of 26 feet; thence South 89°05'49" East for a distance of 115 feet, more or less, to the East line of said Lot 2 to a point 26 feet North of the Northeast corner of said Lot 1; thence South along the East line of said Lot 2 for a distance of 26 feet to the Northeast corner of said Lot

thence West along the North line of said Lot 1 to the point of beginning.

Situate in the County of Skagit, State of Washington.

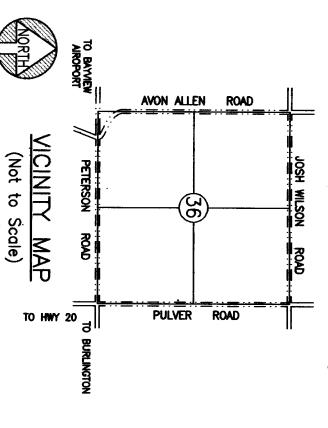

Sheet 1 of 2 Sheets

Section 36, T. 35 N., R.

S Ш

direction Action Recording Action Record SURVEYOR'S CERTIFICATE
This map correctly represents a survey made by me or under my direction in conformance with the requirements of the Survey Recording Act in February 2015 at the request of Tony, Wisdom.

ZEL KEBVK PPRO COR-

00.02 N

/N 0.20,14.

PETERSON

RD D

DETAIL—"A" (SEE SHEET 2 OF 2)

DENNY D. LEGRO
Registered Professional
Land Surveyor Surveyor # 37532

> RECORD OF SURVEY

PTN. SE FARMLAND, 4 LOT 2, SECTION 36, SHORT LLC PLAT No. PROPERTY 35 z 34-ZV. S 89 SURVE

Date: 3-64-15 SKAGIT COUNTY, WASHINGTON

