


**AUDITOR'S CERTIFICATE**

201802210107  
 Skagit County Auditor  
 2/21/2018 Page 1 of 2:58PM  
 \$168.00

AT THE REQUEST OF SEMRAU ENGINEERING & SURVEYING P.L.L.C.  
 SKAGIT COUNTY AUDITOR  
 DEPOSED: *[Signature]*

**DESCRIPTION**

THE LAND REFERRED TO HEREIN IS SITUATED IN THE COUNTY OF SKAGIT, STATE OF WASHINGTON, AND IS DESCRIBED AS FOLLOWS:  
 TRACTS "A" AND "D" OF THAT CERTAIN SURVEY RECORDED UNDER AUDITOR'S FILE NO. 830406006 IN VOLUME 4 OF SURVEYS, PAGES 102 AND 103, RECORDS OF SKAGIT COUNTY, WASHINGTON, BEING A PORTION OF GOVERNMENT LOTS 5, 6, AND 7 OF SECTION 9, TOWNSHIP 33 NORTH, RANGE 3 EAST, W.M., EXCEPT THAT PORTION LYING IN THE RIGHT OF WAY OF DIKING DISTRICT NO. 15, NOW CONSOLIDATED DIKING DISTRICT NO. 22, AS APPROPRIATED IN SKAGIT COUNTY COURT CAUSE NO. 4058; ALSO EXCEPT THE AS-BUILT DIKE RIGHT-OF-WAY FOR CONSOLIDATED DIKING DISTRICT NO. 22.


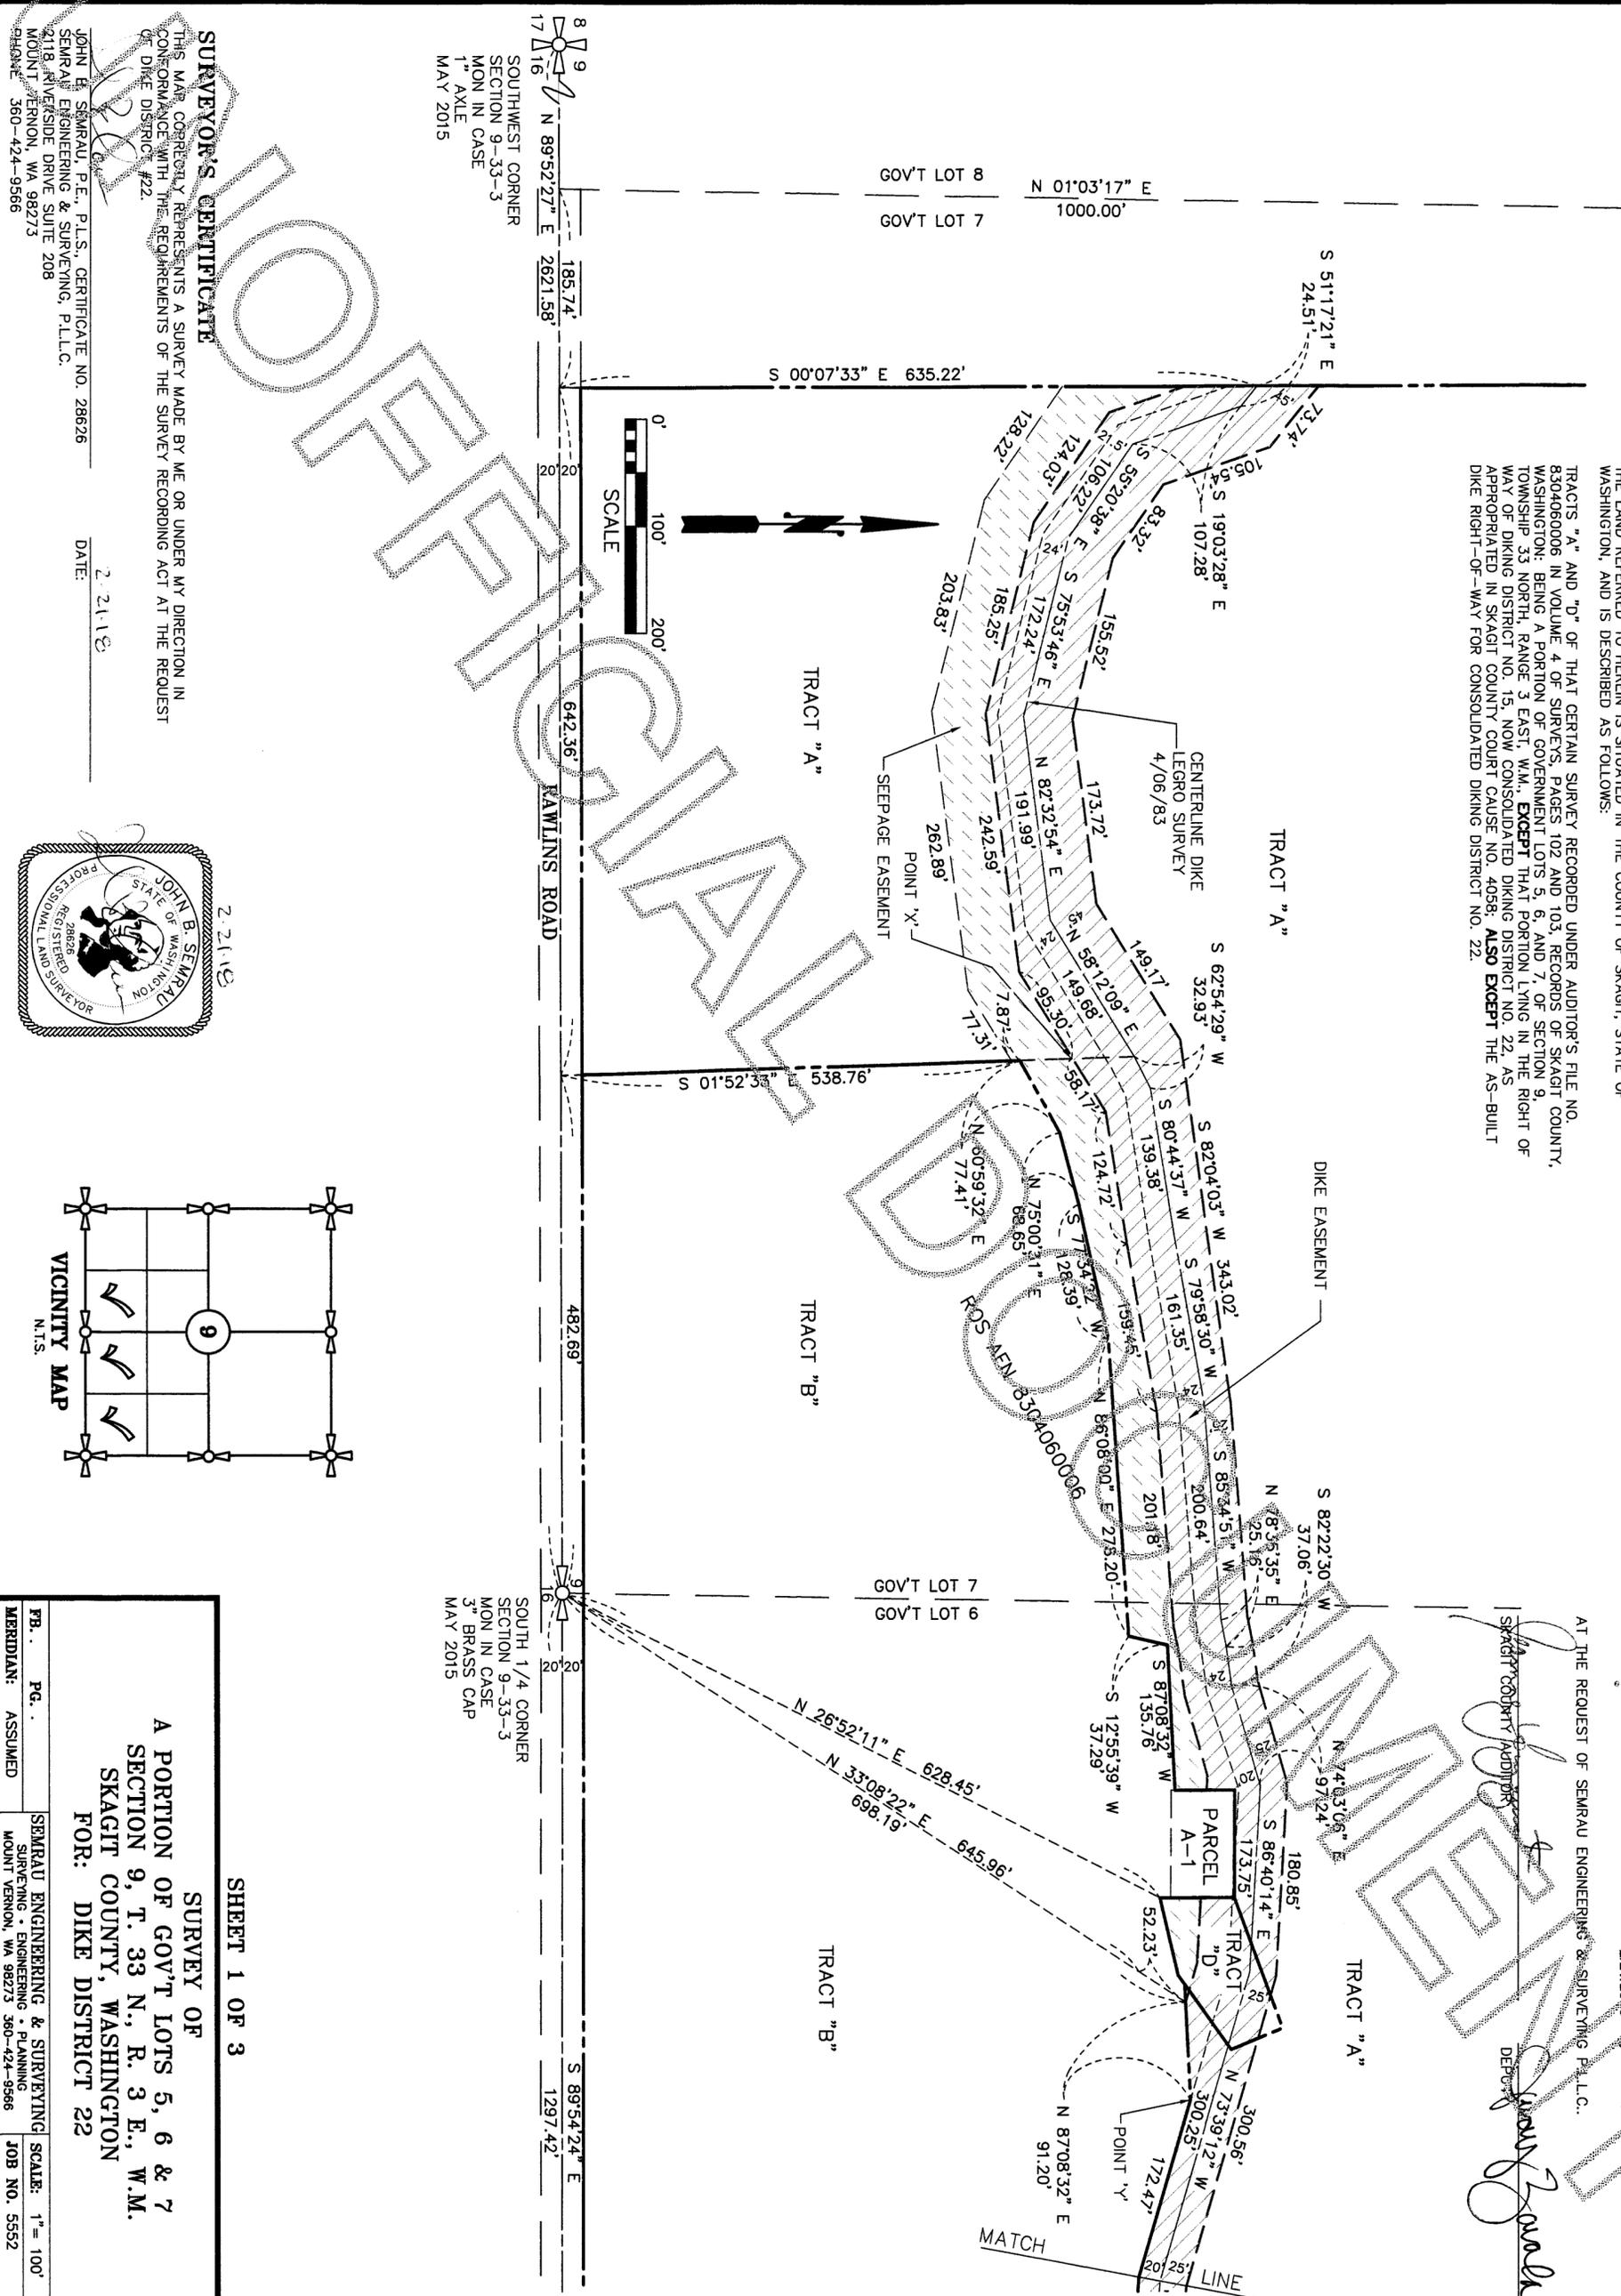


**SURVEYOR'S CERTIFICATE**

THIS MAP CORRECTLY REPRESENTS A SURVEY MADE BY ME OR UNDER MY DIRECTION IN CONFORMANCE WITH THE REQUIREMENTS OF THE SURVEY RECORDING ACT AT THE REQUEST OF DIKE DISTRICT #22.

JOHN B. SEMRAU, P.E., P.L.S., CERTIFICATE NO. 28626  
 SEMRAU ENGINEERING & SURVEYING, P.L.L.C.  
 2118 RIVERSIDE DRIVE SUITE 208  
 MOUNT VERNON, WA 98273  
 PHONE 360-424-9566

DATE: 2-21-18

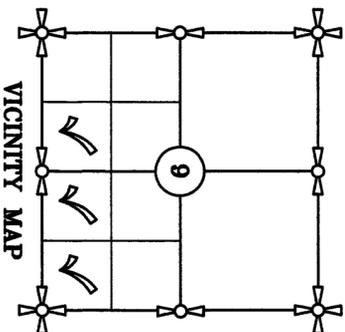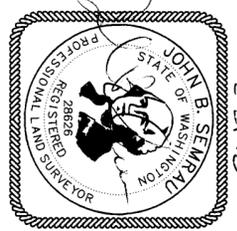


SHEET 1 OF 3

**SURVEY OF**  
 A PORTION OF GOV'T LOTS 5, 6 & 7  
 SECTION 9, T. 33 N., R. 3 E., W.M.  
 SKAGIT COUNTY, WASHINGTON  
 FOR: DIKE DISTRICT 22

FB.	Pg.	ASSUMED	SCALE: 1" = 100'	JOB NO. 5552
SEMRAU ENGINEERING & SURVEYING		MOUNT VERNON, WA 98273 360-424-9566		


201802210107  
 Skagit County Auditor  
 2/21/2018 Page 2 of 3 2:58PM  
 \$188.00

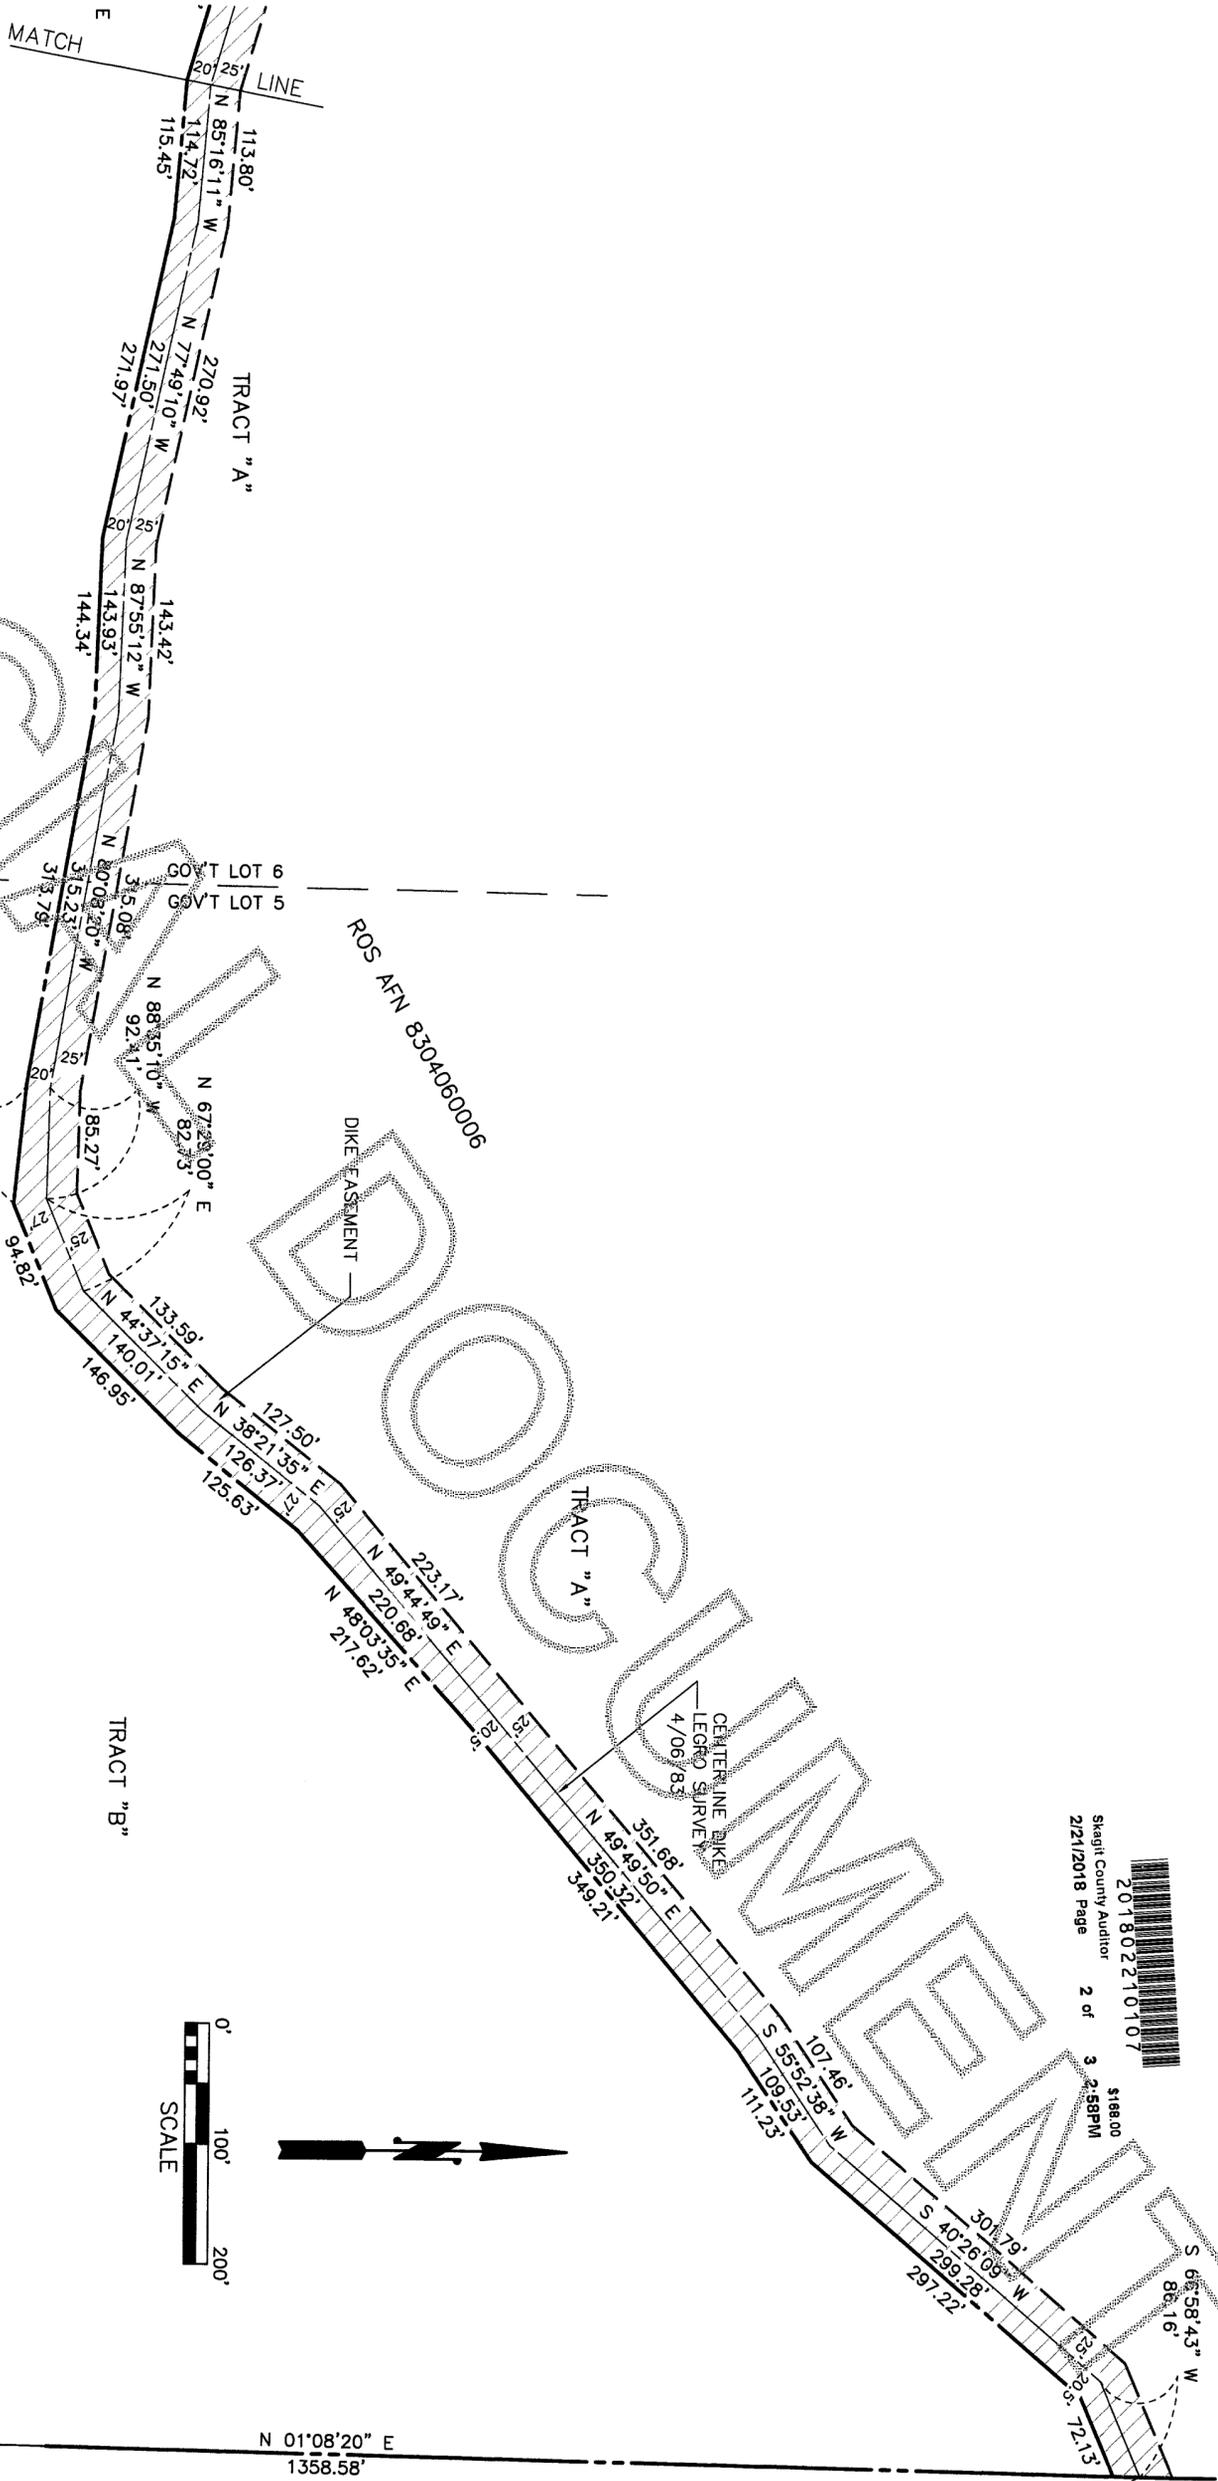

**NOTES**

1. - INDICATES MONUMENT FOUND.
2. THE DESCRIPTION FOR THIS SURVEY IS FROM LITIGATION GUARANTEE, ORDER NO. 114550, FIRST AMERICAN TITLE INSURANCE COMPANY, DATED AUGUST 4, 2017.
3. BASIS OF BEARING MONUMENTS FOUND ON SOUTH LINE OF THE SOUTHWEST QUARTER SECTION 9, T33N, R3E, W.M., BEARING = NORTH 89°52'27" EAST.
4. ALL DISTANCES ARE SHOWN IN FEET.
5. INSTRUMENTATION: LEICAMASSO THEODOLITE DISTANCE METER.
6. SURVEY PROCEDURE: STANDARD FIELD TRAVERSE.
7. THIS SURVEY WAS REQUESTED BY DIKE DISTRICT #22.
8. THIS SURVEY MAY SHOW OCCUPATIONAL INDICATORS AS PER W.A.C. CHAPTER 332.130. LINES OF OCCUPATION MAY INDICATE AREAS FOR POTENTIAL CLAIMS OF UNWRITTEN OWNERSHIP. THIS BOUNDARY SURVEY HAS ONLY SHOWN THE RELATIONSHIP OF LINES OF OCCUPATION TO THE DEEDED LINES OF RECORD. NO RESOLUTION OF OWNERSHIP BASED ON UNWRITTEN SURVEY HAS BEEN MADE OR IMPLIED BY THIS SURVEY.
9. EXCEPT AS SPECIFICALLY STATED OR SHOWN ON THIS SURVEY MAP, THIS SURVEY DOES NOT PURPORT TO REFLECT ALL OF THE FOLLOWING WHICH MAY BE APPLICABLE TO THE SUBJECT REAL ESTATE: EASEMENTS, BUILDING SETBACKS LINES, RESTRICTIVE COVENANTS, SUBDIVISION RESTRICTIONS, ZONING OR OTHER LAND-USE REGULATIONS AND ANY OTHER FACTS.

2 21 18

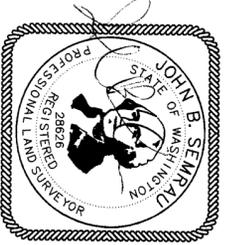

SHEET 2 OF 3  
 MAY 2015

BOUNDARY TRACT "C"  
 & FIR ISLAND ROAD  
 NOT SHOWN

DRAWING FILE: 5552ROS.DWG 2/21/18

<p><b>A PORTION OF GOV'T LOTS 5, 6 &amp; 7          SECTION 9, T. 33 N., R. 3 E., W.M.          SKAGIT COUNTY, WASHINGTON          FOR: DIKE DISTRICT 22</b></p>	
<p>SEBRAU ENGINEERING &amp; SURVEYING          SURVEYING • ENGINEERING • PLANNING          MOUNT VERNON, WA 98273 360-424-9566</p>	<p>SCALE: 1" = 100'          JOB NO. 5552</p>
<p>FB. PG. ASSUMED</p>	<p>SCALE: 1" = 100'</p>

EASEMENT DESCRIPTIONS

DIKE EASEMENT -

THAT PORTION OF TRACTS "A" AND "D" OF THAT CERTAIN SURVEY RECORDED UNDER AUDITOR'S FILE NO. 8304060006 IN VOLUME 4 OF SURVEYS, PAGES 102 AND 103, RECORDS OF SKAGIT COUNTY, WASHINGTON, BEING A PORTION OF GOVERNMENT LOTS 5, 6 AND 7 OF SECTION 9, TOWNSHIP 33 NORTH, RANGE 3 EAST, W.M., LYING SOUTHERLY OF THE CENTERLINE OF THE EXISTING DIKE AS SHOWN ON SAID SURVEY AND NORTHERLY OF THE FOLLOWING DESCRIBED LINE:

BEGINNING AT THE SOUTH 1/4 CORNER OF SAID SECTION 9; THENCE NORTH 33°08'22" EAST 698.19 FEET TO THE INTERSECTION OF THE SOUTHERLY LINE OF SAID TRACT "A" AND A POINT THAT IS 50.00 FEET SOUTHERLY, AS MEASURED AT RIGHT ANGLE, FROM SAID CENTERLINE OF THE EXISTING DIKE AS SHOWN ON SAID SURVEY; THENCE NORTH 87°08'32" EAST ALONG SAID SOUTHERLY LINE OF TRACT "A", 91.20 FEET TO A CORNER OF SAID TRACT "A" AND THE TRUE POINT OF BEGINNING OF SAID DESCRIBED LINE, SAID POINT TO BE HEREAFTER REFERRED TO AS POINT "A"; THENCE SOUTH 87°08'32" WEST ALONG SAID SOUTHERLY LINE OF TRACT "A", 91.20 FEET TO A LINE THAT IS 50.00 FEET SOUTHERLY, AS MEASURED AT RIGHT ANGLE, FROM SAID CENTERLINE; THENCE NORTH 73°39'12" WEST ALONG A LINE THAT IS 50 FEET SOUTHERLY OF AND PARALLEL WITH SAID CENTERLINE 37.98 FEET; THENCE NORTH 86°40'14" WEST ALONG SAID PARALLEL LINE 61.15 FEET TO THE LINE COMMON TO SAID TRACT "D" AND PARCEL "A-1" AS SHOWN ON SAID SURVEY; THENCE NORTH 0°1'4" EAST ALONG SAID COMMON LINE 31.73 FEET TO A CORNER COMMON TO SAID TRACT "D" AND PARCEL "A-1"; THENCE NORTH 89°46' WEST ALONG THE NORTH LINE OF SAID PARCEL "A-1" 100 FEET TO THE NORTHWEST CORNER THEREOF; THENCE SOUTH 0°1'4" WEST ALONG THE WEST LINE OF SAID PARCEL 26.32 FEET TO A LINE THAT IS 50 FEET SOUTHERLY OF AND PARALLEL WITH SAID CENTERLINE; THENCE NORTH 86°40'14" WEST ALONG SAID PARALLEL LINE 13.40 FEET TO A LINE THAT IS 45 FEET SOUTHERLY OF AND PARALLEL WITH SAID CENTERLINE; THENCE SOUTH 74°03'06" WEST ALONG SAID PARALLEL LINE 77.73 FEET TO A LINE THAT IS 45 FEET SOUTHERLY OF AND PARALLEL WITH SAID CENTERLINE; THENCE SOUTH 82°22'30" WEST ALONG SAID PARALLEL LINE 38.85 FEET TO A LINE THAT IS 45 FEET SOUTHERLY OF AND PARALLEL WITH SAID CENTERLINE; THENCE SOUTH 78°35'35" WEST ALONG SAID PARALLEL LINE 26.42 FEET TO A LINE THAT IS 45 FEET SOUTHERLY OF AND PARALLEL WITH SAID CENTERLINE; THENCE SOUTH 85°34'51" WEST ALONG SAID PARALLEL LINE 201.18 FEET TO A LINE THAT IS 45 FEET SOUTHERLY OF AND PARALLEL WITH SAID CENTERLINE; THENCE SOUTH 79°58'30" WEST ALONG SAID PARALLEL LINE 159.45 FEET TO A LINE THAT IS 45 FEET SOUTHERLY OF SAID CENTERLINE; THENCE SOUTH 80°44'37" WEST ALONG SAID PARALLEL LINE 124.72 FEET TO A LINE THAT IS 50 FEET SOUTHERLY OF SAID CENTERLINE; THENCE SOUTH 58°12'09" WEST ALONG SAID PARALLEL LINE 153.47 FEET TO A LINE THAT IS 35 FEET SOUTHERLY OF AND PARALLEL WITH SAID CENTERLINE; THENCE SOUTH 82°32'54" WEST ALONG SAID PARALLEL LINE 242.59 FEET TO A LINE THAT IS 35 FEET SOUTHERLY OF AND PARALLEL WITH SAID CENTERLINE; THENCE SOUTH 55°20'38" WEST ALONG SAID PARALLEL LINE 124.03 FEET TO A LINE THAT IS 35 FEET SOUTHERLY OF AND PARALLEL WITH SAID CENTERLINE; THENCE NORTH 75°53'46" WEST ALONG SAID PARALLEL LINE 185.25 FEET TO A LINE THAT IS 35 FEET SOUTHERLY OF AND PARALLEL WITH SAID CENTERLINE; THENCE NORTH 55°20'38" WEST ALONG SAID PARALLEL LINE 124.03 FEET TO A LINE THAT IS 35 FEET SOUTHERLY OF AND PARALLEL WITH SAID CENTERLINE; THENCE NORTH 19°03'28" WEST ALONG SAID PARALLEL LINE 75.55 FEET TO THE WEST LINE OF SAID TRACT "A" AND THE TERMINUS OF SAID LINE; AND ALSO THAT PORTION OF TRACTS "A" AND "D" OF THAT CERTAIN SURVEY RECORDED UNDER AUDITOR'S FILE NO. 8304060006, LYING NORTHERLY OF THE CENTERLINE OF THE EXISTING DIKE AS SHOWN ON SAID SURVEY AND SOUTHERLY AND WESTERLY OF THE FOLLOWING DESCRIBED LINE: BEGINNING AT THE BEFORE MENTIONED POINT "A"; THENCE NORTH 16°20'48" EAST, 20.00 FEET TO SAID CENTERLINE; THENCE CONTINUE NORTH 16°20'48" EAST, 25 FEET; THENCE NORTH 73°39'12" WEST PARALLEL WITH SAID CENTERLINE 132.67 FEET TO A LINE THAT IS 25 FEET NORTHERLY OF AND PARALLEL WITH SAID CENTERLINE; THENCE NORTH 86°40'14" WEST ALONG SAID PARALLEL LINE 180.85 FEET TO A LINE THAT IS 25 FEET NORTHERLY OF AND PARALLEL WITH SAID CENTERLINE; THENCE SOUTH 74°03'06" WEST ALONG SAID PARALLEL LINE 99.67 FEET TO A LINE THAT IS 25 FEET NORTHERLY OF AND PARALLEL WITH SAID CENTERLINE; THENCE SOUTH 82°22'30" WEST ALONG SAID PARALLEL LINE 36.07 FEET TO A LINE THAT IS 25 FEET NORTHERLY OF AND PARALLEL WITH SAID CENTERLINE; THENCE SOUTH 78°35'35" WEST ALONG SAID PARALLEL LINE 24.46 FEET TO A LINE THAT IS 25 FEET NORTHERLY OF AND PARALLEL WITH SAID CENTERLINE; THENCE SOUTH 85°34'51" WEST ALONG SAID PARALLEL LINE 199.11 FEET; THENCE SOUTH 82°04'03" WEST 34.32 FEET TO A LINE THAT IS 45 FEET NORTHERLY OF AND PARALLEL WITH SAID CENTERLINE;

DIKE EASEMENT CONTINUED -

THENCE SOUTH 58°12'09" WEST ALONG SAID PARALLEL LINE 149.17 FEET TO A LINE THAT IS 45 FEET NORTHERLY OF AND PARALLEL WITH SAID CENTERLINE; THENCE SOUTH 82°32'54" WEST ALONG SAID PARALLEL LINE 173.72 FEET TO A LINE THAT IS 45 FEET NORTHERLY OF AND PARALLEL WITH SAID CENTERLINE; THENCE NORTH 75°53'46" WEST ALONG SAID PARALLEL LINE 155.52 FEET TO A LINE THAT IS 45 FEET NORTHERLY OF AND PARALLEL WITH SAID CENTERLINE; THENCE NORTH 55°20'38" WEST ALONG SAID PARALLEL LINE 83.32 FEET TO A LINE THAT IS 45 FEET NORTHERLY OF AND PARALLEL WITH SAID CENTERLINE; THENCE NORTH 19°03'28" WEST ALONG SAID PARALLEL LINE 105.54 FEET TO A LINE THAT IS 45 FEET NORTHERLY OF AND PARALLEL WITH THE CENTERLINE; THENCE NORTH 51°17'21" WEST ALONG SAID PARALLEL LINE 73.74 FEET TO THE WEST LINE OF SAID TRACT "A" AND THE TERMINUS OF SAID DESCRIBED LINE; AND ALSO THAT PORTION OF SAID TRACT "A" OF THAT CERTAIN SURVEY RECORDED UNDER AUDITOR'S FILE NO. 8304060006, LYING 25 FEET NORTHERLY OF THE CENTERLINE OF THE EXISTING DIKE AS SHOWN ON SAID SURVEY AND EASTERLY OF THE FOLLOWING DESCRIBED LINE: BEGINNING AT THE BEFORE MENTIONED POINT "A"; THENCE NORTH 16°20'48" EAST, 20.00 FEET TO THE CENTERLINE OF THE EXISTING DIKE AS SHOWN ON SAID SURVEY; THENCE CONTINUE NORTH 16°20'48" EAST, 25 FEET TO THE TERMINUS OF SAID LINE; AND ALSO THAT PORTION OF SAID TRACT "A" OF THAT CERTAIN SURVEY RECORDED UNDER AUDITOR'S FILE NO. 8304060006, LYING SOUTHERLY OF THE CENTERLINE OF THE EXISTING DIKE AS SHOWN ON SAID SURVEY AND EASTERLY OF THE FOLLOWING DESCRIBED LINE: BEGINNING AT THE BEFORE MENTIONED POINT "A"; THENCE NORTH 16°20'48" EAST, 20.00 FEET TO THE CENTERLINE OF THE EXISTING DIKE AS SHOWN ON SAID SURVEY; THENCE CONTINUE NORTH 16°20'48" EAST, 25 FEET TO THE TERMINUS OF SAID LINE; SITUATE IN THE COUNTY OF SKAGIT, STATE OF WASHINGTON.

SEWAGE EASEMENT -

THAT PORTION OF TRACTS "A" AND "D" OF THAT CERTAIN SURVEY RECORDED UNDER AUDITOR'S FILE NO. 8304060006 IN VOLUME 4 OF SURVEYS, PAGES 102 AND 103, RECORDS OF SKAGIT COUNTY, WASHINGTON, BEING A PORTION OF GOVERNMENT LOTS 5, 6 AND 7 OF SECTION 9, TOWNSHIP 33 NORTH, RANGE 3 EAST, W.M., DESCRIBED AS FOLLOWS: BEGINNING AT THE SOUTH 1/4 CORNER OF SAID SECTION 9; THENCE NORTH 33°08'22" EAST, 698.19 FEET TO THE INTERSECTION OF THE SOUTHERLY LINE OF SAID TRACT "A" AT A POINT THAT IS 50.00 FEET SOUTHERLY, AS MEASURED AT RIGHT ANGLE FROM THE CENTERLINE OF THE EXISTING DIKE AS SHOWN ON SAID SURVEY SAID POINT BEING THE TRUE POINT OF BEGINNING; THENCE SOUTH 87°08'32" WEST ALONG SAID SOUTHERLY LINE OF TRACT "A", 16.74 FEET TO A CORNER OF SAID TRACT "A" AND AN INTERSECTION WITH THE SOUTHERLY LINE OF SAID TRACT "D"; THENCE SOUTH 54°24' WEST ALONG SAID LINE 10.48 FEET TO A CORNER OF SAID TRACT "D"; THENCE SOUTH 76°43' WEST ALONG SAID LINE 74.4 FEET TO A CORNER OF SAID TRACT "D"; THENCE NORTH 0°1'4" EAST ALONG SAID LINE 10.00 FEET TO A CORNER OF SAID TRACT "D", AND PARCEL "A-1" AS SHOWN ON SAID SURVEY, SAID CORNER SHOWN AS LYING NORTH 26°28' EAST 637.4 FEET FROM SAID SOUTH 1/4 CORNER; THENCE CONTINUE NORTH 0°1'4" EAST ALONG THE COMMON LINE OF SAID TRACT "D" AND PARCEL "A-1" 28.27 FEET TO A LINE THAT IS 50.00 FEET SOUTHERLY, AS MEASURED AT RIGHT ANGLE, FROM SAID CENTERLINE; THENCE SOUTH 86°40'14" EAST ALONG SAID LINE 61.15 FEET TO THE INTERSECTION OF A LINE THAT IS 50.00 FEET SOUTHERLY, AS MEASURED AT RIGHT ANGLE, FROM SAID CENTERLINE; THENCE SOUTH 73°39'12" EAST ALONG SAID LINE 37.98 FEET TO SAID TRUE POINT OF BEGINNING

AND ALSO

THAT PORTION OF TRACT "A" OF SAID SURVEY RECORDED UNDER AUDITOR'S FILE NO. 8304060006 LYING SOUTHERLY AND EASTERLY OF THE FOLLOWING DESCRIBED LINE: BEGINNING AT THE SOUTH 1/4 CORNER OF SAID SECTION 9; THENCE NORTH 33°08'22" EAST, 698.19 FEET TO THE INTERSECTION OF THE SOUTHERLY LINE OF SAID TRACT "A" AT A POINT THAT IS 50.00 FEET SOUTHERLY, AS MEASURED AT RIGHT ANGLE, FROM THE CENTERLINE OF THE EXISTING DIKE AS SHOWN ON SAID SURVEY;



Skagit County Auditor 2/21/2018 Page 3 of 3 2:58PM \$168.00

SEWAGE EASEMENT CONTINUED

THENCE SOUTH 87°08'32" WEST ALONG SAID SOUTHERLY LINE OF TRACT "A", 16.74 FEET TO A CORNER OF SAID TRACT "A" AND AN INTERSECTION WITH THE SOUTHERLY LINE OF SAID TRACT "D" AS SHOWN ON SAID SURVEY; THENCE SOUTH 54°24' WEST ALONG SAID LINE 10.48 FEET TO A CORNER OF SAID TRACT "D"; THENCE SOUTH 76°43' WEST ALONG SAID LINE 74.4 FEET TO A CORNER OF SAID TRACT "D"; THENCE NORTH 0°1'4" EAST ALONG SAID LINE 10.00 FEET TO A CORNER COMMON TO TRACTS "B", "D", AND PARCEL "A-1", SAID CORNER SHOWN ON SAID SURVEY AS LYING NORTH 26°28' EAST 637.4 FEET FROM SAID SOUTH 1/4 CORNER; THENCE NORTH 89°46' WEST ALONG SAID LINE 100.00 FEET TO THE SOUTHWEST CORNER OF SAID PARCEL "A-1"; THENCE NORTH 90°14' EAST ALONG SAID LINE 3.76 FEET TO A CORNER COMMON TO SAID TRACTS "A", "B" AND PARCEL "A-1"; THENCE CONTINUE NORTH 0°1'4" EAST ALONG THE WEST LINE OF SAID PARCEL "A-1" 29.92 FEET TO A LINE THAT IS 50 FEET SOUTHERLY OF AND PARALLEL WITH THE CENTERLINE OF EXISTING DIKE AS SHOWN ON SAID SURVEY AND THE TRUE POINT OF BEGINNING OF SAID DESCRIBED LINE; THENCE NORTH 86°40'14" WEST ALONG SAID PARALLEL LINE 13.40 FEET TO A LINE THAT IS 45 FEET SOUTHERLY OF AND PARALLEL WITH SAID CENTERLINE; THENCE SOUTH 74°03'06" WEST ALONG SAID PARALLEL LINE 77.73 FEET TO A LINE THAT IS 45 FEET SOUTHERLY OF AND PARALLEL WITH SAID CENTERLINE; THENCE SOUTH 82°22'30" WEST ALONG SAID PARALLEL LINE 38.85 FEET TO A LINE THAT IS 45 FEET SOUTHERLY OF AND PARALLEL WITH SAID CENTERLINE; THENCE SOUTH 78°35'35" WEST ALONG SAID PARALLEL LINE 26.42 FEET TO A LINE THAT IS 45 FEET SOUTHERLY OF AND PARALLEL WITH SAID CENTERLINE; THENCE SOUTH 85°34'51" WEST ALONG SAID PARALLEL LINE 201.18 FEET TO A LINE THAT IS 45 FEET SOUTHERLY OF AND PARALLEL WITH SAID CENTERLINE; THENCE SOUTH 79°58'30" WEST ALONG SAID PARALLEL LINE 159.45 FEET TO A POINT THAT IS 45 FEET SOUTHERLY OF SAID CENTERLINE; THENCE SOUTH 80°44'37" WEST ALONG SAID PARALLEL LINE 124.72 FEET TO A POINT THAT IS 50 FEET SOUTHERLY OF SAID CENTERLINE; THENCE SOUTH 58°12'09" WEST 58.17 FEET TO A POINT ON THE NORTHERLY EXTENSION OF A LINE BETWEEN SAID TRACTS "A" AND "B" SAID POINT TO BE HEREAFTER REFERRED TO AS POINT "X"; THENCE SOUTH 01°52'33" EAST 49.82 FEET TO A CORNER COMMON TO SAID TRACTS "A" AND "B" AND THE TERMINUS OF SAID LINE; AND ALSO THAT PORTION OF TRACT "A" OF SAID SURVEY RECORDED UNDER AUDITOR'S FILE NO. 8304060006 LYING 50 FEET SOUTHERLY OF THE FOLLOWING DESCRIBED LINE: BEGINNING AT THE BEFORE MENTIONED POINT "X"; THENCE SOUTH 58°12'09" WEST ON A LINE THAT IS 50 FEET SOUTHERLY OF AND PARALLEL WITH THE CENTERLINE OF EXISTING DIKE AS SHOWN ON SAID SURVEY 95.30 FEET TO A LINE THAT IS 35 FEET SOUTHERLY OF AND PARALLEL WITH SAID CENTERLINE; THENCE SOUTH 82°32'54" WEST ALONG SAID PARALLEL LINE 242.59 FEET TO A LINE THAT IS 35 FEET SOUTHERLY OF AND PARALLEL WITH SAID CENTERLINE; THENCE NORTH 75°53'46" WEST ALONG SAID PARALLEL LINE 185.25 FEET TO A LINE THAT IS 35 FEET SOUTHERLY OF AND PARALLEL WITH SAID CENTERLINE; THENCE NORTH 55°20'38" WEST ALONG SAID PARALLEL LINE 124.03 FEET TO A LINE THAT IS 35 FEET SOUTHERLY OF AND PARALLEL WITH SAID CENTERLINE; THENCE NORTH 19°03'28" WEST ALONG SAID PARALLEL LINE 75.55 FEET TO THE WEST LINE OF SAID TRACT "A" AND THE TERMINUS OF SAID LINE; NOTE: THE 50 FOOT LINES ARE TO BE SHORTENED OR EXTENDED TO INTERSECT AT ANGLE POINTS TO FORM A CONTINUOUS LINE.

SHEET 3 OF 3

SITUATE IN THE COUNTY OF SKAGIT, STATE OF WASHINGTON

SURVEY OF A PORTION OF GOV'T LOTS 5, 6 & 7 SECTION 9, T. 33 N., R. 3 E., W.M. SKAGIT COUNTY, WASHINGTON FOR: DIKE DISTRICT 22



2-21-18