

AMENDED
RECORD OF SURVEY

SITUATE IN A PORTION OF THESE 1/4 OF SECTION 18 AND THE SW 1/4 OF SECTION 17,
TOWNSHIP 33 NORTH, RANGE 5 EAST, W.M., SKAGIT COUNTY, WASHINGTON

MINING PERMIT AREA LEGAL DESCRIPTION
(EXEMPTS FROM Q.C.D. A.F. NO. 8608040020)

PARCEL A:

THAT PORTION OF THE NORTHWEST 1/4 AND THE SOUTHWEST 1/4 OF THE SOUTHWEST 1/4 OF SECTION 17, TOWNSHIP 36 NORTH, RANGE 10 WEST, COUNTY OF WASHINGTON, STATE OF WASHINGTON, LYING EASTERLY OF THE NORTHERN PACIFIC RAILROAD COMPANY RIGHT OF WAY AS RELOCATED AS PER PERCECE ENTERED JUNE 13, 1913, IN SAGVAT COUNTY SUPERIOR COURT CASE NO. 6944, EXCEPT ANY PORTION THEREOF LYING WITHIN A TRACT OF LAND AS CONVEYED TO SCHOOL DISTRICT NO. 67 BY DEED RECORDED JULY 20TH, 1914, IN VOLUME 97 OF DEEDS, PAGE 272, RECORDS OF SAID COUNTY, EXCEPT COUNTY ROAD AND RAILROADS, AND EXCEPT THAT PORTION OF SAID NORTH 1/4 OF THE SOUTHWEST 1/4 LYING EASTERLY AND NORTHEASTERLY OF THE FOLLOWING DESCRIBED LINE (MINING PERMIT BOUNDARY LINE AND

BEGINNING AT THE SOUTHWEST 1/16TH CORNER OF SAID SECTION 17; THENCE ALONG THE EAST LINE OF THE NORTHWEST QUARTER OF SAID SOUTHWEST QUARTER NORTH 01°57'09" EAST 128.53 FEET; THENCE NORTH 40°36'10" WEST 248.39 FEET TO THE SOUTHEASTERLY MARGON OF SAID NORTHERN PACIFIC RAILWAY CO. RIGHT OF WAY AND THE TERMINUS OF SAID LINE.

PARCEL B:
THAT PORTION OF THE SOUTHEAST 1/4 OF THE SOUTHEAST 1/4, SECTION 18, TOWNSHIP 33 NORTH, RANGE 5 EAST, WM. LYING EASTERLY OF THE NORTHERN PACIFIC RAILWAY CO. RIGHT OF WAY AS RELOCATED AS PER DECREE ENTERED JUNE 13, 1913, IN SKAGIT COUNTY SUPERIOR COURT CAUSE NO. 6944, EXCEPT COUNTY ROADS.

SURVEYOR'S NOTES:

- [illegible]

AUDITOR'S CERTIFICATE

AUDITOR'S CERTIFICATE
Filed for record this 30 day of Jan., 2025 at 1:10 PM
in book ✓ of surveys at page ✓ at the request of
PACIFIC SURVEYING AND ENGINEERING SERVICES INC.

Landra Perkins

Skagit County Auditor

DRAWN BY: ASM

CHECKED BY: PB

F.B.I. 264

DATE: 1/9/25 JOB NO. 2

SHEET NO. 1 OF 2


DWG. NO. ROS BASE amendment.dwg

SURVEYOR'S CERTIFICATE

CONVEYOR'S CERTIFICATE
This map correctly represents a survey made by me or
under my direction in conformance with the requirements
of the Survey Recording Act at the request of Traci
Gibbertson in November of 2003.


Certificate No.: 40525

DWG. NO. ROS BASE amendment.dwg

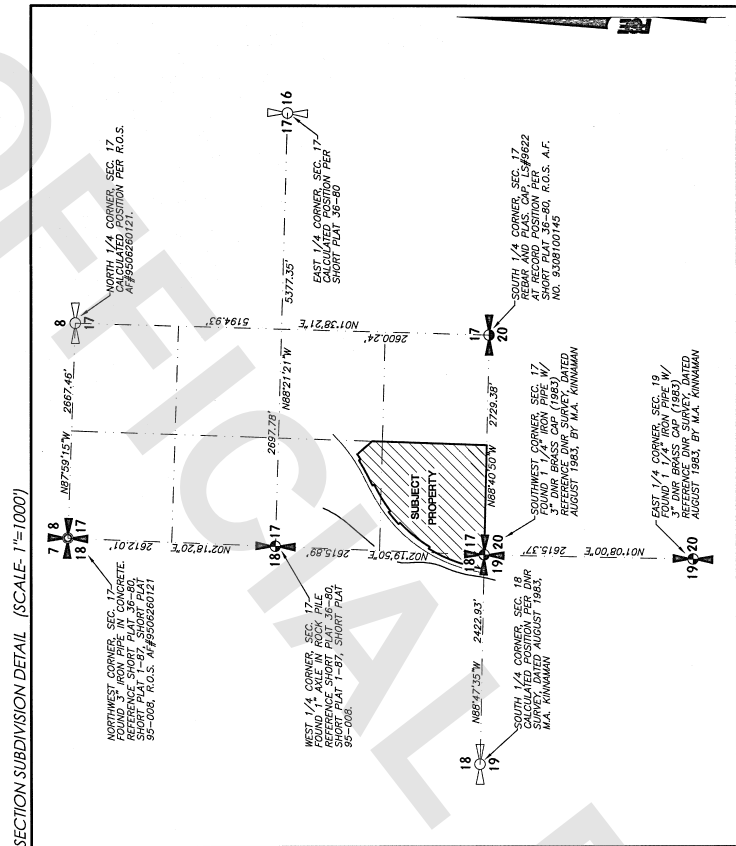


SECTION SUBDIVISION DETAIL (SCALE- 1"=1000')

AMENDED RECORD OF SURVEY

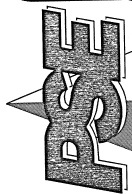

SYMBOL LEGEND

- SET 2 1/2" ALUMINUM MONUMENT, L.S. NO. 40525 (UNLESS OTHERWISE NOTED)
- SET #4 REBAR WITH YPC, L.S. NO. 40525
- FOUND IRON PIPE, NO I.D.
- FOUND #4 REBAR WITH YPC, L.S. NO. 9622

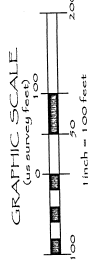

AS BUILT HIGHWAY CENTERLINE (SEE NOTE #)

SR 9 RIGHT OF WAY PER DECREE NO. 111152 SEE NOTE #8

P18145

ABANDONED NORTHERN PACIFIC RAILROAD CO R/W (SKAGIT CO PARKS DEPT.)

PROPOSED PERMIT BOUNDARY

EAST MARGIN OF SPORT COUNTRY NORTH R/W (SEE NOTE #)

SKAGIT AGGREGATES LLC PARCEL 'A'

SKAGIT AGGREGATES LLC PARCEL 'B'

LINE MARKED APPROXIMATELY EVERY 200' WITH REBAR W/ RED PLASTIC CAPS, L.S. 40525, MAGENTA MARKERS LABELED "PERMIT BOUNDARY" WITH BLUE/PINK FLAGGING.

LINE MARKED APPROXIMATELY EVERY 200' WITH REBAR W/ RED PLASTIC CAPS, L.S. 40525, MAGENTA MARKERS LABELED "PERMIT BOUNDARY" WITH BLUE/PINK FLAGGING.


LINE MARKED APPROXIMATELY EVERY 200' WITH REBAR W/ RED PLASTIC CAPS, L.S. 40525, MAGENTA MARKERS LABELED "PERMIT BOUNDARY" WITH BLUE/PINK FLAGGING.

LINE MARKED APPROXIMATELY EVERY 200' WITH REBAR W/ RED PLASTIC CAPS, L.S. 40525, MAGENTA MARKERS LABELED "PERMIT BOUNDARY" WITH BLUE/PINK FLAGGING.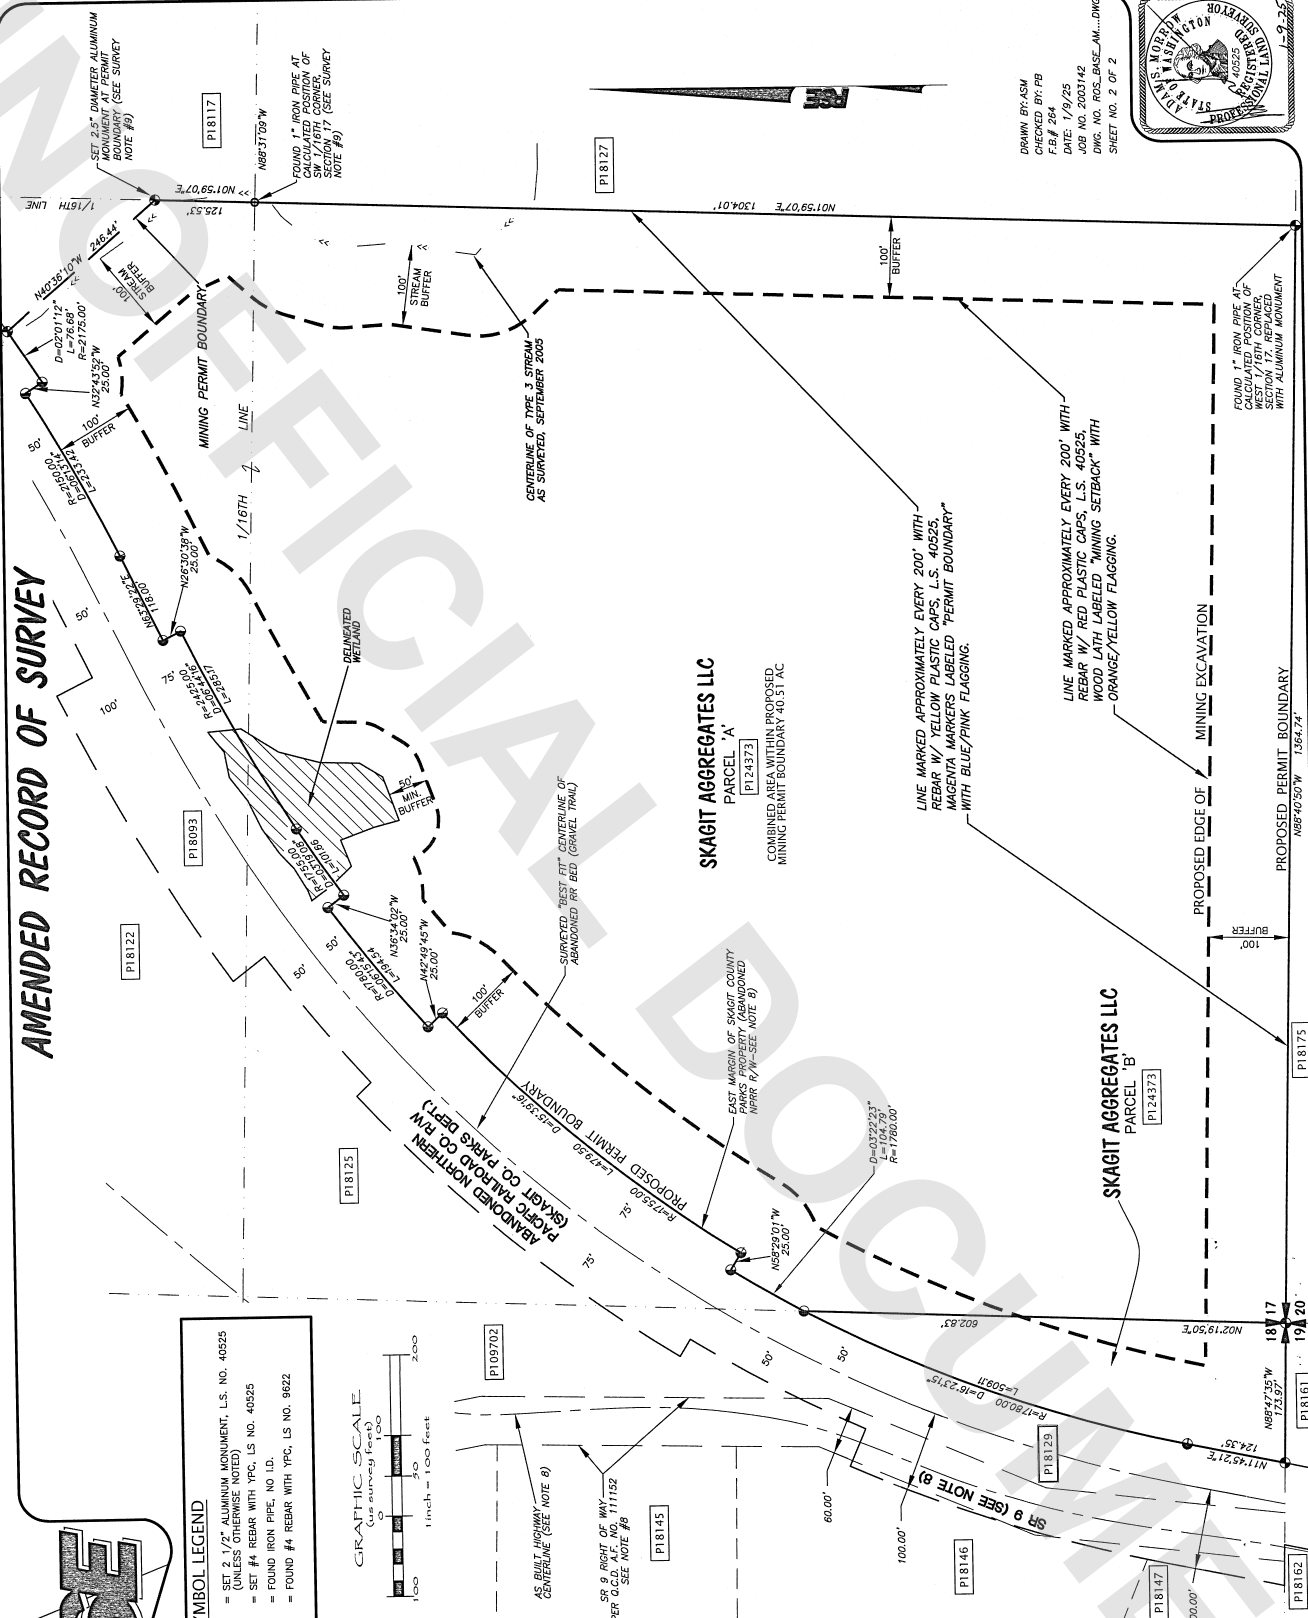

DRAWN BY: ASM
CHECKED BY: PB
DATE: 1/9/25
JOB NO. 2003742
DWG. NO. 905LSE-AM...DWG
SHEET NO. 2 OF 2

