

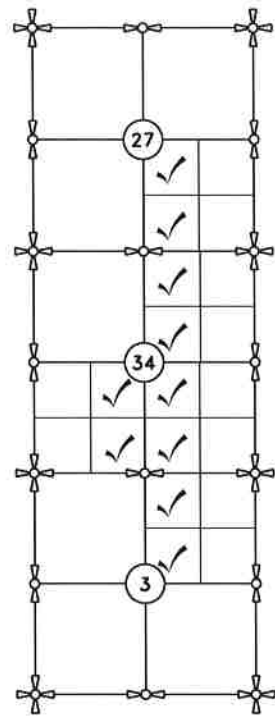


**GRIP ROAD GRAVEL MINE
ACCESS ROAD AS BUILT
SECTIONS 27 & 34, TOWNSHIP 36 NORTH, RANGE 4 EAST, W.M.
SECTION 3, TOWNSHIP 35 NORTH, RANGE 4 EAST, W.M.
SKAGIT COUNTY, WASHINGTON**

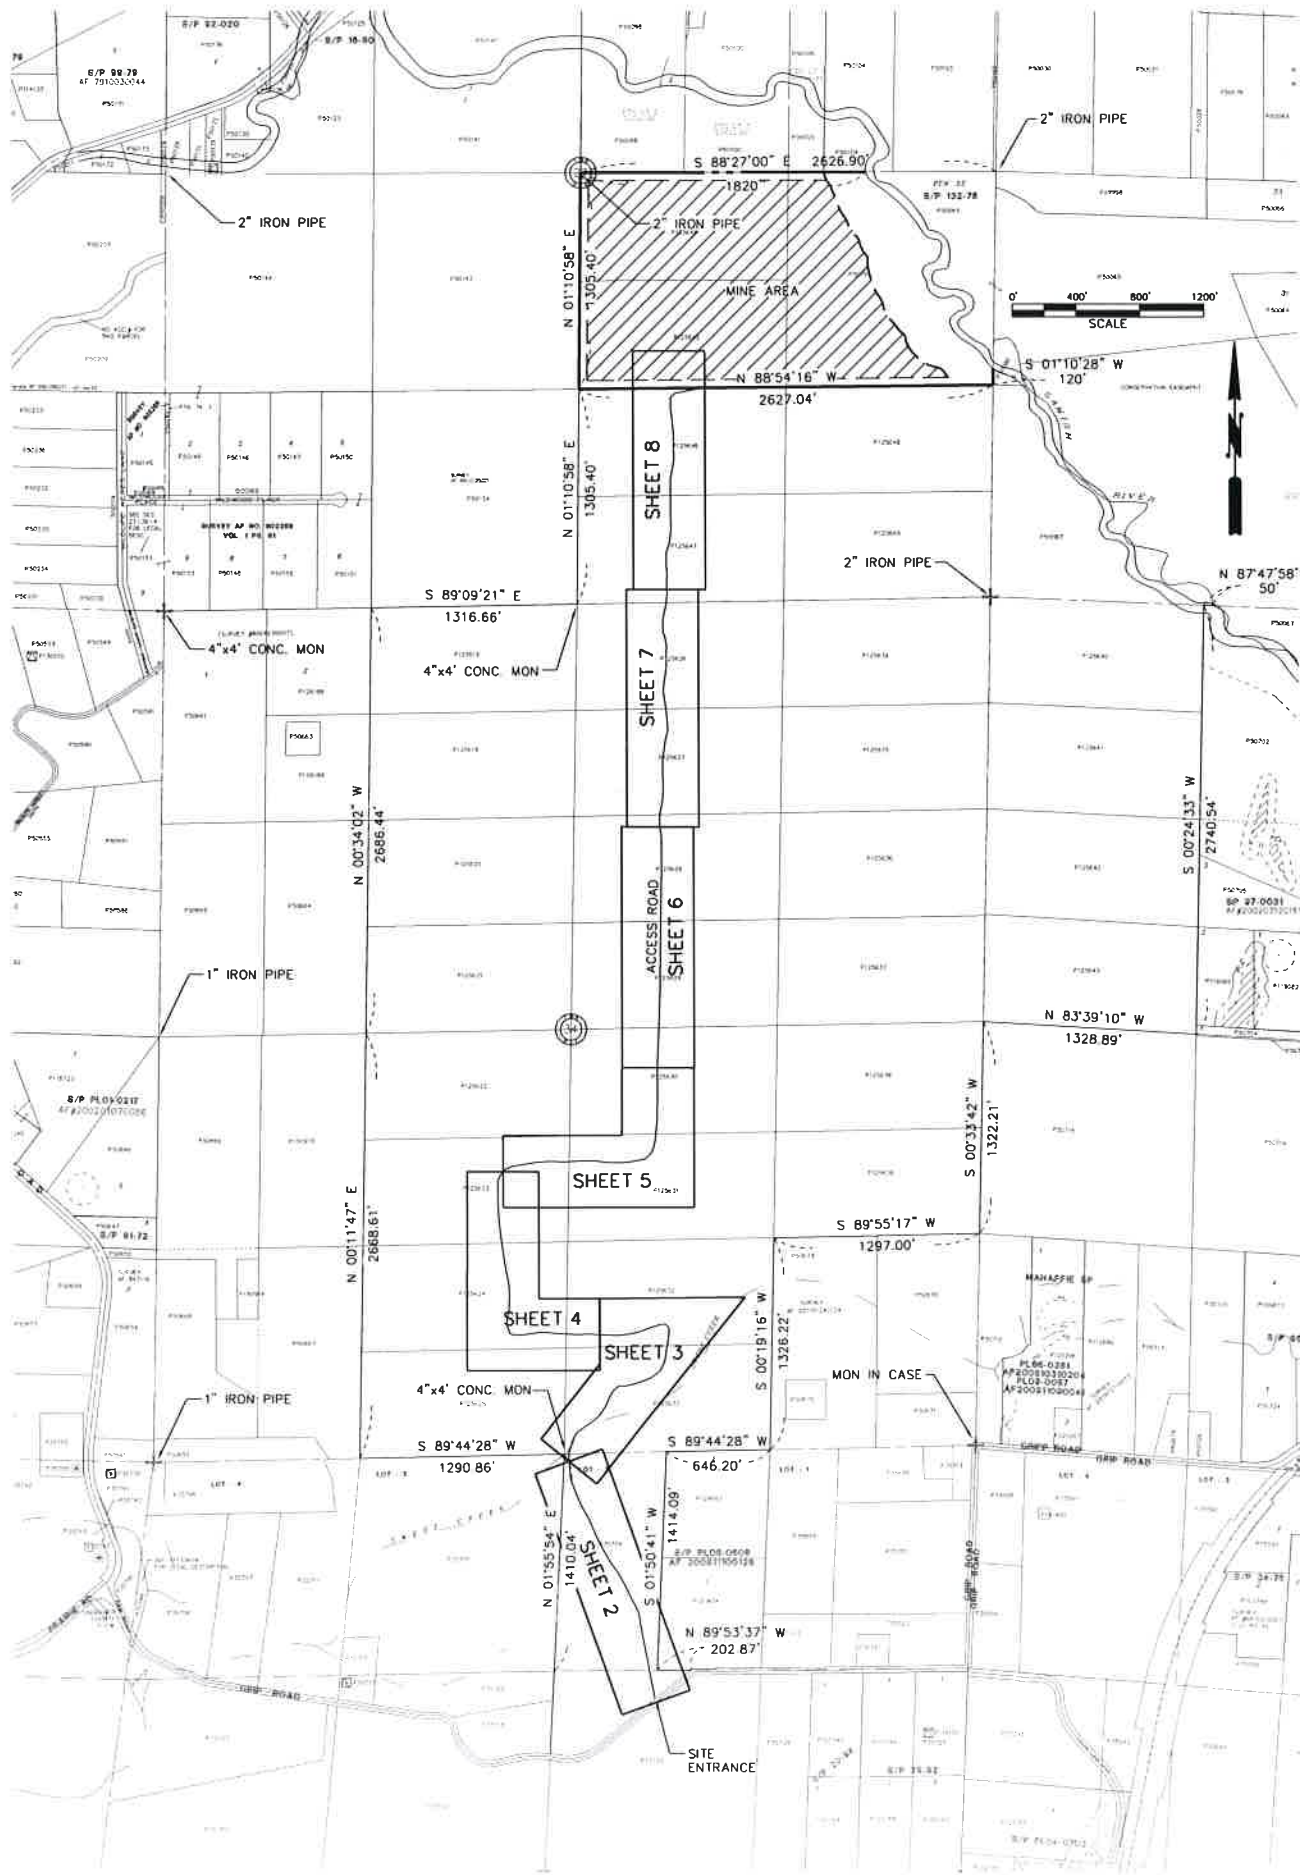

VICINITY MAP
N.T.S.

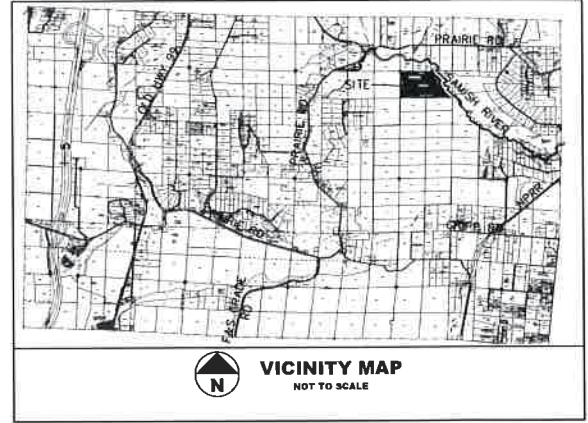

VICINITY MAP
NOT TO SCALE

APPLICANT/OWNER
MILES SAND AND GRAVEL
663 PEASE ROAD
BURLINGTON, WA 98233
CONTACT: DAN COX
TEL: (360) 757-3121

CIVIL ENGINEER/SURVEYOR
SEMRAU ENGINEERING AND SURVEYING
2118 RIVERSIDE DRIVE SUITE 208
MOUNT VERNON, WA 98273
CONTACT: JOHN B. SEMRAU P.E. & P.L.S.
TEL: (360) 424-9566

SURVEY NOTES:

- MERIDIAN: ASSUMED, BASED ON RECORDED SURVEYS
- DATUM: NAVD88, FROM RTK GPS
- CONTOURS AND FEATURES FROM TOPOGRAPHIC SURVEY BY STANDARD FIELD TRAVERSE.
- NO UTILITY RESEARCH OR LOCATE SERVICE USED. ONLY VISIBLE UTILITIES SHOWN.
- THE PURPOSE OF THIS SURVEY WAS FOR AS CONSTRUCTED ROADWAY RECORDS, AS REQUESTED BY MILES SAND AND GRAVEL
- INSTRUMENTATION USED ON THIS SURVEY:
LEICA MS50 THEODOLITE DISTANCE METER
LEICA VIVA 14 GPS/GNSS RECEIVERS
- EXCEPT AS SPECIFICALLY STATED OR SHOWN ON THIS SURVEY MAP, THIS SURVEY DOES NOT PURPORT TO REFLECT ALL OF THE FOLLOWING WHICH MAY BE APPLICABLE TO THE SUBJECT REAL ESTATE: EASEMENTS, BUILDING SETBACKS LINES, RESTRICTIVE COVENANTS, SUBDIVISION RESTRICTIONS, ZONING OR OTHER LAND-USE REGULATIONS AND ANY OTHER FACTS THAT AN ACCURATE AND CURRENT TITLE SEARCH MAY DISCLOSE.

TABLE OF CONTENTS

SHEET NO.	DRAWING TITLE
1	CONTENTS AND VICINITY MAP
2	STATION 0+00 TO STATION 15+00
3	STATION 15+00 TO STATION 30+00
4	STATION 30+00 TO STATION 45+00
5	STATION 45+00 TO STATION 60+00
6	STATION 60+00 TO STATION 75+00
7	STATION 75+00 TO STATION 90+00
8	STATION 90+00 TO STATION 105+00
9	CROSS-SECTIONS
10	SIGNAGE PLAN STATION 15+00 TO 30+00





SHEET 1 OF 10

**CONTENTS AND VICINITY MAP
GRIP ROAD GRAVEL MINE ACCESS ROAD AS BUILT
SECTIONS 27 & 34, T. 36 N., R. 4 E., W.M.
SECTION 3, T. 35 N., R. 4 E., W.M.
SKAGIT COUNTY, WASHINGTON**




DATUM: NAVD 88	SEMRAU ENGINEERING & SURVEYING	SCALE: 1" = 600'
MERIDIAN: ASSUMED	SURVEYING • ENGINEERING • PLANNING MOUNT VERNON, WA 98273 360-424-9566	JOB NO. 5166

DRAWING FILE: 5166CSAB.DWG 9/04/18

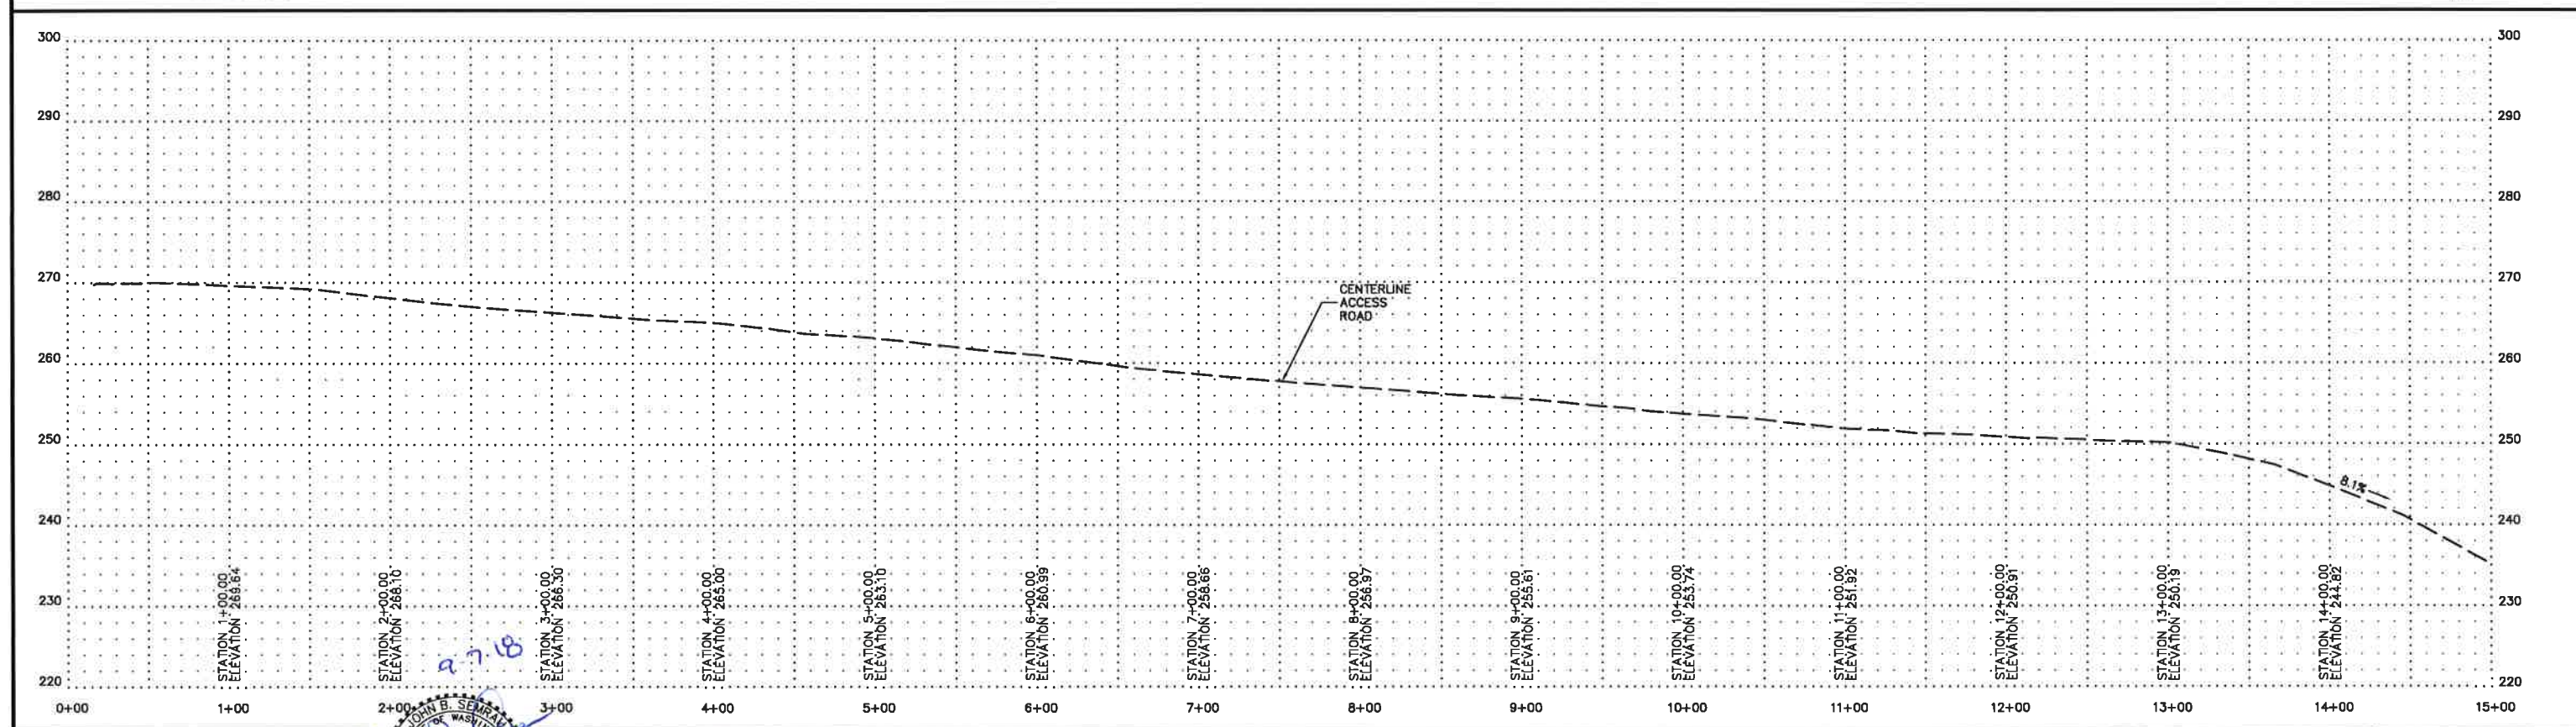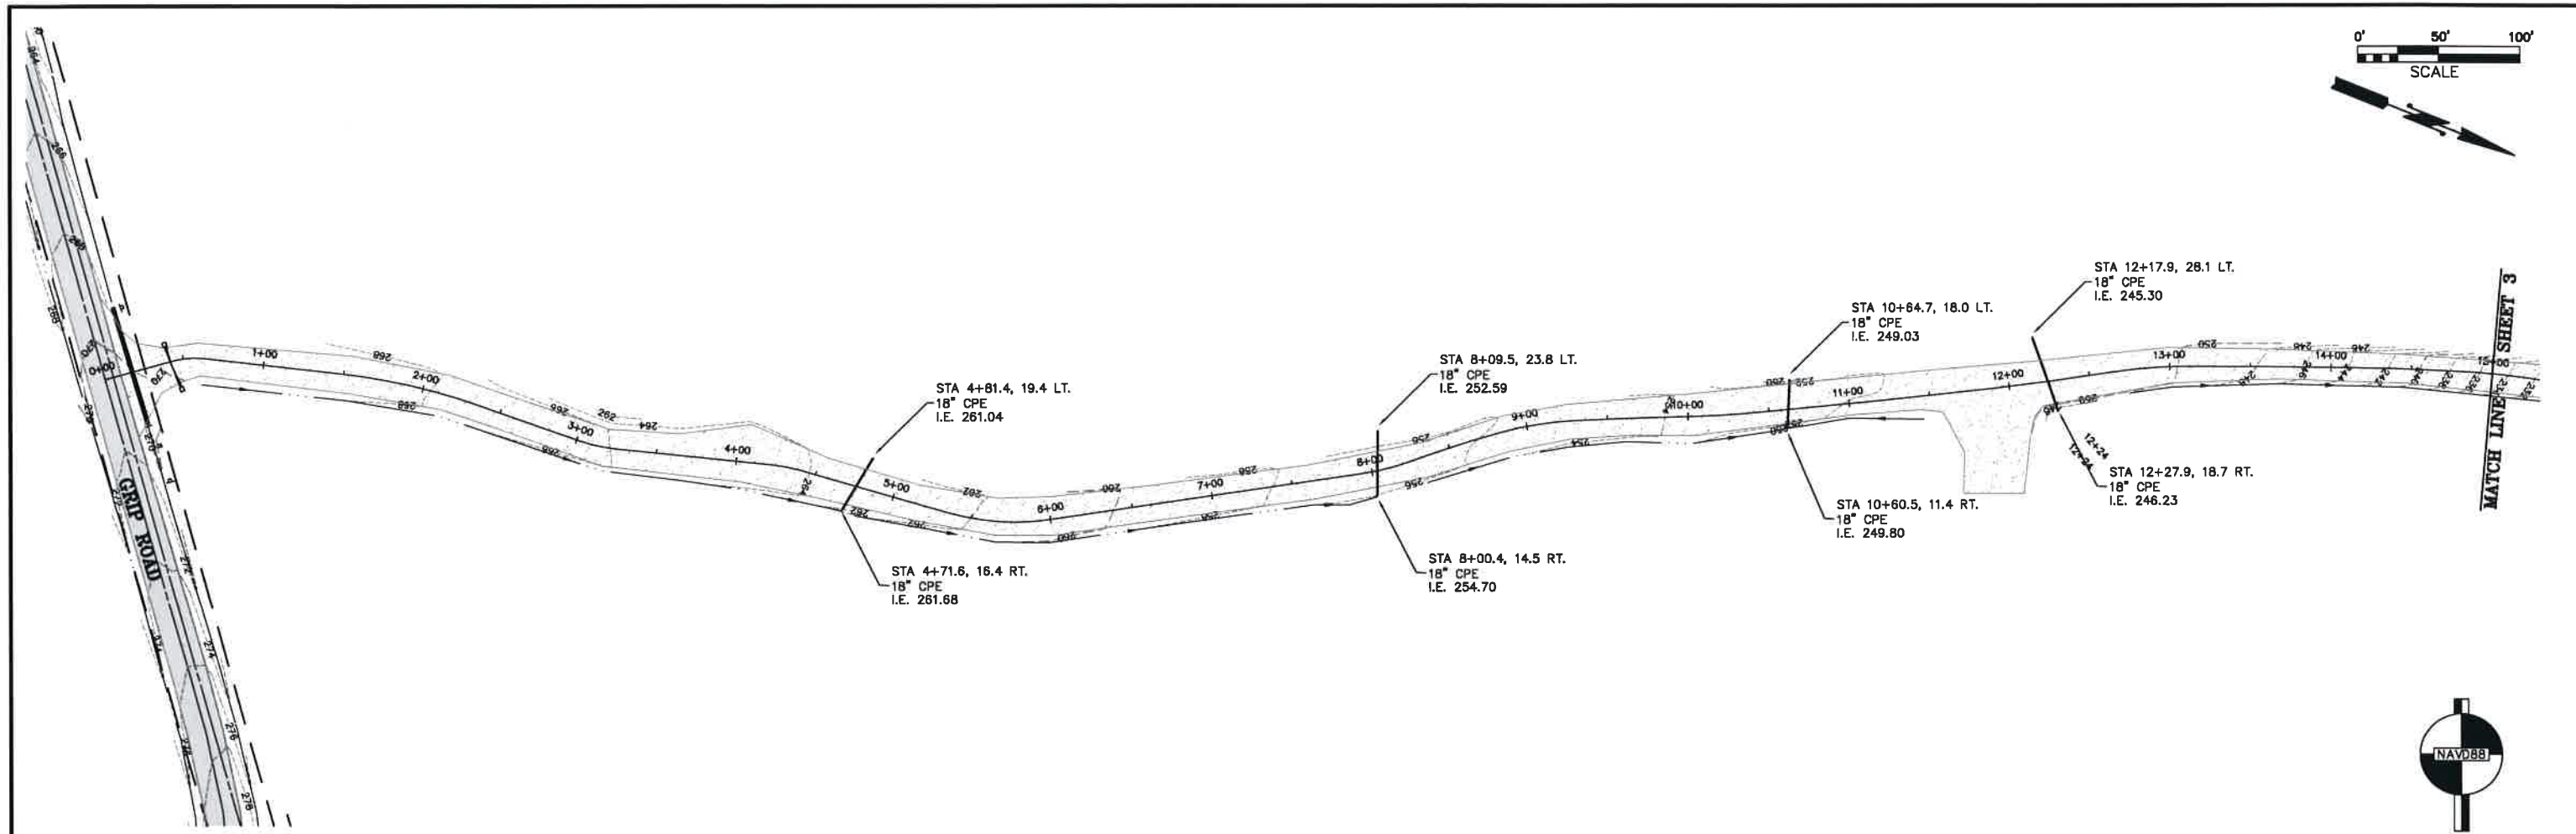

COPYRIGHT 2018
SEMBAU ENGINEERING & SURVEYING, PLLC
 CIVIL ENGINEERING • LAND SURVEYING • PLANNING
 2118 RIVERSIDE DRIVE - SUITE 208
 MOUNT VERNON, WA 98273
 360-424-9566

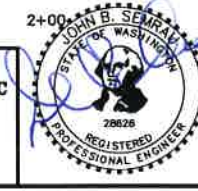



NO.	DATE	REVISION	BY	REV.

**PLAN AND PROFILE
 STATION 0+00 TO 15+00**


SCALES:
 HORIZONTAL: 1" = 50'
 VERTICAL: 1" = 10'
 NOTE: IF THIS SHEET IS LESS THAN 22" x 34" THEN SHEET HAS BEEN REDUCED

**GRIP ROAD GRAVEL MINE
 ACCESS ROAD AS BUILT**
 SEC. 27, 34, T. 36 N., SEC. 3, T. 35 N., R. 4 E., W.M.
 SKAGIT COUNTY, WASHINGTON

FIELD BK/PG: 311/34-79
 DATE: 9/04/18
 DRAWING: 5166PNP.DWG
 JOB NO.: 5166
 SHEET: 2

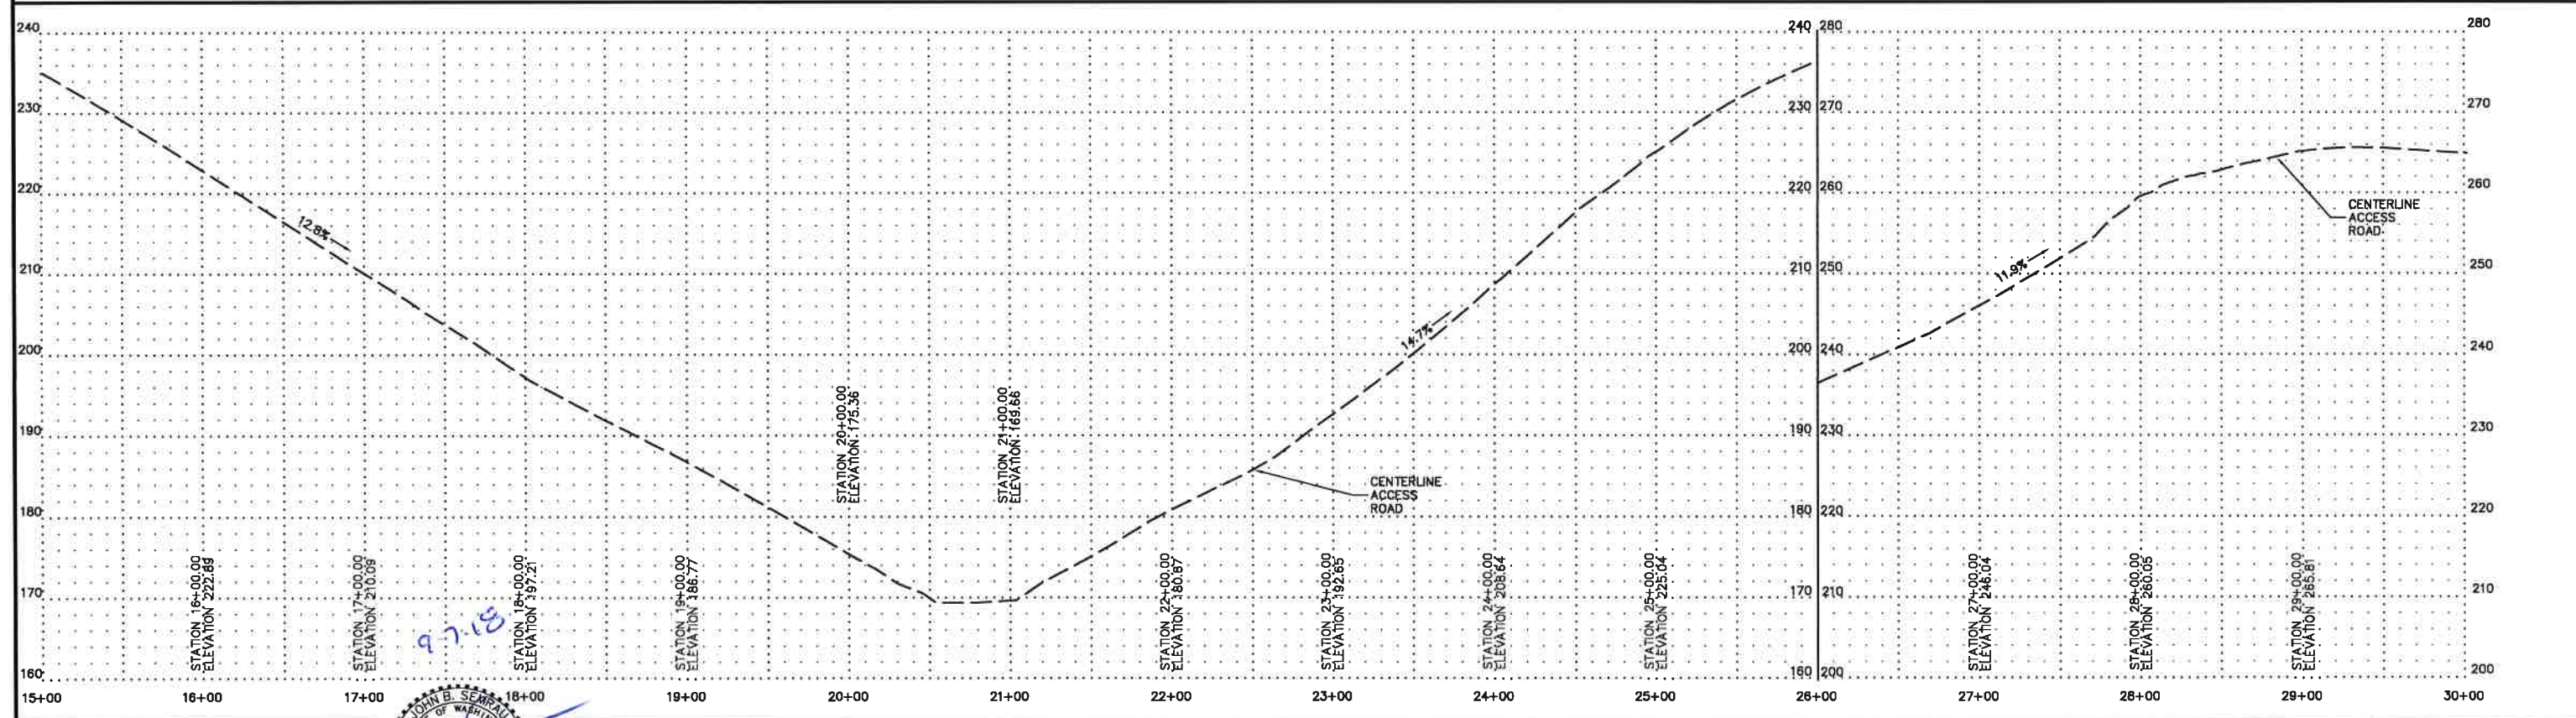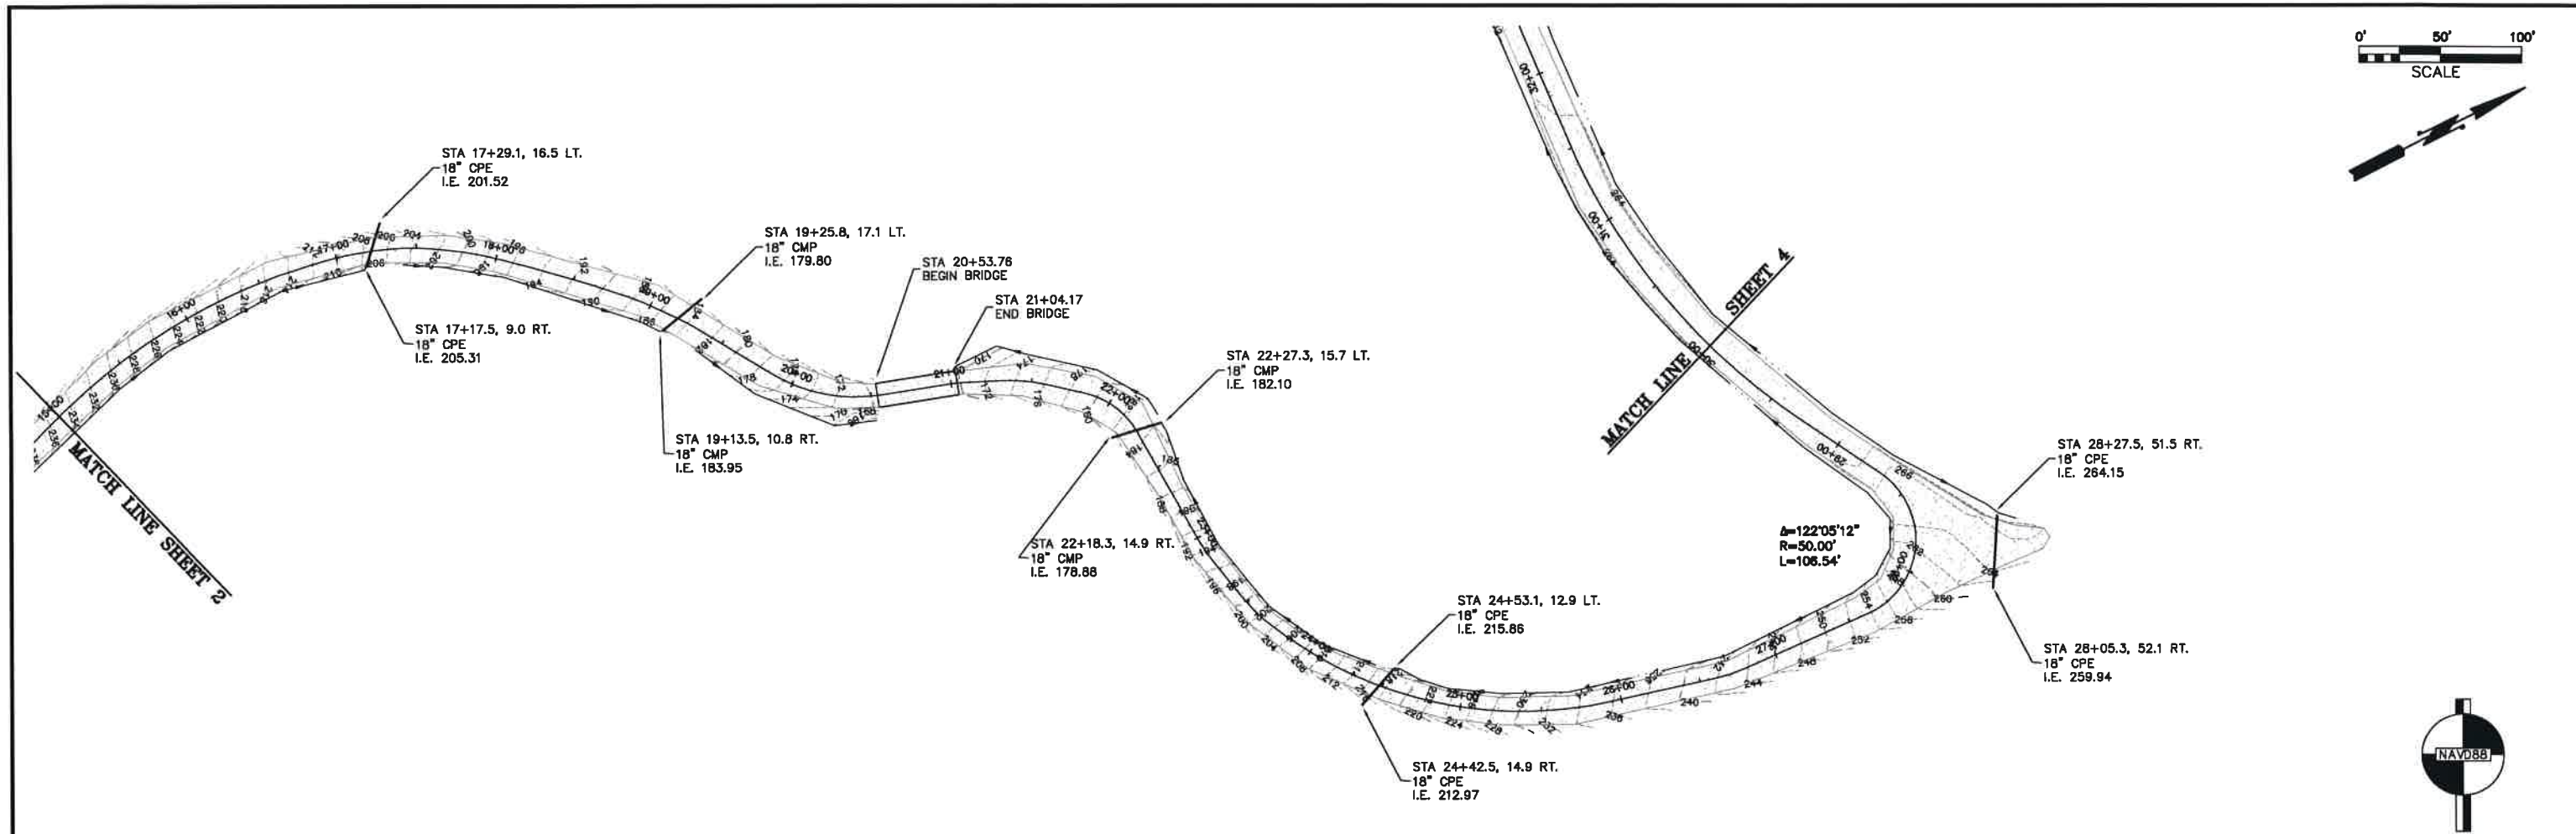

COPYRIGHT 2018
SEMRAU ENGINEERING & SURVEYING, PLLC
 CIVIL ENGINEERING • LAND SURVEYING • PLANNING
 2118 RIVERSIDE DRIVE - SUITE 208
 MOUNT VERNON, WA 98273
 360-424-9586

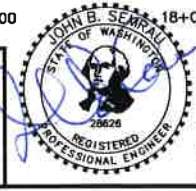




NO.	DATE	REVISION	BY	REV.

PLAN AND PROFILE
STATION 15+00 TO 30+00


SCALES:
 HORIZONTAL : 1" = 50'
 VERTICAL : 1" = 10'
 NOTE: IF THIS SHEET IS LESS THAN 22" x 34" THEN SHEET HAS BEEN REDUCED

GRIP ROAD GRAVEL MINE
ACCESS ROAD AS BUILT
 SEC. 27, 34, T. 36 N., SEC. 3, T. 35 N., R. 4 E., W.M.
 SKAGIT COUNTY, WASHINGTON

FIELD BK/PG: 311/34-79
 DATE: 9/04/18
 DRAWING: 5166PNP.DWG
 JOB NO.: 5166
 SHEET: 3

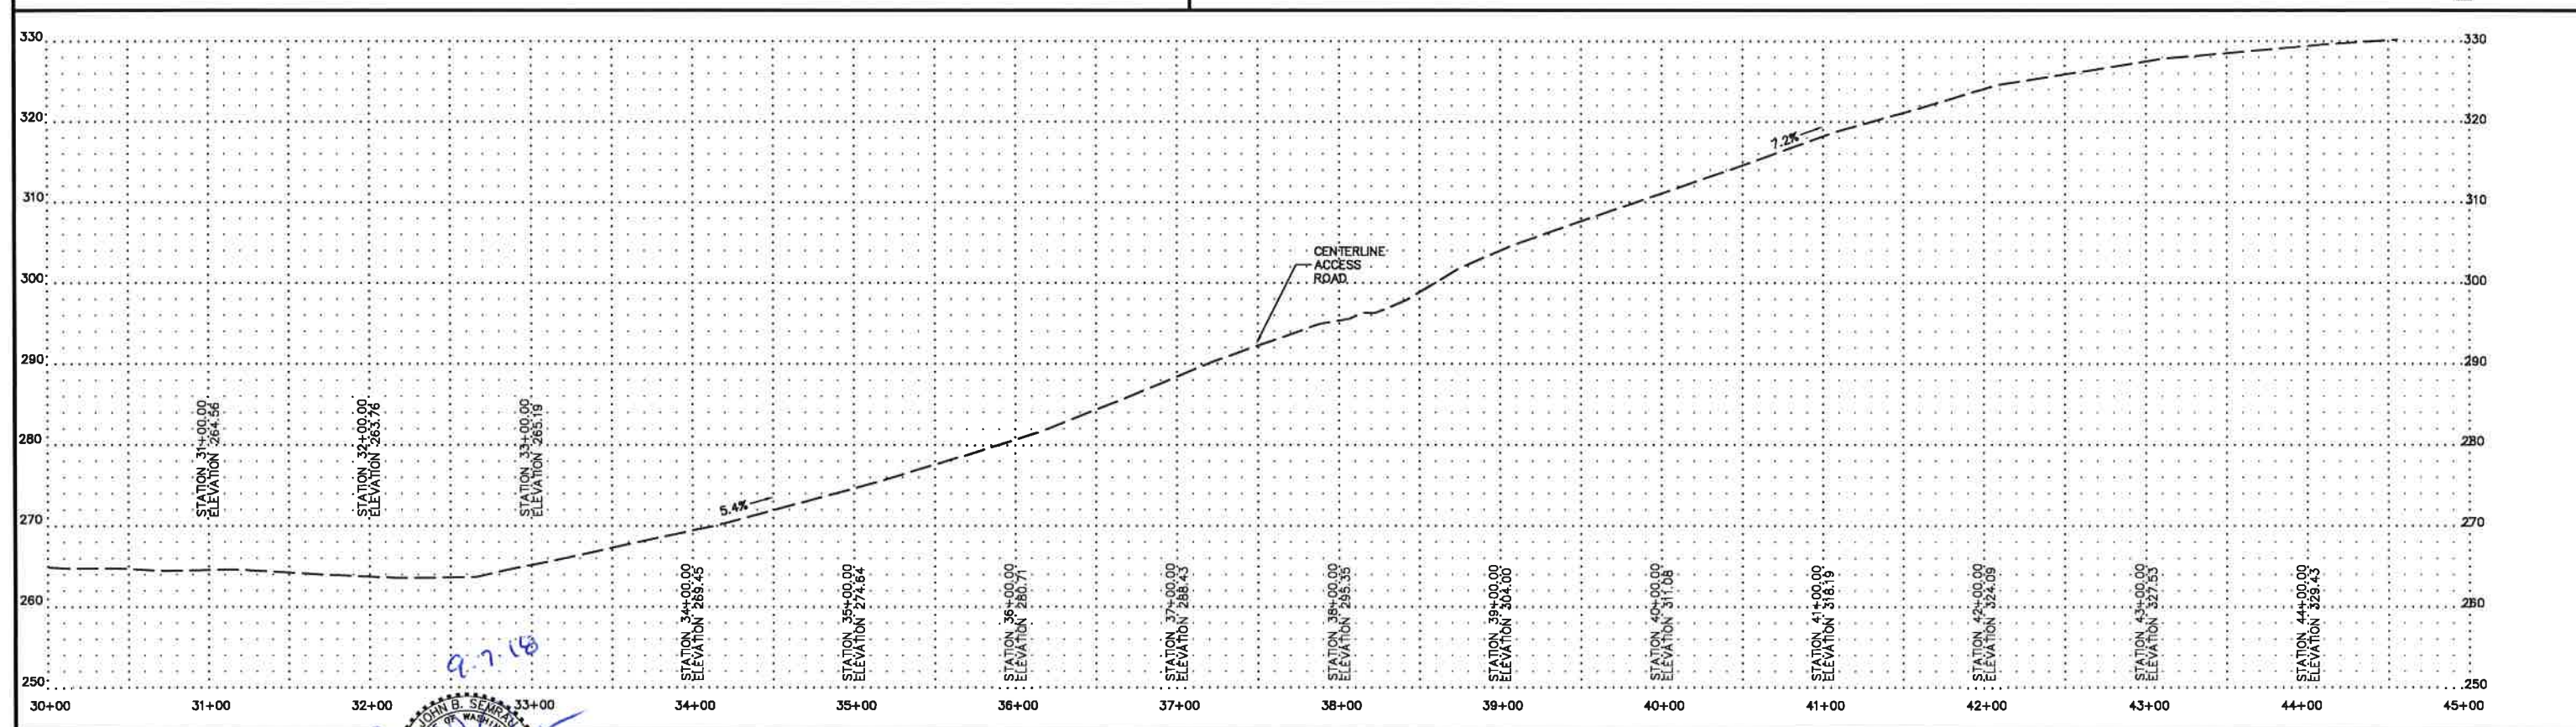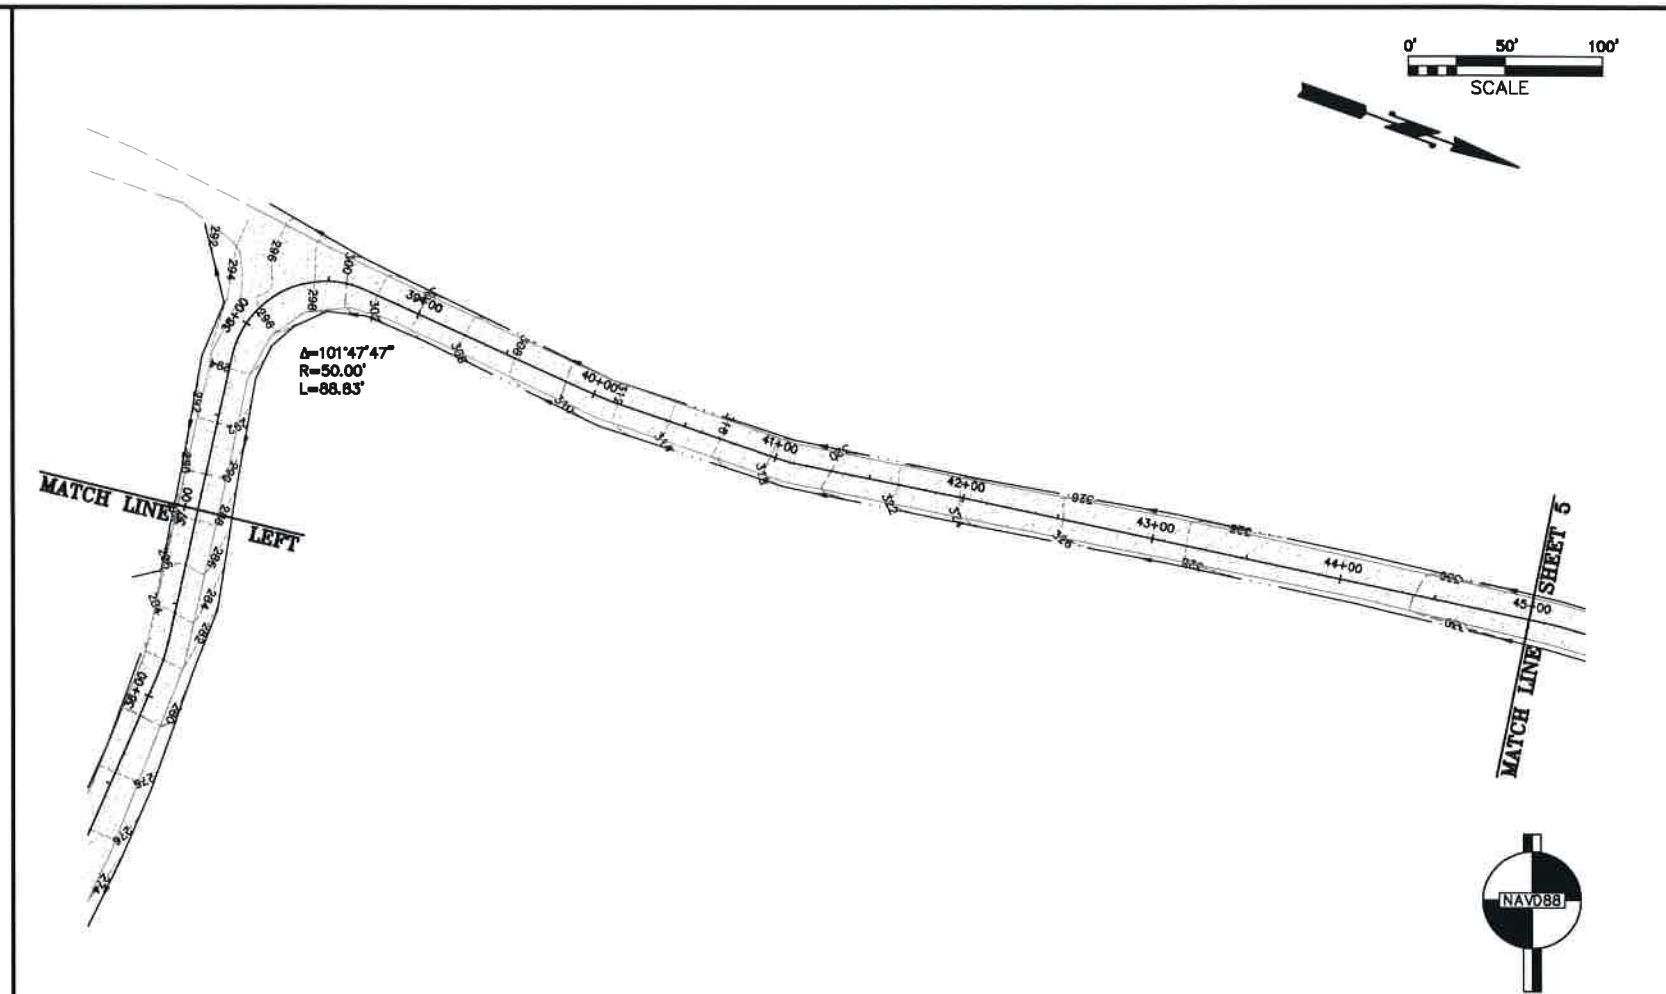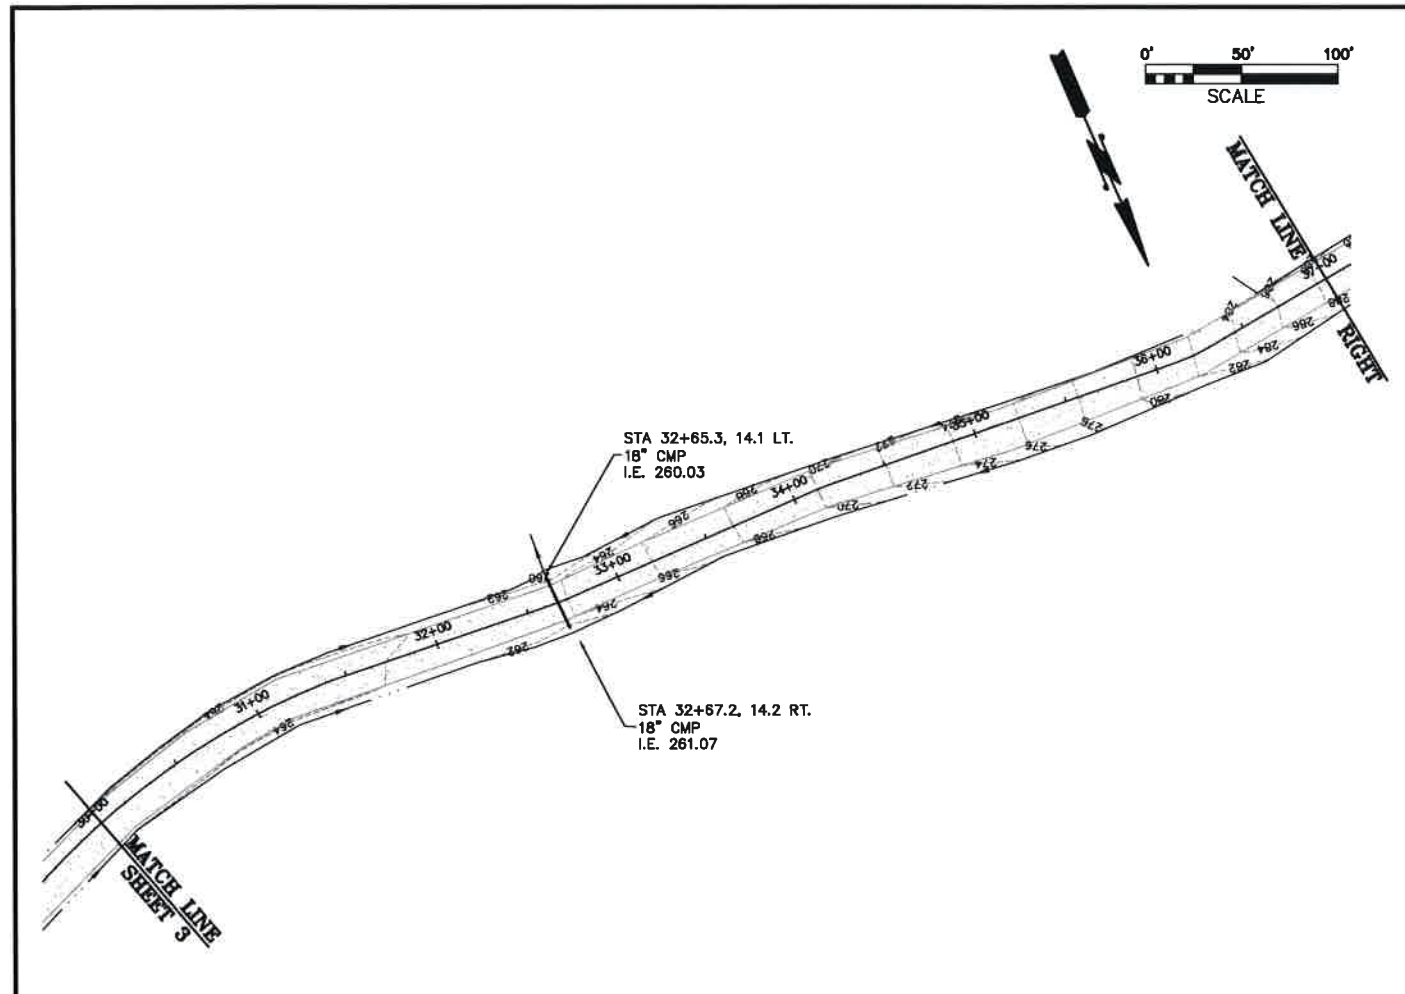

COPYRIGHT 2018
SEMRAU ENGINEERING & SURVEYING, PLLC
 CIVIL ENGINEERING • LAND SURVEYING • PLANNING
 2118 RIVERSIDE DRIVE - SUITE 208
 MOUNT VERNON, WA 98273
 360-424-9566

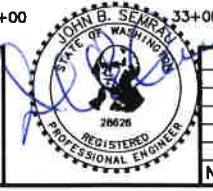



NO.	DATE	REVISION	BY	REV.

PLAN AND PROFILE
STATION 30+00 TO 45+00

SCALES:
 HORIZONTAL: 1" = 50'
 VERTICAL: 1" = 10'
 NOTE: IF THIS SHEET IS LESS THAN 22" x 34" THEN SHEET HAS BEEN REDUCED

GRIP ROAD GRAVEL MINE
ACCESS ROAD AS BUILT
 SEC. 27, 34, T. 36 N., SEC. 3, T. 35 N., R. 4 E., W.M.
 SKAGIT COUNTY, WASHINGTON

FIELD BK/PG: 311/34-79
DATE: 9/04/18
DRAWING: 5166PNP.DWG
JOB NO.: 5166
SHEET: 4

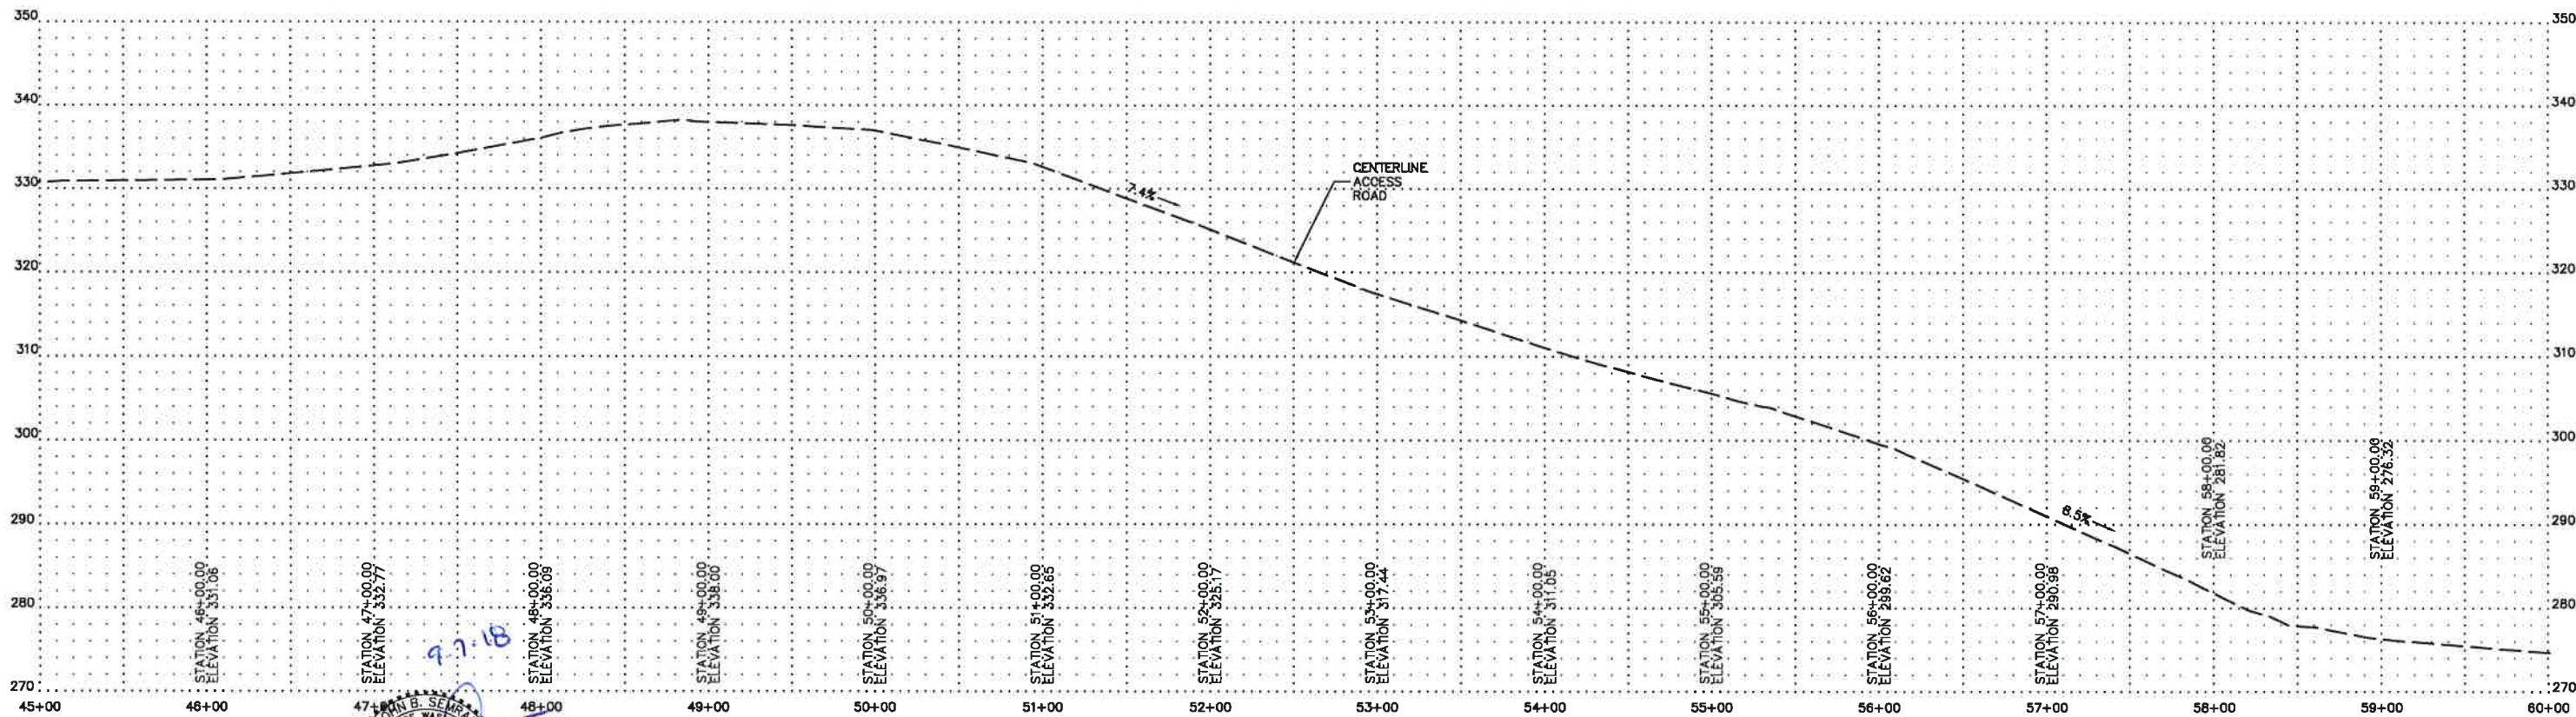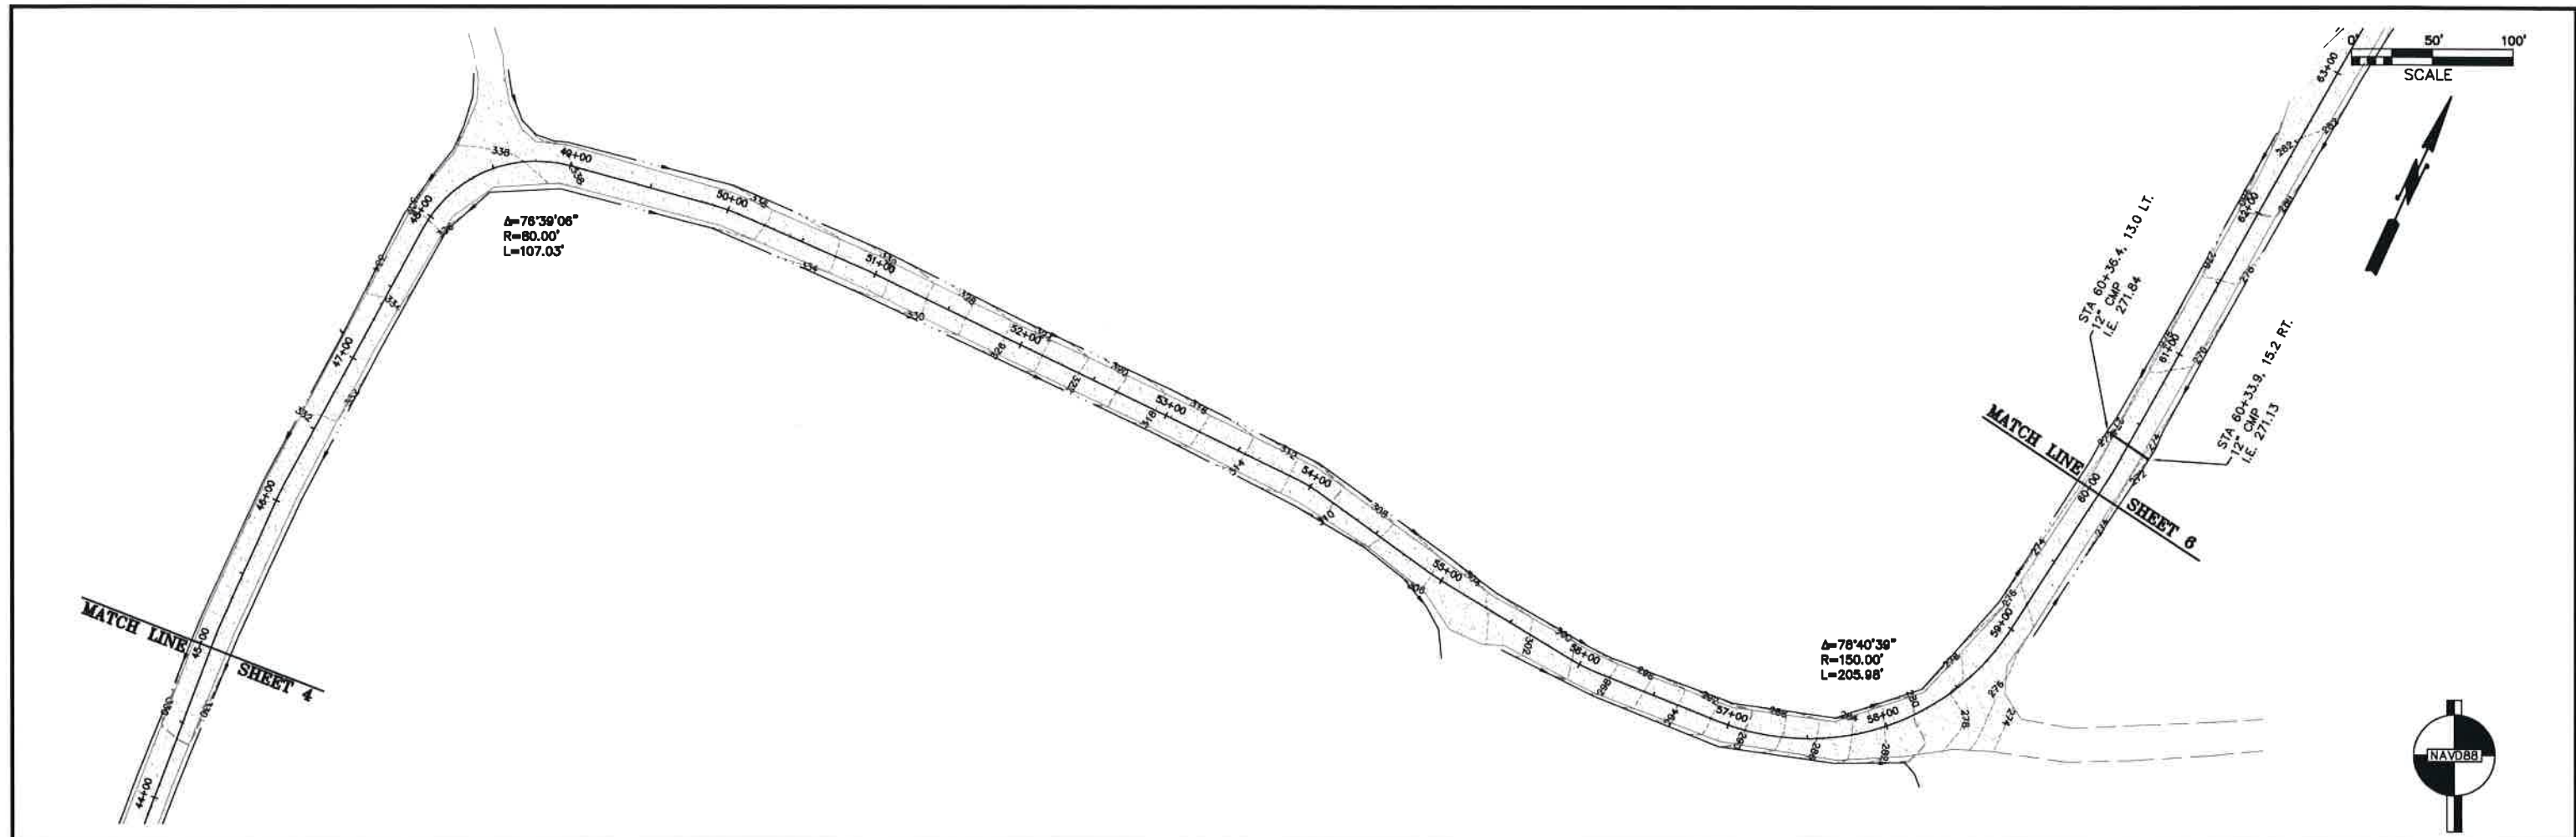

COPYRIGHT 2018
SEMRAU ENGINEERING & SURVEYING, PLLC
 CIVIL ENGINEERING • LAND SURVEYING • PLANNING
 2118 RIVERSIDE DRIVE - SUITE 208
 MOUNT VERNON, WA 98273
 360-424-9566





NO.	DATE	REVISION	BY	REV.

**PLAN AND PROFILE
 STATION 45+00 TO 60+00**

SCALES:
 HORIZONTAL : 1" = 50'
 VERTICAL : 1" = 10'
 NOTE: IF THIS SHEET IS LESS THAN 22" x 34" THEN SHEET HAS BEEN REDUCED

**GRIP ROAD GRAVEL MINE
 ACCESS ROAD AS BUILT**
 SEC. 27, 34, T. 36 N., SEC. 3, T. 35 N., R. 4 E., W.M.
 SKAGIT COUNTY, WASHINGTON

FIELD BK/PG:	311/34-79
DATE:	9/04/18
DRAWING:	5186PNP.DWG
JOB NO.:	5186
SHEET:	5

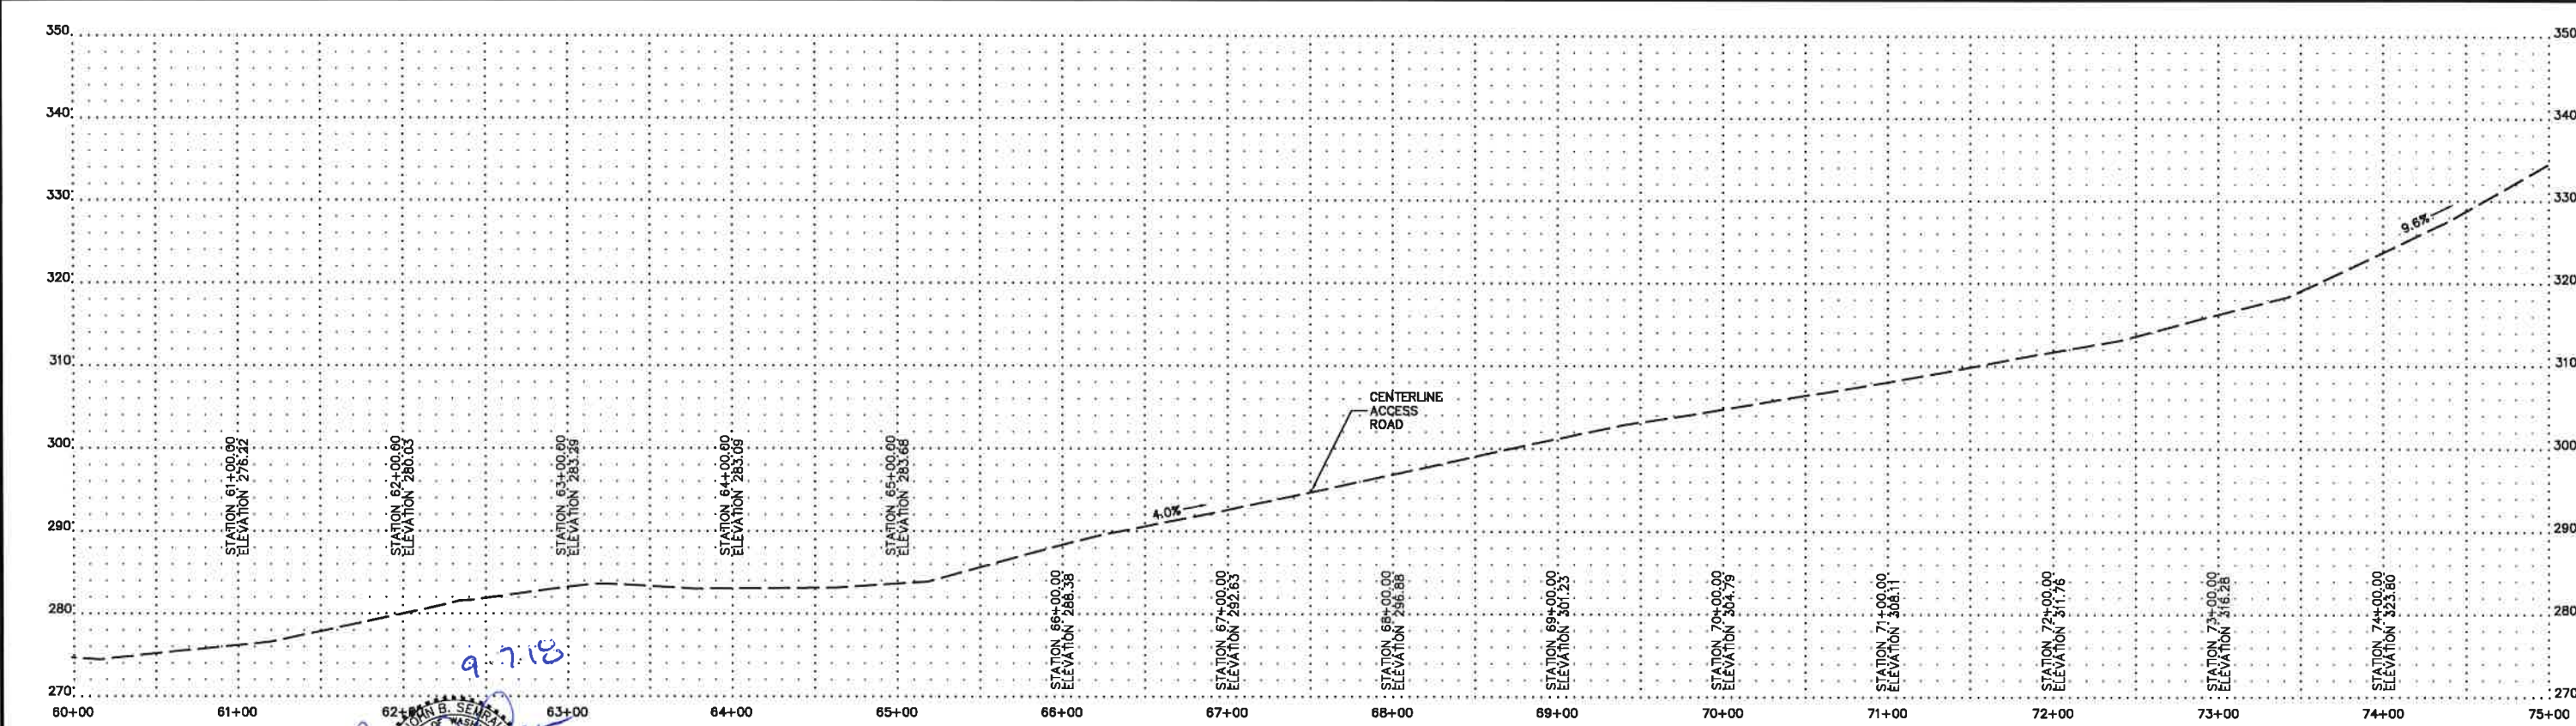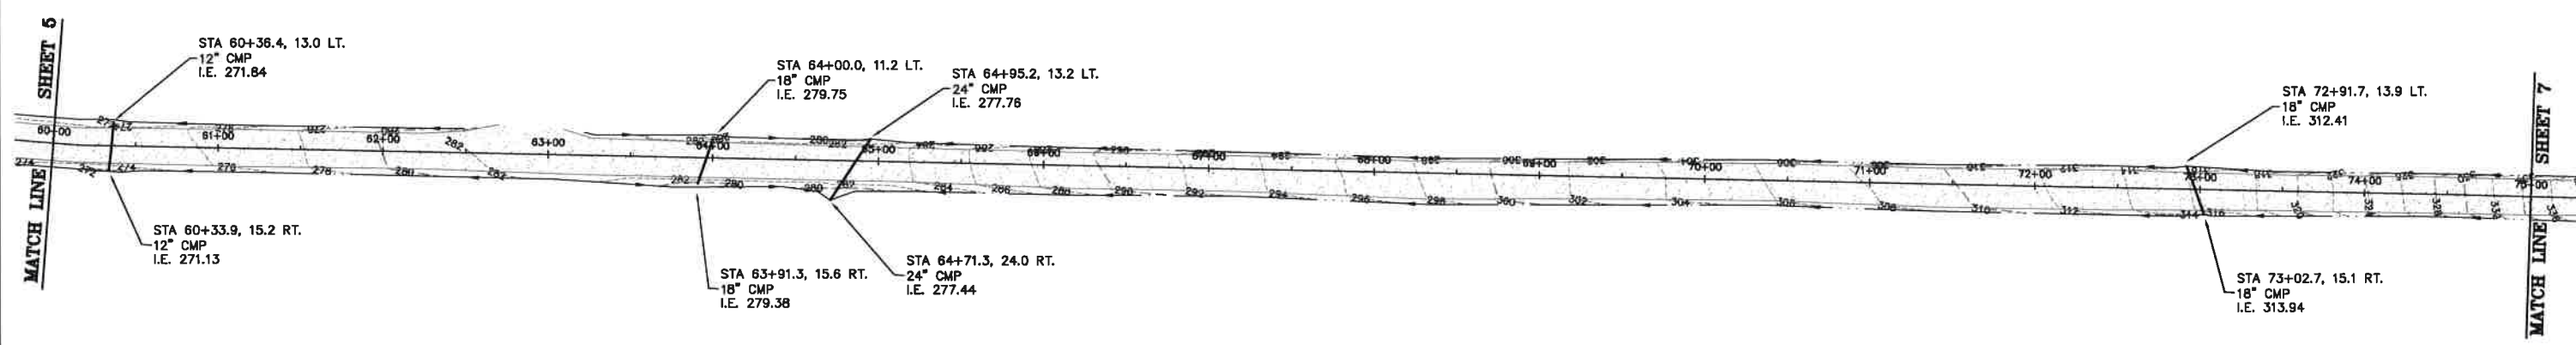

COPYRIGHT 2018
SEMRAU ENGINEERING & SURVEYING, PLLC
 CIVIL ENGINEERING • LAND SURVEYING • PLANNING
 2118 RIVERSIDE DRIVE - SUITE 208
 MOUNT VERNON, WA 98273
 360-424-9566



NO.	DATE	REVISION	BY	REV.




**PLAN AND PROFILE
 STATION 60+00 TO 75+00**

SCALES:
 HORIZONTAL: 1" = 50'
 VERTICAL: 1" = 10'

NOTE: IF THIS SHEET IS LESS THAN 22" x 34" THEN SHEET HAS BEEN REDUCED

**GRIP ROAD GRAVEL MINE
 ACCESS ROAD AS BUILT**
 SEC. 27, 34, T. 36 N., SEC. 3, T. 35 N., R. 4 E., W.M.
 SKAGIT COUNTY, WASHINGTON

FIELD BK/PG: 311/34-79
 DATE: 9/04/18
 DRAWING: 5166PNP.DWG
 JOB NO.: 5166
 SHEET: 6

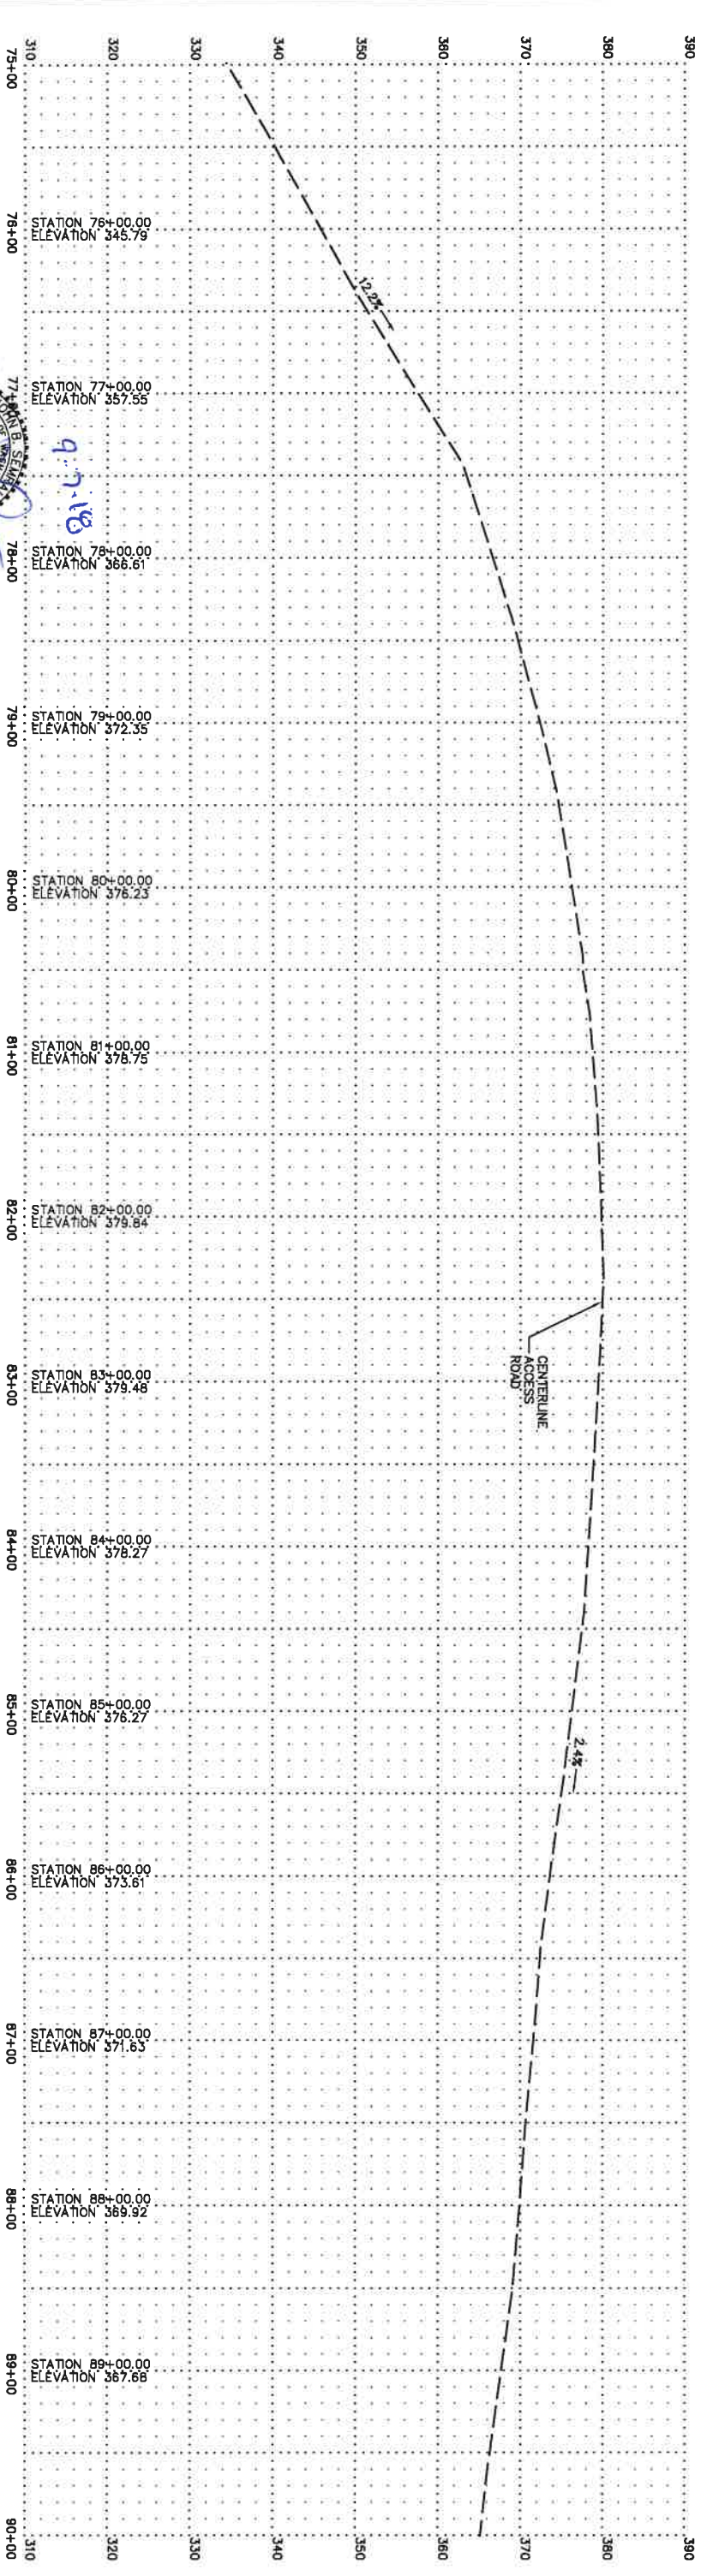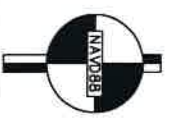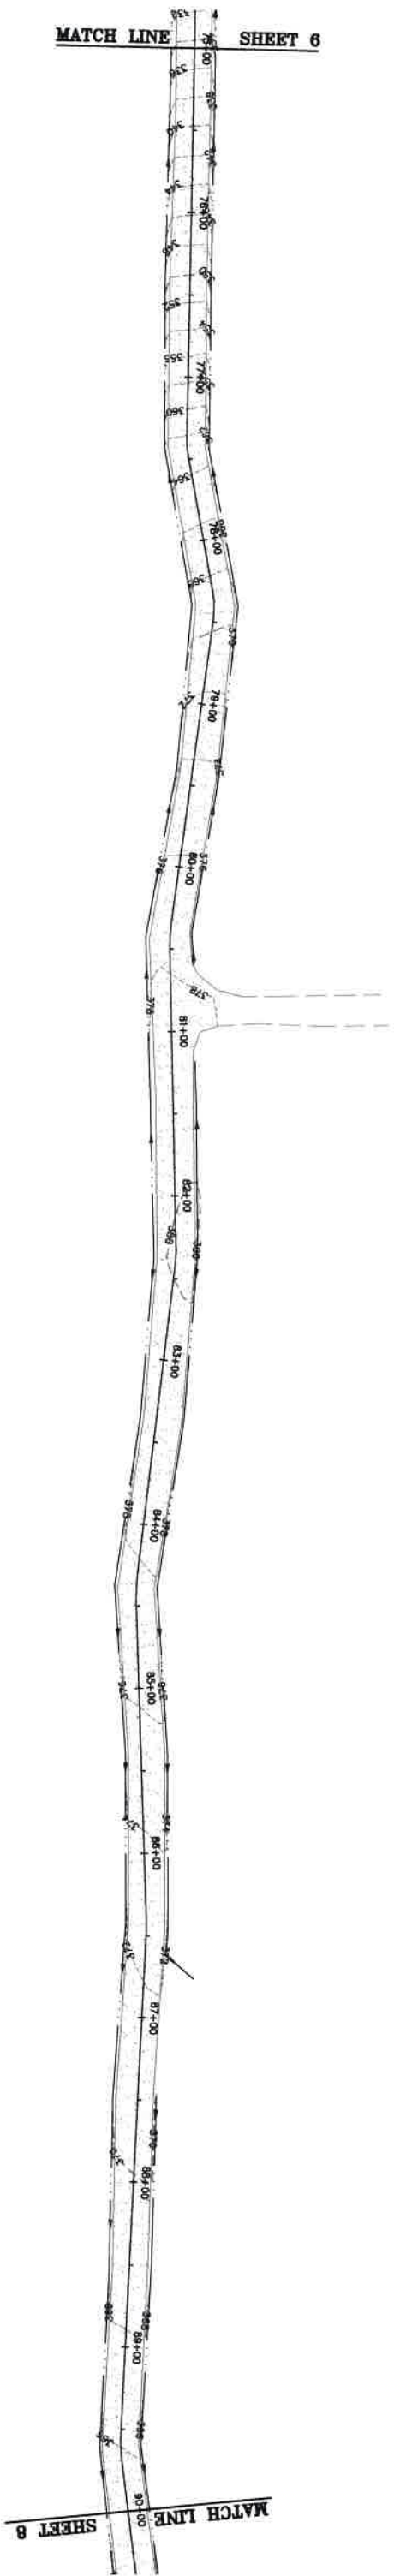

SKAGIT ENGINEERING & SURVEYING, PLLC
 CIVIL ENGINEERING • LAND SURVEYING • PLANNING
 2118 RIVERSIDE DRIVE - SUITE 208
 MOUNT VERNON, WA 98273
 360-424-9566



COPYRIGHT 2018



NO.	DATE	REVISION	BY	REV.

PLAN AND PROFILE
 STATION 75+00 TO 90+00

SCALES:
 HORIZONTAL : 1" = 50'
 VERTICAL : 1" = 10'
 NOTE: IF THIS SHEET IS LESS THAN 22" x 34" THEN SHEET HAS BEEN REDUCED

GRIP ROAD GRAVEL MINE
 ACCESS ROAD AS BUILT
 SEC. 27, 34, T. 36 N., SEC. 3, T. 35 N., R. 4 E., W.M.
 SKAGIT COUNTY, WASHINGTON

FIELD BK/Pg:	311/34-79
DATE:	9/04/18
DRAWING:	5168PMP.DWG
JOB NO.:	5168
SHEET:	7

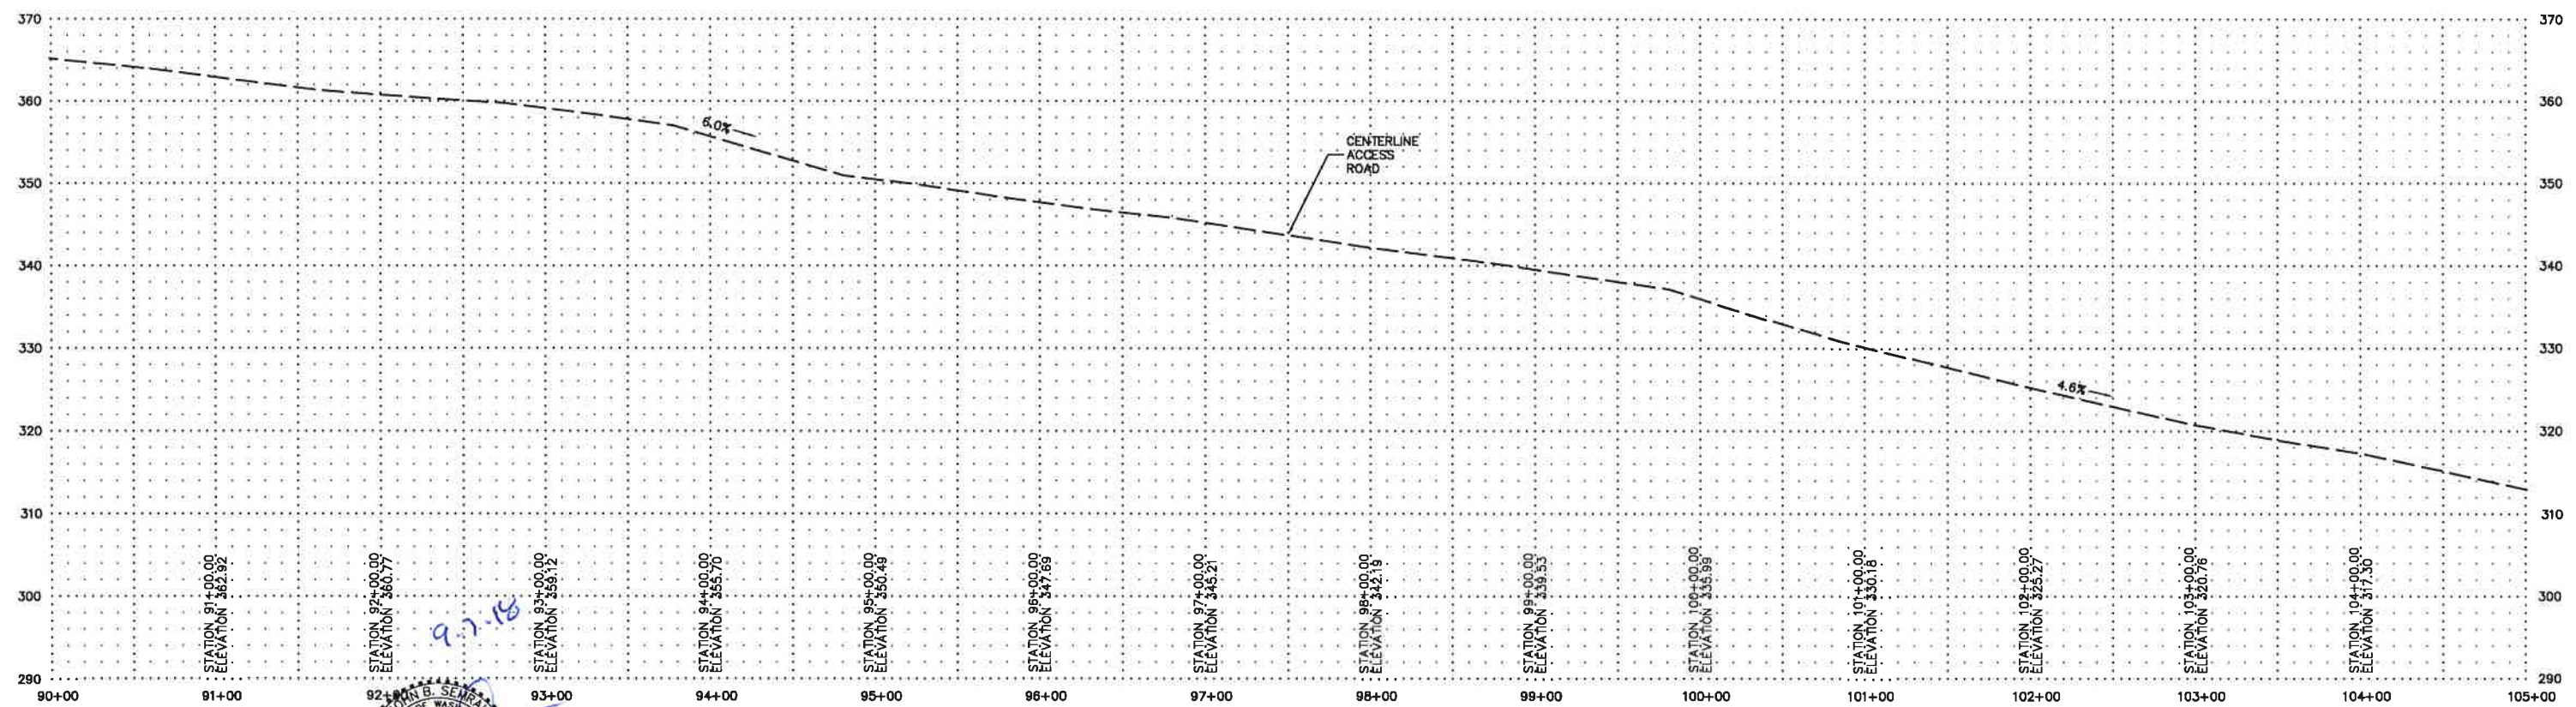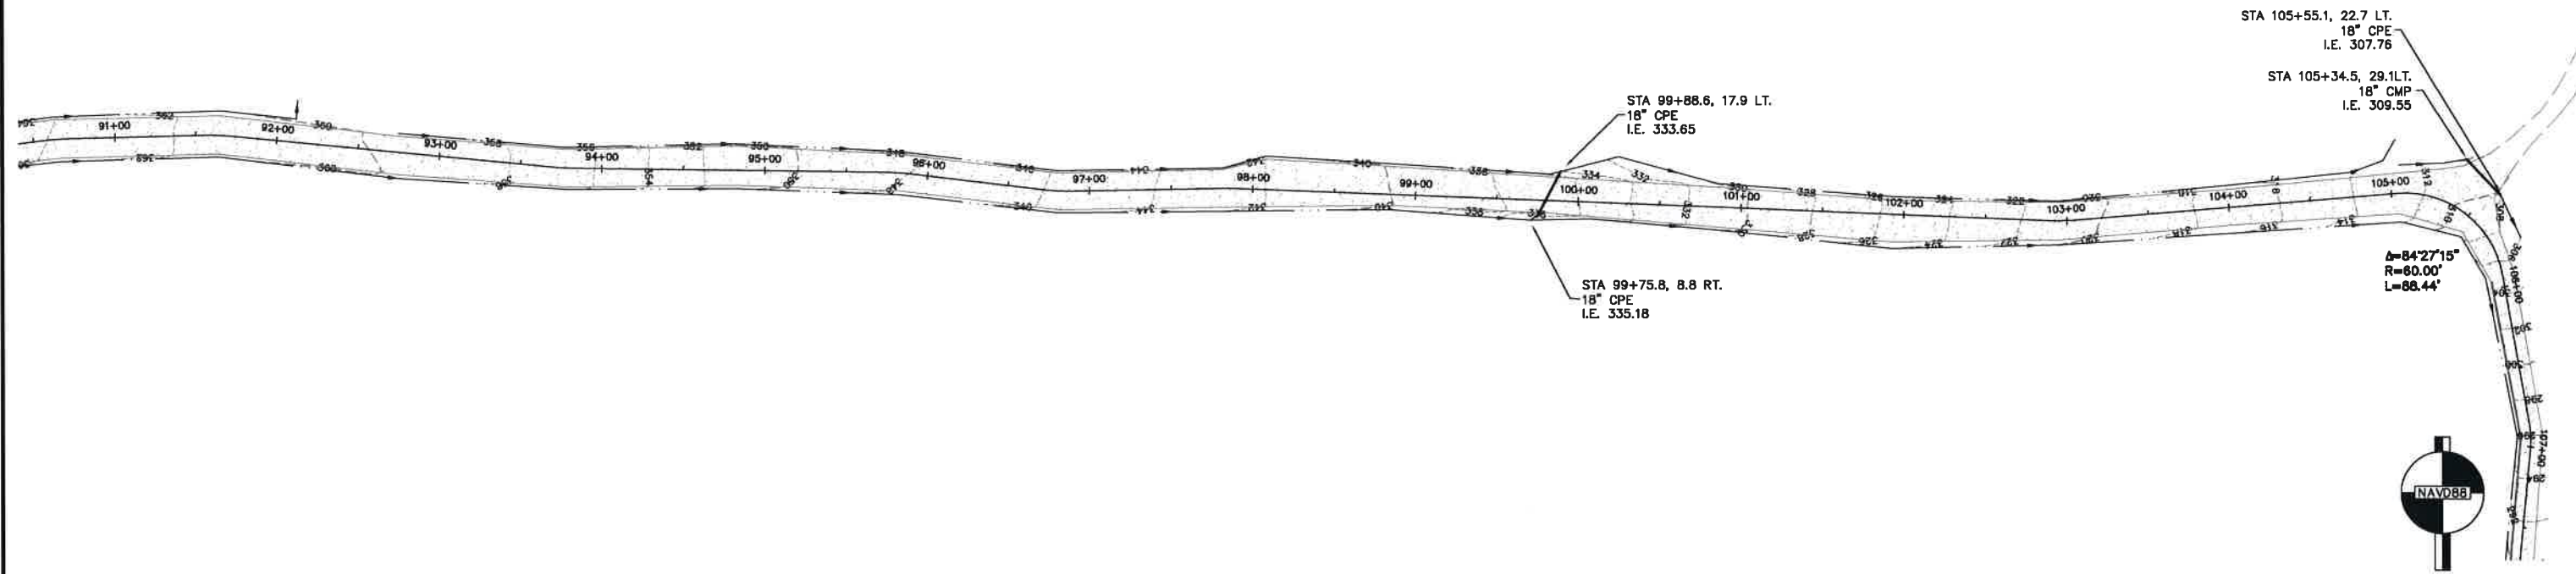

COPYRIGHT 2018
SEMRAU ENGINEERING & SURVEYING, PLLC
 CIVIL ENGINEERING • LAND SURVEYING • PLANNING
 2118 RIVERSIDE DRIVE - SUITE 208
 MOUNT VERNON, WA 98273
 360-424-9566


























NO.	DATE	REVISION	BY	REV.

PLAN AND PROFILE
STATION 90+00 TO 105+00

SCALES:
 HORIZONTAL : 1" = 50'
 VERTICAL : 1" = 10'
 NOTE: IF THIS SHEET IS LESS THAN 22" x 34" THEN SHEET HAS BEEN REDUCED

GRIP ROAD GRAVEL MINE
ACCESS ROAD AS BUILT
 SEC. 27, 34, T. 36 N., SEC. 3, T. 35 N., R. 4 E., W.M.
 SKAGIT COUNTY, WASHINGTON

FIELD BK/PG: 311/34-79
 DATE: 9/04/18
 DRAWING: 5166PNP.DWG
 JOB NO.: 5166
 SHEET: 8

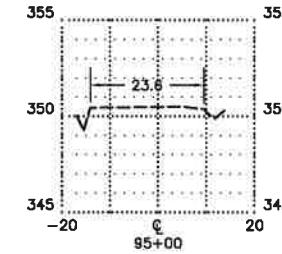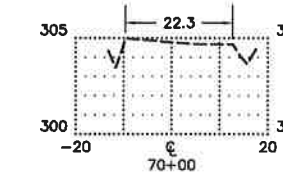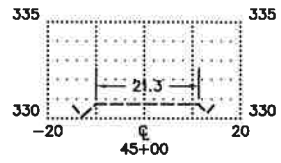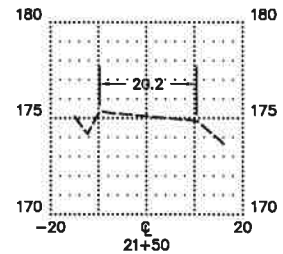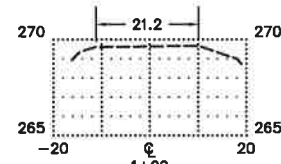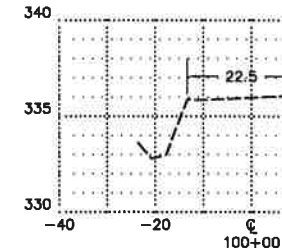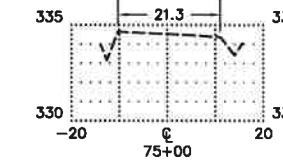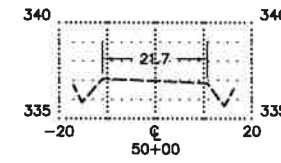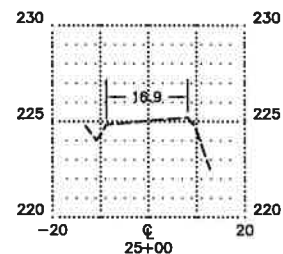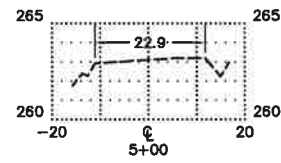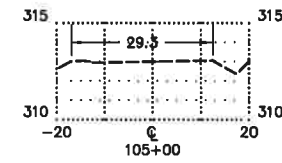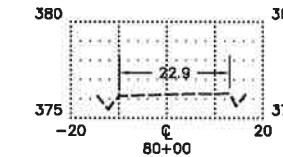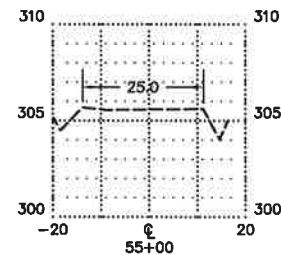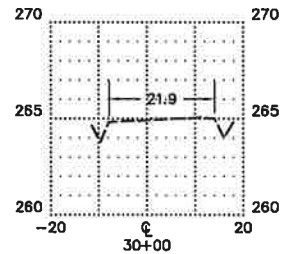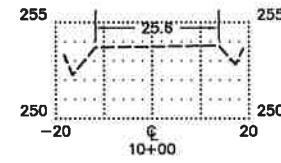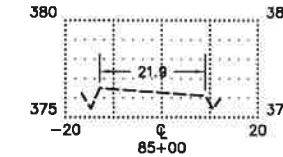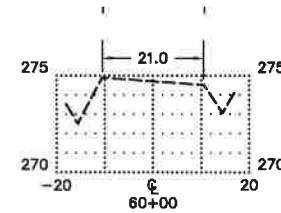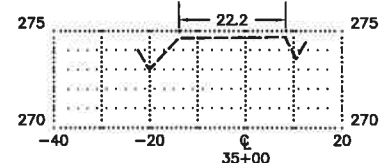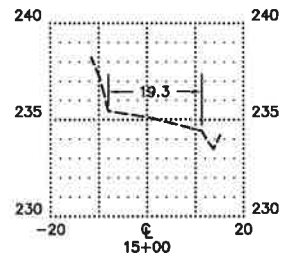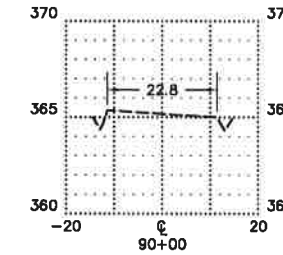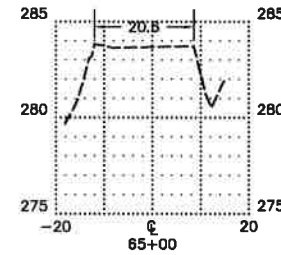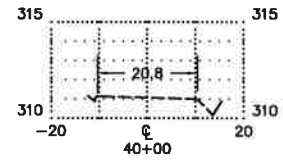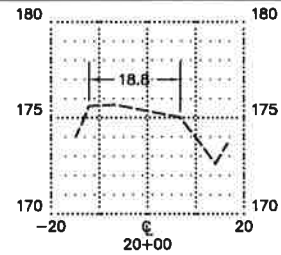

9-7-18



COPYRIGHT 2018
SEMRAU ENGINEERING & SURVEYING, PLLC
 CIVIL ENGINEERING • LAND SURVEYING • PLANNING
 2118 RIVERSIDE DRIVE - SUITE 208
 MOUNT VERNON, WA 98273
 360-424-9566

NO.	DATE	REVISION	BY	REV.


CROSS SECTIONS

SCALES:
 HORIZONTAL: 1" = 20'
 VERTICAL: 1" = 5'
 NOTE: IF THIS SHEET IS LESS THAN 22" x 34" THEN SHEET HAS BEEN REDUCED

**GRIP ROAD GRAVEL MINE
 ACCESS ROAD AS BUILT**
 SEC. 27, 34, T. 36 N., SEC. 3, T. 35 N., R. 4 E., W.M.
 SKAGIT COUNTY, WASHINGTON

FIELD BK/PG: 311/34-79
 DATE: 9/04/18
 DRAWING: 5166PNP.DWG
 JOB NO.: 5166
 SHEET: 9



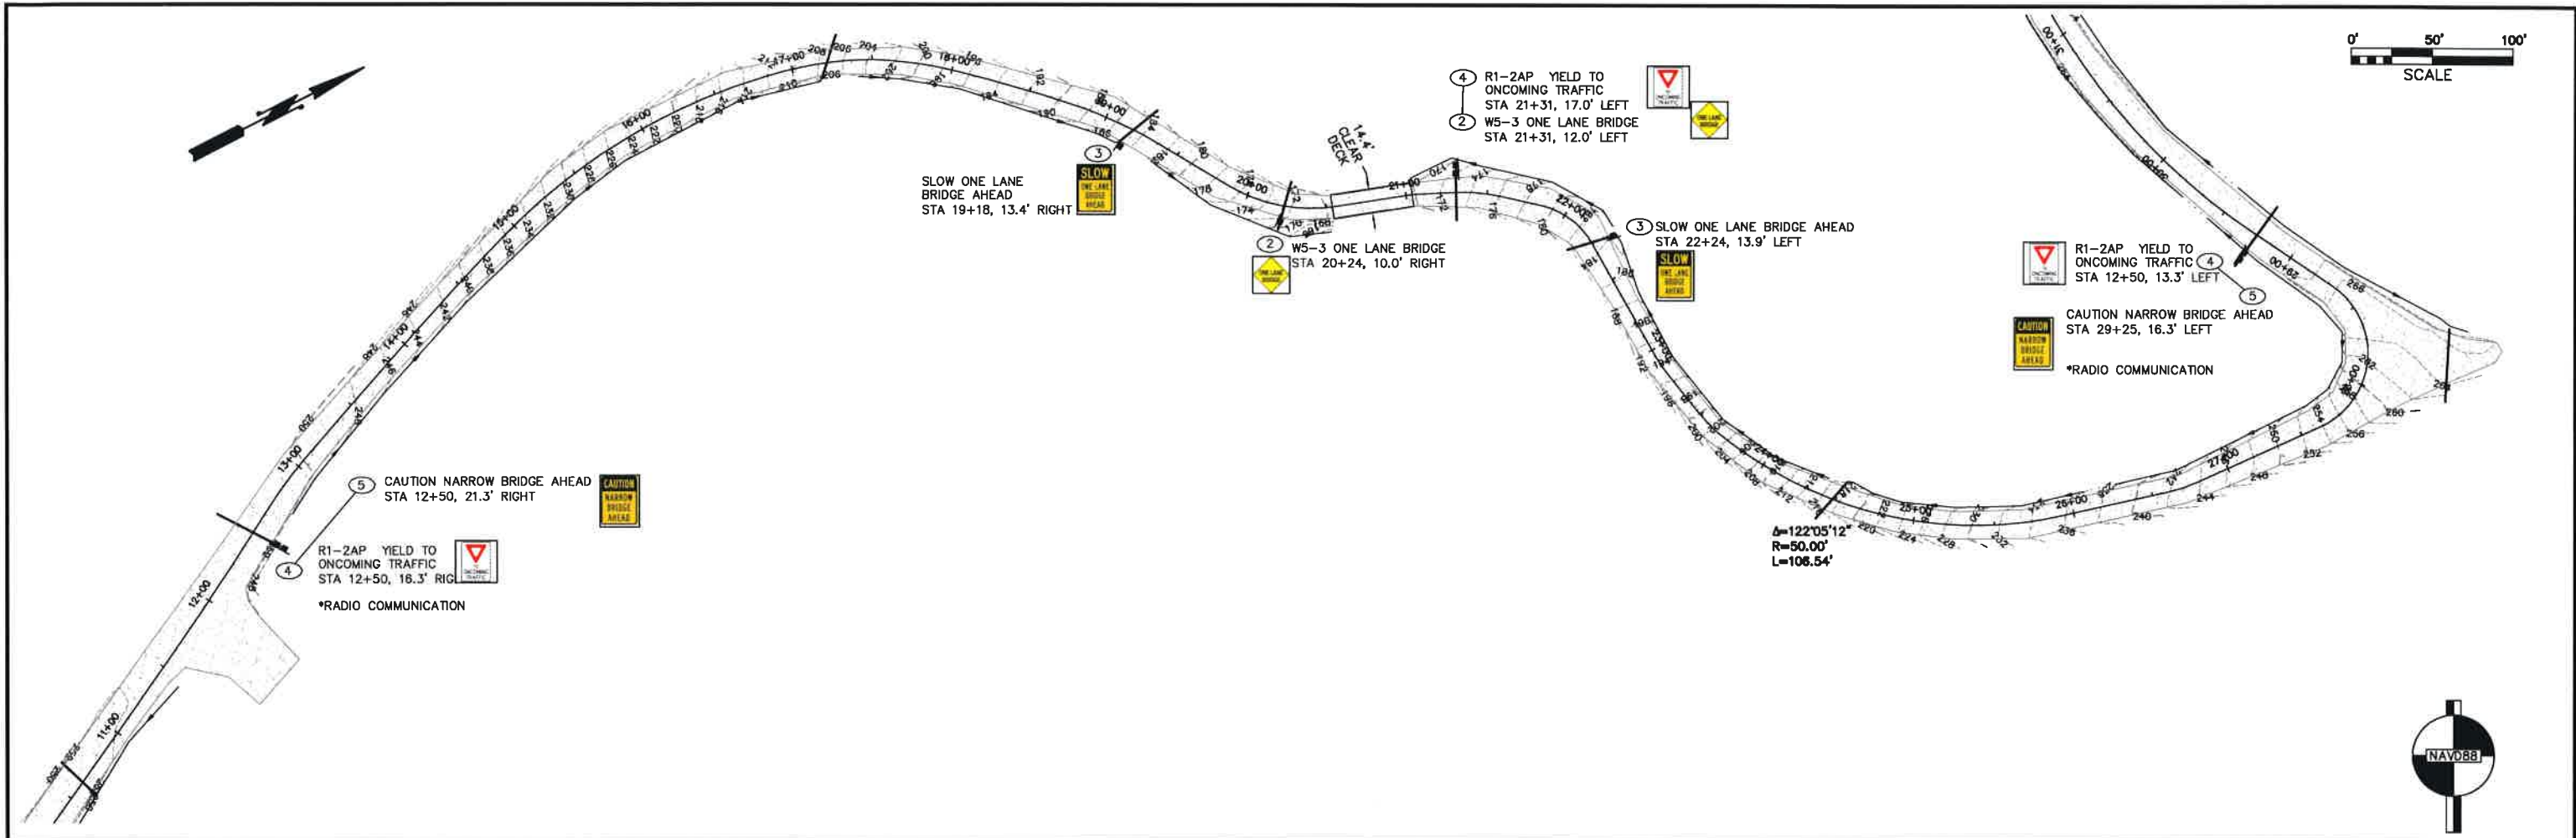

SIGN LEGEND



COPYRIGHT 2018
SEMRAU ENGINEERING & SURVEYING, PLLC
 CIVIL ENGINEERING • LAND SURVEYING • PLANNING
 2118 RIVERSIDE DRIVE - SUITE 208
 MOUNT VERNON, WA 98273
 360-424-9566



NO.	DATE	REVISION	BY	REV.

SIGNAGE PLAN
STATION 15+00 TO 30+00

SCALES:
 HORIZONTAL: 1" = 50'
 VERTICAL: 1" = 10'
 NOTE: IF THIS SHEET IS LESS THAN 22" x 34" THEN SHEET HAS BEEN REDUCED

GRIP ROAD GRAVEL MINE
ACCESS ROAD AS BUILT
 SEC. 27, 34, T. 36 N., SEC. 3, T. 35 N., R. 4 E., W.M.
 SKAGIT COUNTY, WASHINGTON

FIELD BK/PG: 311/34-79
 DATE: 9/13/18
 DRAWING: 5186PNP.DWG
 JOB NO.: 5186
 SHEET: 10