




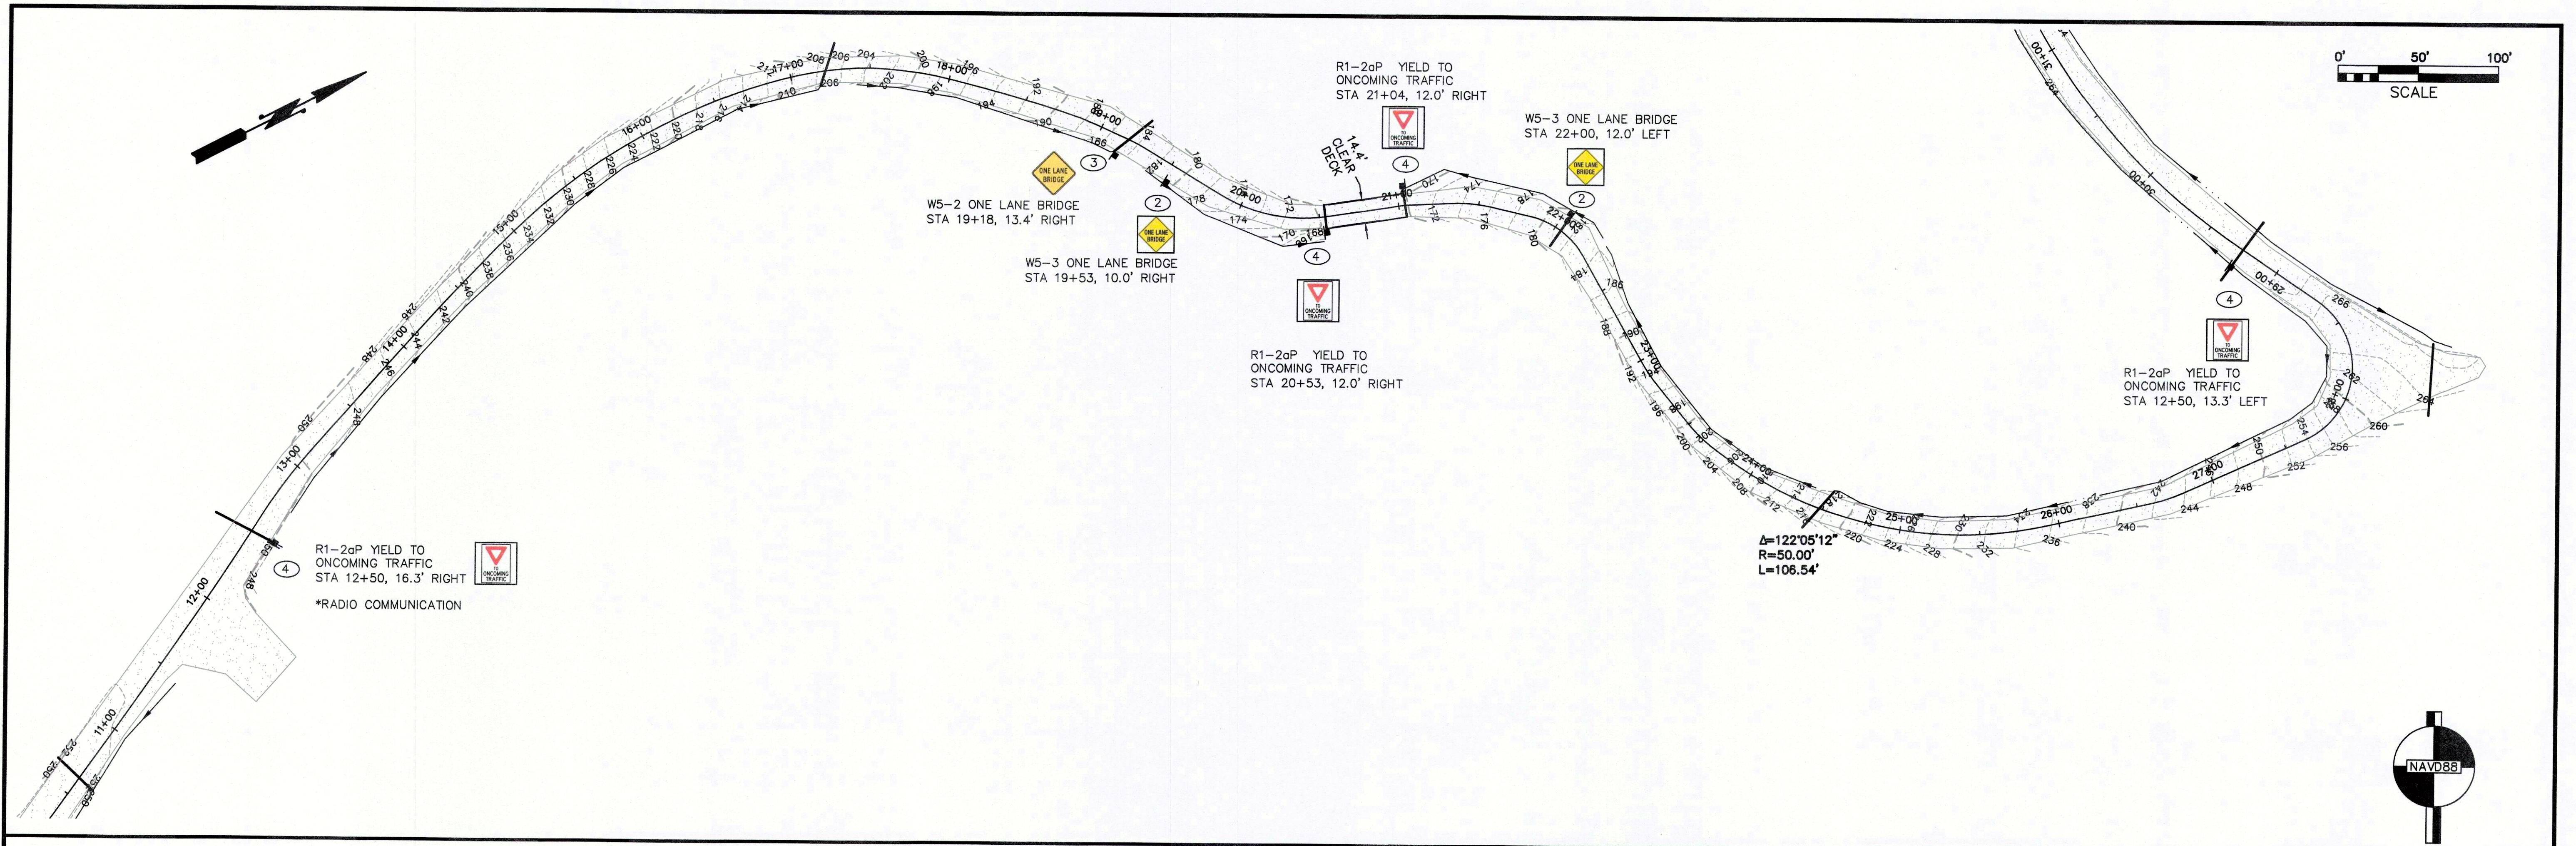


SIGN LEGEND

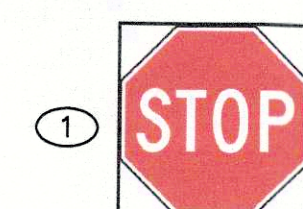


R1-1 STOP
30" X 30"

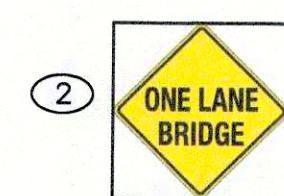

W5-3 ONE LANE BRIDGE
36" X 36"

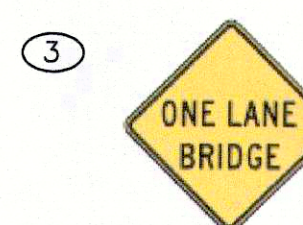


W5-2 ONE LANE BRIDGE
36" X 36"

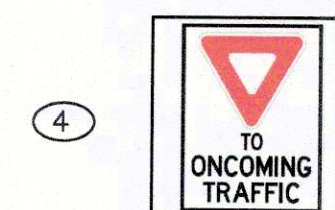

R1-2aP YIELD TO
ONCOMING TRAFFIC

COPYRIGHT 2018
SEMAU ENGINEERING & SURVEYING, PLLC
CIVIL ENGINEERING • LAND SURVEYING • PLANNING
2118 RIVERSIDE DRIVE - SUITE 208
MOUNT VERNON, WA 98273
360-424-9566

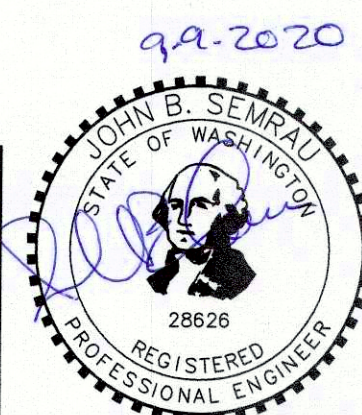

NO.	DATE	REVISION	BY	REV.

SIGNAGE PLAN STATION 15+00 TO 30+00

SCALES:
HORIZONTAL : 1" = 50'
VERTICAL : 1" = 10'

NOTE: IF THIS SHEET IS LESS
THAN 22"x 34" THEN SHEET
HAS BEEN REDUCED

**GRIP ROAD GRAVEL MINE
ACCESS ROAD AS BUILT**
SEC. 27, 34, T. 36 N., SEC. 3, T. 35 N., R. 4 E., W.M.
SKAGIT COUNTY, WASHINGTON

FIELD BK/PG: 311/34-79
DATE: 9/13/18
DRAWING: 5166PNP.DWG
JOB NO.: 5166
SHEET: 10